



PLOT PLAN

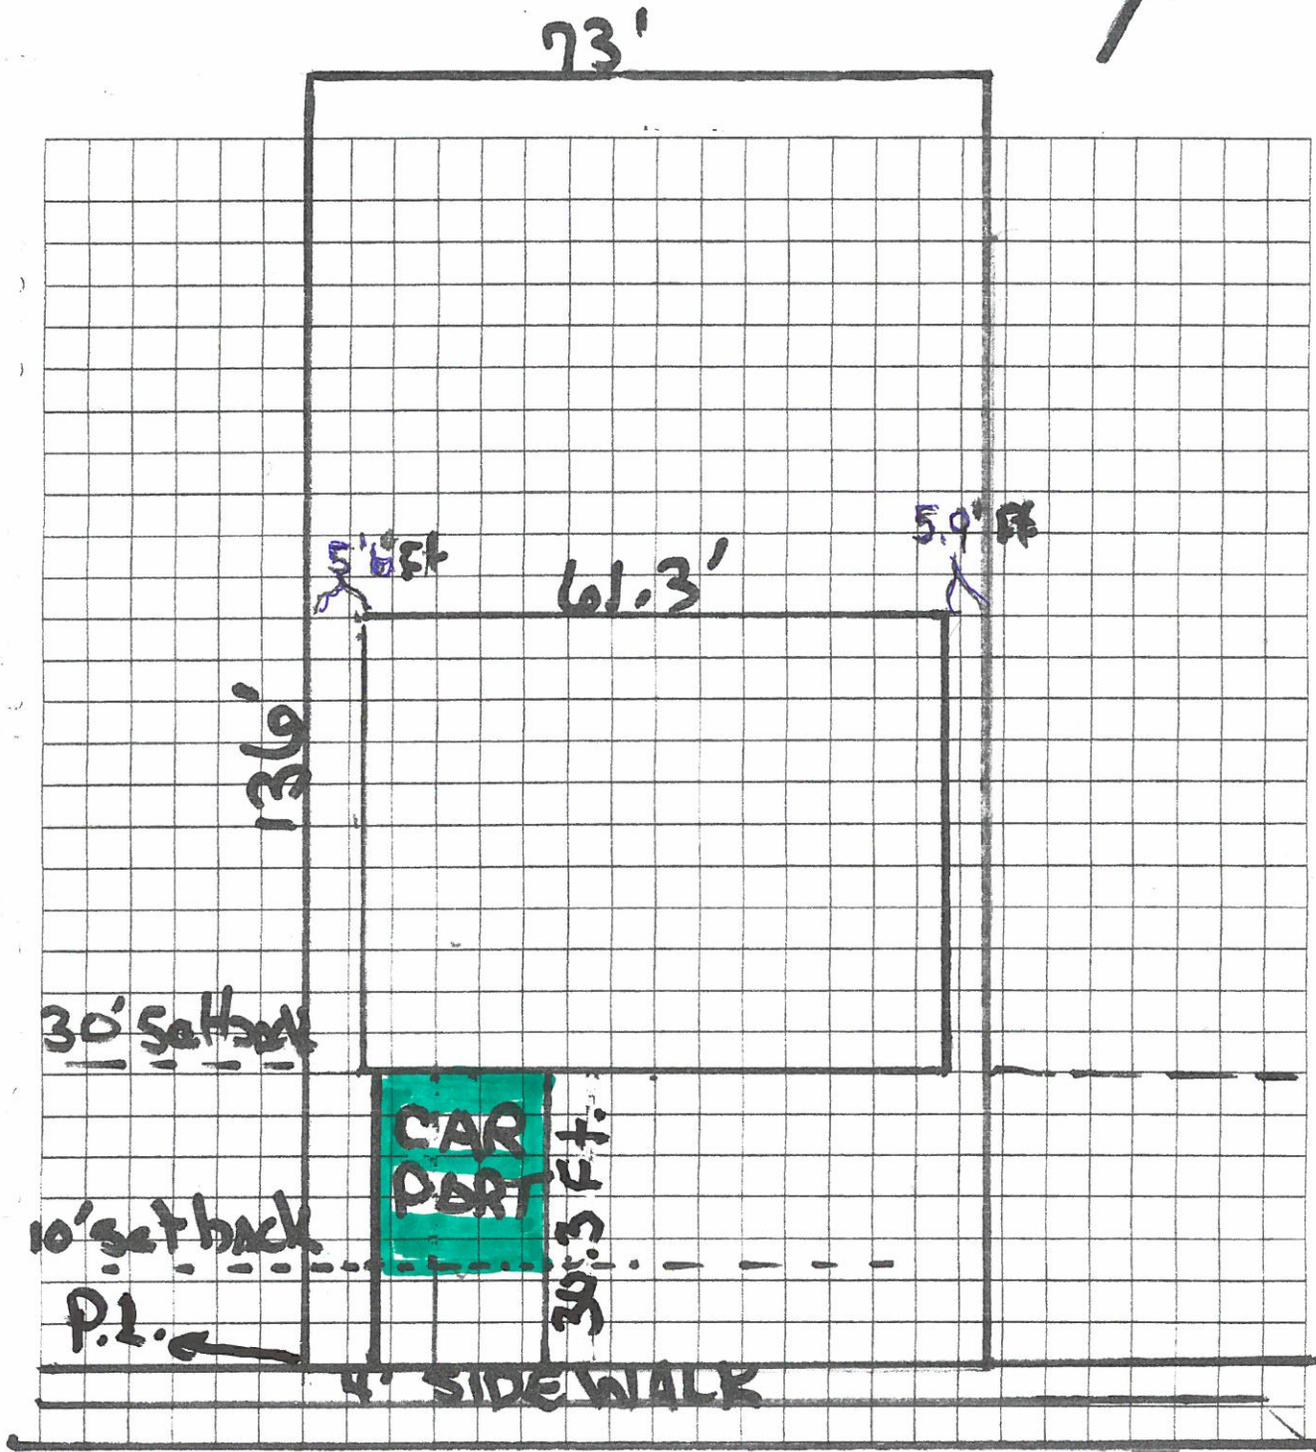

3119 Satellite DR.

P.L. PROPERTY LINE

1" = 20 feet

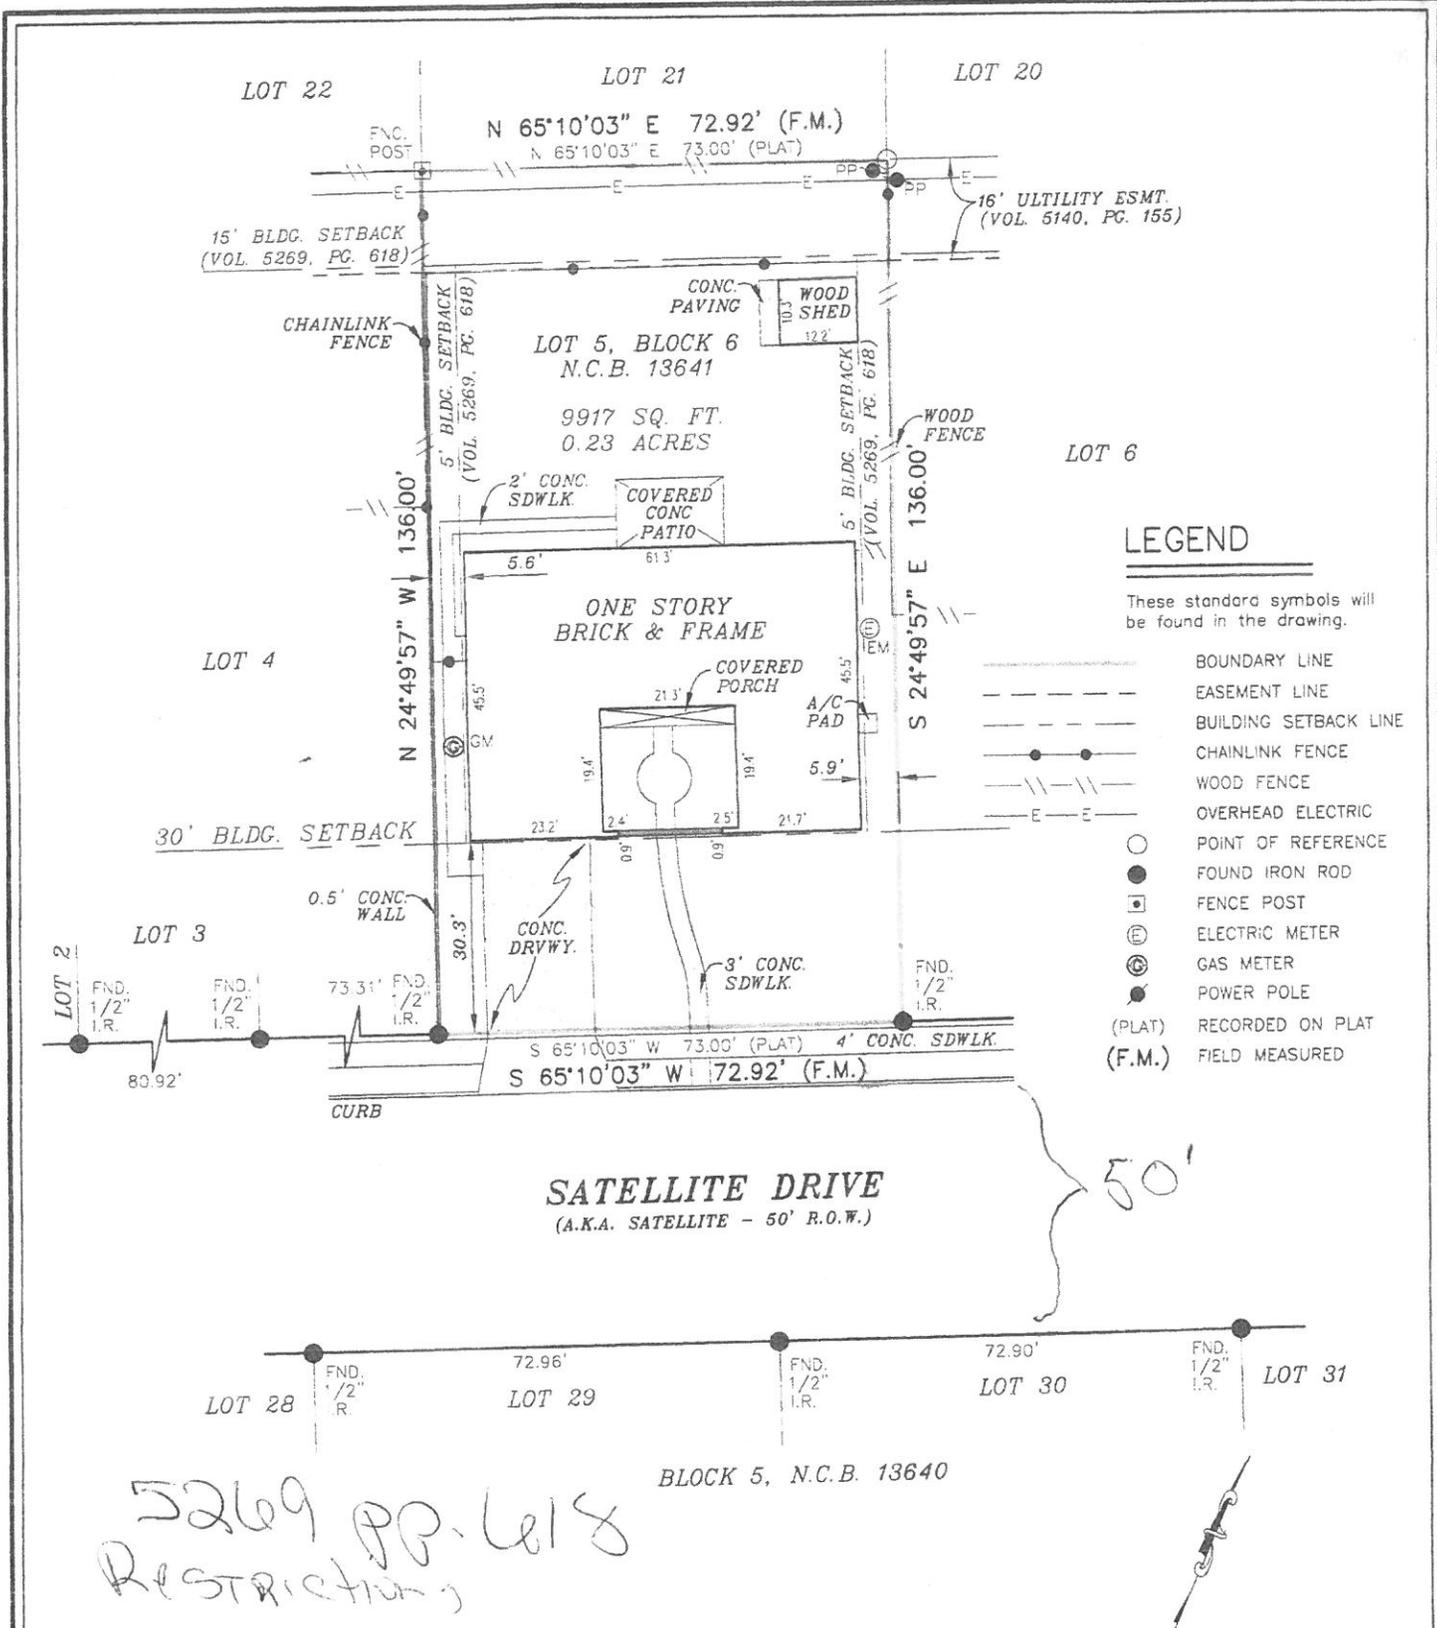

LEGEND

- These standard symbols will be found in the drawing.
- BOUNDARY LINE
 - - - - EASEMENT LINE
 - BUILDING SETBACK LINE
 - CHAINLINK FENCE
 - WOOD FENCE
 - OVERHEAD ELECTRIC
 - POINT OF REFERENCE
 - FOUND IRON ROD
 - FENCE POST
 - ⊕ ELECTRIC METER
 - ⊙ GAS METER
 - POWER POLE
 - (PLAT) RECORDED ON PLAT
 - (F.M.) FIELD MEASURED


5269 pp. 618
Restrictions

SURVEYOR'S NOTE:
BASIS OF BEARING, RECORDED
PLAT UNLESS OTHERWISE NOTED.

At date of this survey, the property is in FEMA designated ZONE X as verified by FEMA map Panel No: 48029C 0265 G, effective date of SEPTEMBER 29, 2010. Exact designations can only be determined by a Elevation Certificate. This information is subject to change as a result of future FEMA map revisions and/or amendments.

The survey is hereby accepted with the discrepancies, conflicts, or shortages in area or boundary lines, encroachments, protrusions, or overlapping of improvements shown.

GRAPHIC SCALE

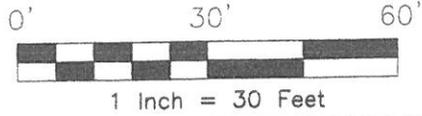

I, ROY JOHN RONNFELDT, a Registered Professional Land Surveyor in the State of Texas, do hereby certify to STEWART TITLE GUARANTY COMPANY

FINAL "AS-BUILT" SURVEY

JOB NO.:	1407021950	NO.	REVISION	DATE
DATE:	07/09/14			
DRAWN BY:	MN/DA/GC			