




SCALE: 3/16"=1'-0"

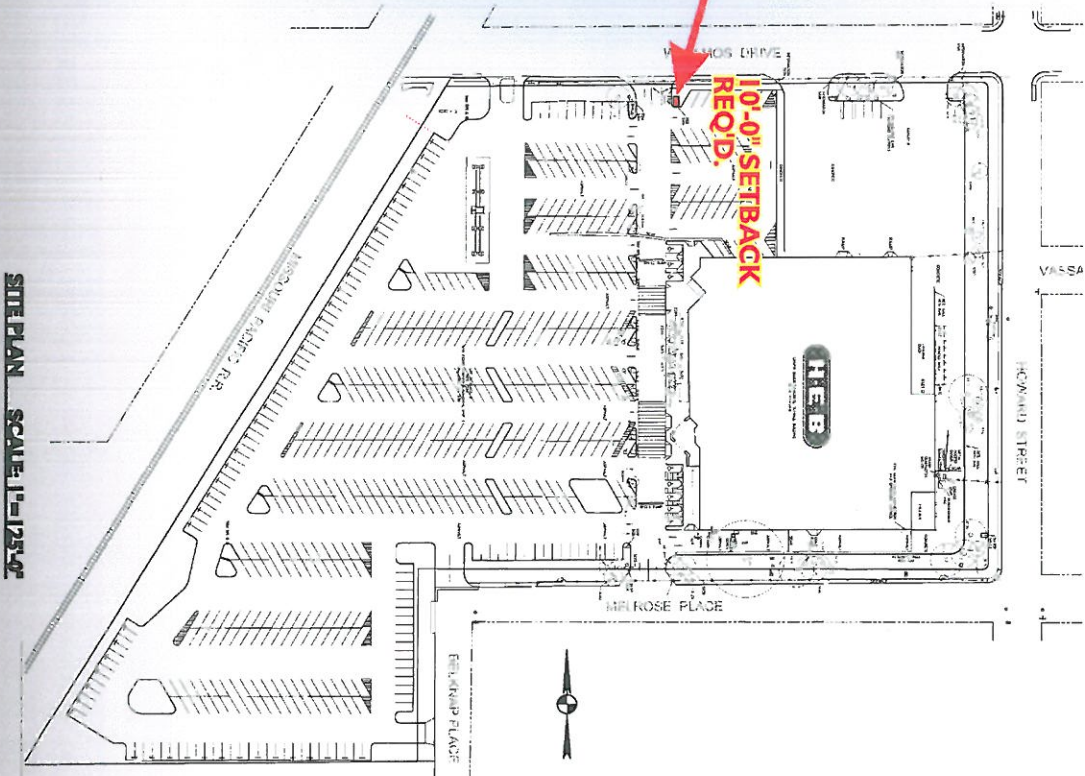

SITE PLAN SCALE: 1"=125'-0"



☐ Approved
☐ Approved As Noted
☐ Revise & Resubmit
 By: _____
 Date: _____

Client: HEB
 Location: 300 OLMOS DR.
 SAN ANTONIO, TX 78212
 Salesperson: Pete Stierle
 Ppl. Mgr.: Tammy Colson
 Date: 8/7/2014
 Designer: David Garnez
 File Name: 22204_HEB
 Olmos Site Signage RS 22204
 Job #:

Revisions

R1P-14-400C Color changes
 R2125-51-400C New concept
 R2125-51-400C New concept based on architectural submittal
 R50-12-1500C Revised per field input



License #: 18010

San Antonio
 2501 N. Loop W. Suite 100
 San Antonio, TX 78218
 Ph: (214) 341-7244

Tolson / P. Worth Branch
 13306 N. Loop W. Suite 100
 Houston, TX 77040
 Ph: (281) 870-1894

Houston Branch
 28016 Greenhouse Rd.
 Houston, TX 77055
 Ph: (281) 482-8881

2457 E. Loop A, Bldg. 1B
 Houston, TX 77022
 Ph: (281) 972-5800

THIS DRAWING IS THE EXCLUSIVE PROPERTY OF COMET SIGNS. NO REPRODUCTION OR TRANSMISSION OF THIS DRAWING IN ANY FORM OR BY ANY MEANS, ELECTRONIC OR MECHANICAL, INCLUDING PHOTOCOPYING, RECORDING, OR BY ANY INFORMATION STORAGE AND RETRIEVAL SYSTEM, WITHOUT THE WRITTEN PERMISSION OF COMET SIGNS IS FORBIDDEN. VIOLATION WILL BE PROSECUTED TO THE FULL EXTENT OF THE LAW.