
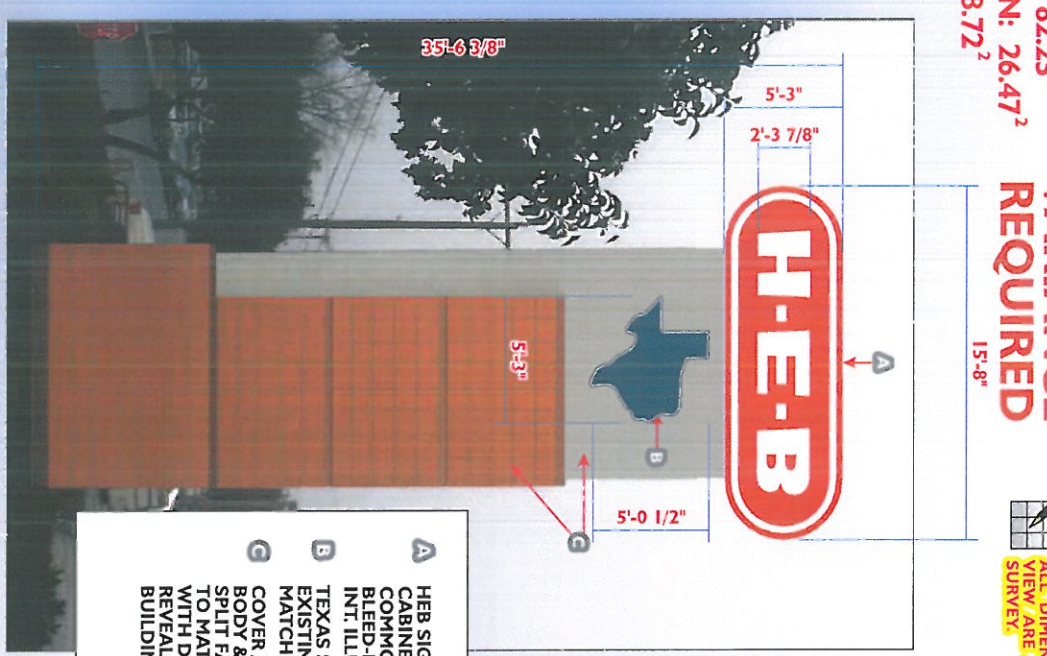


VARIANCE REQUIRED

ALL DIMENSIONS SHOWN ON END VIEW / ARE APPROXIMATE. NEED FIELD SURVEY.

HEB SIGN: 82.25'
TEXAS SIGN: 26.47'
TOTAL: 108.72'

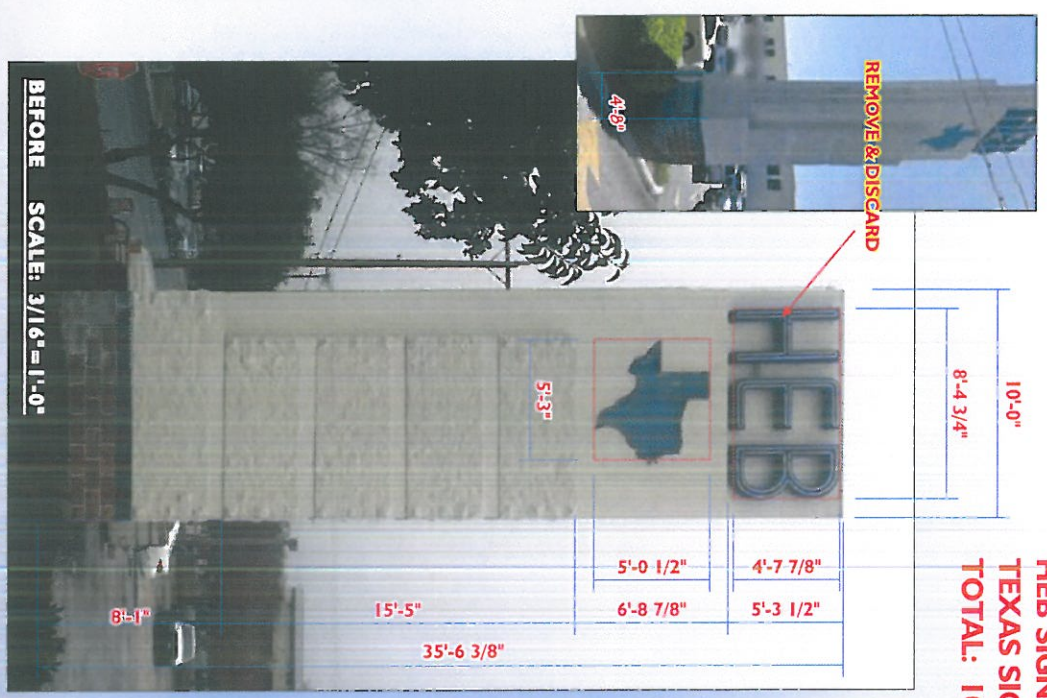

END VIEW

SCALE: 3/16"=1'-0"

ELECTRICAL REQUIREMENTS

ITEM	QUANTITY	UNIT	PRICE
HEB SIGN	1	Sq. Ft.	2100
TEXAS SIGN	1	Sq. Ft.	750

- A** HEB SIGN: (2) S/F ALUM. CABINETS WITH ALUM. COMMON FILTERS. BLEED-FACE FLEX FACES; INT. ILLUM. BY H/O LAMPS.
- B** TEXAS SIGN: REPAINT EXISTING SIGN; NEW MATCHING NEON.
- C** COVER / BASE: REPAINTED BODY & COVER EXISTING SPLIT FACE BLOCK AREAS, TO MATCH BUILDING, WITH D'HANNIS TILE - REVEALS TO MATCH BUILDING - BY OTHERS.

- PMS # 485C
- TO BE DETERMINED
- WHITE
- NEON COLOR: TO BE DETERMINED

NEW S/F CABINETS (OVAL) / REFURNISHED "TEXAS" SCALE: 3/16"=1'-0"

(1) S/F CABINETS REQUIRED FOR D/F CONFIGURATION
(2) TEXAS REFURNISHED SIGNS REQUIRED FOR D/F CONFIGURATION



- ☐ Approved
 - ☐ Approved As Noted
 - ☐ Revise & Resubmit
- By: _____
Date: _____

Client: HEB
Location: 300 OLMOS DR.
SAN ANTONIO, TX 78212
Salesperson: Pete Sierle
Prl. Mgr.: Tammy Colson
Date: 8/7/2014
Designer: David Garnez
File Name: 22204_HEB
Olmos Site Signage RS 22204
Job #:

Revisions

8/16/14DC Color changes
8/17/14DC New concept
8/20/14DC New concept based on architectural submitted
8/20/14DC New concept based on architectural submitted
8/20/14DC Revised per field survey



License #: 18010
Corporate Office
2500 N. Loop West
San Antonio, TX 78218
Ph: (214) 341-7844
Dallas / Ft. Worth Branch
13306 Irving Blvd. Suite 100
Ph: (972) 870-1894
Houston Branch
2806 Greenhouse Rd.
Ph: (281) 482-6581
Austin Branch
2457 S. Loop A, Bldg. 1B
Ph: (512) 572-5500

THIS DRAWING IS THE EXCLUSIVE PROPERTY OF CREST SIGNS. NO REPRODUCTION OR USE OF THIS DRAWING OR ANY PART THEREOF IS PERMITTED WITHOUT THE WRITTEN CONSENT OF CREST SIGNS. CREST SIGNS IS A REGISTERED TRADEMARK OF CREST SIGNS. ALL RIGHTS RESERVED.