

## HISTORIC AND DESIGN REVIEW COMMISSION

January 18, 2017

Agenda Item No: 20

**HDRC CASE NO:** 2016-533  
**ADDRESS:** 608 DAWSON ST  
610 DAWSON ST  
**LEGAL DESCRIPTION:** NCB 569 (DAWSON PLACE), BLOCK 17 LOT 19  
NCB 569 (DAWSON PLACE), BLOCK 17 LOT 20  
**ZONING:** R-3,H  
**CITY COUNCIL DIST.:** 2  
**DISTRICT:** Dignowity Hill Historic District  
**APPLICANT:** Carlos Rodriguez/Brightstar Development, LLC  
**OWNER:** Brightstar Development, LLC  
**TYPE OF WORK:** Revisions to previously approval for new construction  
**REQUEST:**

The applicant is requesting an amendment to a pervious Certificate of Appropriateness issued by the Historic and Design Review Commission. The amendments include the following:

1. Install 14 on each building (28 total) aluminum clad one over one windows in lieu of 28 total previously approved wood 4 over 4 windows
2. Install 6 on each building (12 total) aluminum clad fixed square windows in lieu of 16 total previously approved wood fixed square windows
3. Install 2 on each building (4 total) aluminum clad fixed elongated windows in lieu of 4 total previously approved wood fixed elongated windows with one dividing light
4. Install 1 on each building (2 total) aluminum clad fixed windows in lieu of previously approved wood fixed windows with 2 x 3 dividing lights
5. Install hardiboard siding and trim in lieu of wood siding and trim
6. Alter fenestration and remove previously approved windows including one front window with 2 x 6 dividing lights on each building (2 total) and one side square fixed window on the side elevation of each building (2 total)
7. Install a front door with small window light in lieu of 2 total previously approved wood French door with 2 x 3 dividing lights
8. Install a rear door with small window light in lieu of 2 total previously approved wood paneled rear doors

### APPLICABLE CITATIONS:

*Historic Design Guidelines, Chapter 4, Guidelines for New Construction*

#### 2. Building Massing and Form

##### C. RELATIONSHIP OF SOLIDS TO VOIDS

i. *Window and door openings*—Incorporate window and door openings with a similar proportion of wall to window space as typical with nearby historic facades. Windows, doors, porches, entryways, dormers, bays, and pediments shall be considered similar if they are no larger than 25% in size and vary no more than 10% in height to width ratio from adjacent historic facades.

ii. *Façade configuration*— The primary façade of new commercial buildings should be in keeping with established patterns. Maintaining horizontal elements within adjacent cap, middle, and base precedents will establish a consistent street wall through the alignment of horizontal parts. Avoid blank walls, particularly on elevations visible from the street. No new façade should exceed 40 linear feet without being penetrated by windows, entryways, or other defined bays.

#### 3. Materials and Textures

##### A. NEW MATERIALS

i. *Complementary materials*—Use materials that complement the type, color, and texture of materials traditionally found in the district. Materials should not be so dissimilar as to distract from the historic interpretation of the district. For example, corrugated metal siding would not be appropriate for a new structure in a district comprised of homes with wood siding.

- ii. *Alternative use of traditional materials*—Consider using traditional materials, such as wood siding, in a new way to provide visual interest in new construction while still ensuring compatibility.
- v. *Imitation or synthetic materials*—Do not use vinyl siding, plastic, or corrugated metal sheeting. Contemporary materials not traditionally used in the district, such as brick or simulated stone veneer and Hardie Board or other fiberboard siding, may be appropriate for new construction in some locations as long as new materials are visually similar to the traditional material in dimension, finish, and texture. EIFS is not recommended as a substitute for actual stucco.

## **FINDINGS:**

- a. The project received final approval from the HDRC on May 4, 2016, to construct two 2-story units on a vacant lot and install fencing.
- b. The project received approval to install wood windows in various configurations and install wood siding and wood trim in the two units. During construction, aluminum clad one over one windows and hardiboard siding and trim were installed. The applicant received a stop work order as work was done outside the scope of the Certificate of Appropriateness.
- c. ITEM #1, 2, 3 - On May 4, 2016, staff cited the Guidelines for New Construction, which states windows used in new construction must maintain traditional dimensions and profiles and should be recessed within the window frame. A detail of the wood 4 over 4 windows and fixed windows and wall section was submitted to staff and staff found the details within the proposed elevation consistent with the Guidelines.
- d. ITEM #1, 2, 3 - The proposed windows are putty gray aluminum clad one over one, fixed square or fixed horizontal elongated windows. According to the Guidelines for Windows, windows in new construction should maintain traditional dimensions and profiles and be recessed within the window frame. Wood windows are most appropriate. Double-hung, block frame windows that feature alternative materials may be considered on a case-by-case basis. They should feature traditional trim and sill details. Paired windows should be separated by a wood mullion. Staff finds the proposed windows are consistent with the Guidelines in terms of profile as they are inset 1 5/6", however staff finds that the paired or trim and the color and texture is not similar to traditional materials. Staff finds that though alternative materials may be appropriate, staff finds that wood is most appropriate and what was approved on May 4, 2016 by the HDRC.
- e. ITEM #4 - On May 4, 2016, staff recommended approval and the HDRC approved 2 wood fixed windows with 2x 3 dividing lights on the front of each building. The proposed new windows are aluminum clad fixed with no dividing lights. According to the Guidelines for New Construction, windows used in new construction must maintain traditional dimensions and profiles and should be recessed within the window frame. Staff finds the long fixed windows without dividing lights not traditional and therefore not consistent with the Guidelines. Staff recommends the windows include dividing lights.
- f. SIDING/TRIM - On May 4, 2016, staff commented that both wood and hardiboard would be appropriate materials according to the Guidelines for New Construction 3.A.i. Wood siding was indicated on the plans submitted by the applicant and approved by the HDRC. The proposed siding is hardiboard siding and hardiboard trim. According to the Guidelines for New Construction 3.A.i., use materials that complement the type, color, and texture of materials traditional found in the district. Staff finds the proposed hardiboard appropriate for new construction and consistent with the Guidelines as it complements wood in color and texture.
- g. FENESTRATION ALTERATIONS - Previously there were two double hung windows on the left and two fixed square windows on the right side. The proposed fenestration has the windows switched on each building. The proposed windows to be removed include the front fixed window with 2 x 3 dividing lights of each building and one fixed square window from each building. According to Guidelines for New Construction 2.C.i., window and door openings should be of a similar proportion of wall to window space as typical with nearby historic facades. Staff finds the façades without the windows and with the fenestration alterations are similar to other historic structures in the district, and therefore consistent with the Guidelines.
- h. FRONT DOORS – On May 4, 2016, the HDRC approved two front doors with 2 x 3 dividing lights. The new proposed doors are doors with one small window light. According to the Guidelines for New Construction, door openings of new construction should feature a similar proportion and fenestration patterns to those of historic structures found throughout the district. Staff finds the proposed door with a single light appropriate for the character of the district, and consistent with the Guidelines.
- i. REAR DOORS - On May 4, 2016, the HDRC approved two solid rear doors with 3 panels. The new proposed doors are doors with one small window light. According to the Guidelines for New Construction, door openings of new construction should feature a similar proportion and fenestration patterns to those of historic structures

found throughout the district. Staff finds the proposed door with a single light appropriate for the character of the district, and consistent with the Guidelines.

**RECOMMENDATION:**

Staff recommends approval of items #1 through 7 based on findings a through i with the following stipulations:

1. That the paired windows be separated by a wood trim as noted in finding d.
2. That the all new windows be made of wood as noted in finding d.
3. That the 2 aluminum clad fixed windows include dividing lights as noted in finding e.

**CASE MANAGER:**

Lauren Sage

**CASE COMMENTS:**

HDRC: Final 5/4/16, Conceptual 3/16/16

The applicant received a stop work order as work was done outside the scope, and the applicant has provided the required application and the post-work application fee has been paid.



**610 Dawson**

**Dignowity Hill**

Printed: Mar 11, 2016

The City of San Antonio does not guarantee the accuracy, adequacy, completeness or usefulness of any information. The City does not warrant the completeness, timeliness, or positional, thematic, and attribute accuracy of the GIS data. The GIS data, cartographic products, and associated applications are not legal representations of the depicted data. Information shown on these maps is derived from public records that are constantly undergoing revision. Under no circumstances should GIS-derived products be used for final design purposes. The City provides this information on an "as is" basis without warranty of any kind, express or implied, including but not limited to warranties of merchantability or fitness for a particular purpose, and assumes no responsibility for anyone's use of the information.



DURANYORK  
HYDRAULIC

Brown St

610 Dawson St

N Mesquite St

Dawson St

Daws

cker Alley



berry

N Haakberry

N Haakberry

N

Dawson St

Dawson St

N Mesquite St

N Mesquite St

Brown St



610 Dawson St

DURANYORK  
HYDRAULIC...





170315

FORD

Dec 16, 2016, 12:43:29 PM



Dec 19, 2016, 1:11:16 PM





Dec 16, 2016, 12:43:50 PM




Dec 16, 2016, 12:44:07 PM




Dec 16 2016 12:47:00 PM


ELEVATIONS APPROVED BY HDRC // 16  
BUILDING 1 - 61 DAWSON

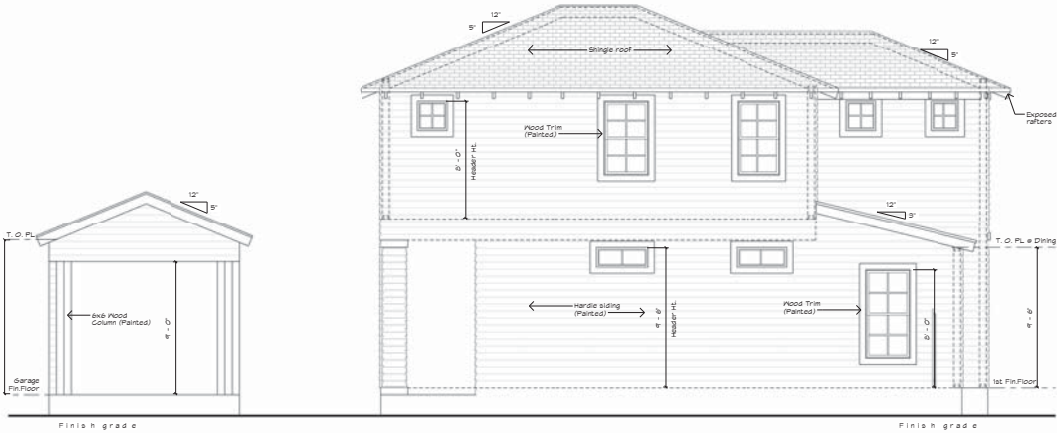


2 Building 1 Left Elevation  
1/4" = 1'-0"

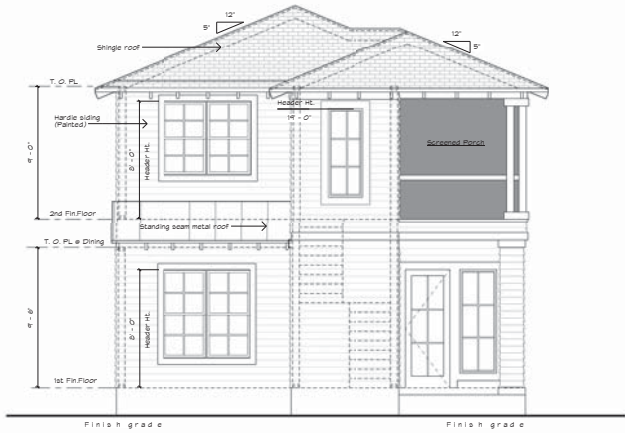

1 Building 1 Front elevation  
1/4" = 1'-0"

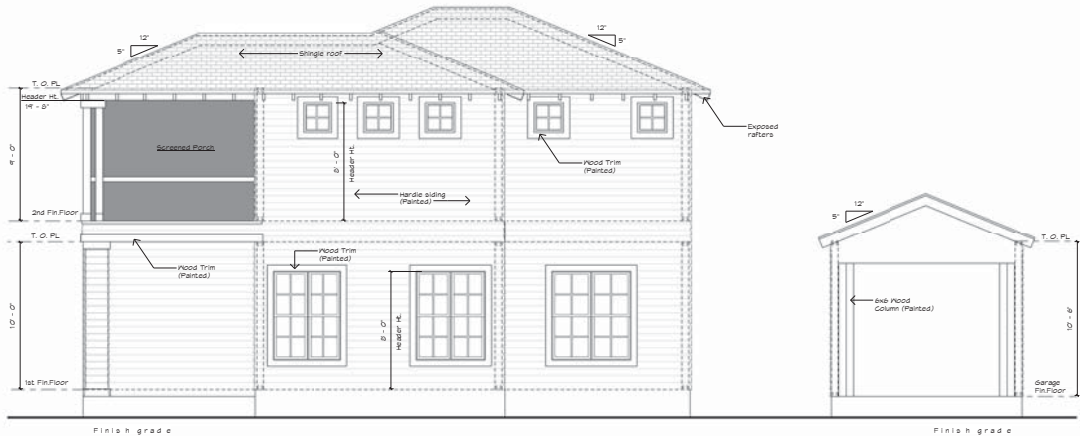

4 Building 1 Right Elevation  
1/4" = 1'-0"

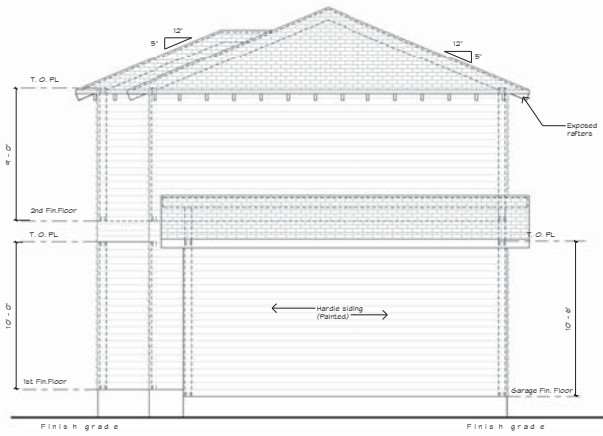

3 Building 1 Rear Elevation  
1/4" = 1'-0"

CARPORT



Legal Notice of Copyright:

1. THESE COPYRIGHTED PLANS AND RELATED DETAILS ARE DRAWN EXCLUSIVELY FOR THE USE OF VALDEZDESIGNS, INC.
2. THESE PLANS AND RELATED DETAILS ARE THE LEGAL PROPERTY OF VALDEZDESIGNS, INC. LOCATED IN SAN ANTONIO, TEXAS.
3. VALDEZDESIGNS, INC. HOLDS THE EXCLUSIVE RIGHT OF DISTRIBUTION.
4. THE DRAWINGS BEING REPRESENTED MAY NOT BE COPIED IN FULL OR IN PART WITHOUT PRIOR WRITTEN PERMISSION GRANTED BY VALDEZDESIGNS, INC.

BRIGHTSTAR  
DEVELOPMENT LLC.  
210.882.2058

DIGNOWITY HILL  
610 DAWSON ST.  
SAN ANTONIO TX  
LOT: 3  
COUNTY BLOCK: 17

Plan Information:  
Drawn By: JV RB  
Project #: 1110  
Copyright: 2016

Revisions:  
1  
2

Issue Date:  
04-07-2016

Sheet Title & No.  
EXTERIOR  
ELEVATIONS  
A4



ELEVATIONS APPROVED BY HDRC / 1/16  
BUILDING 2 - 6 DAWSON



Legal Notice of Copyright:

1. THESE COPYRIGHTED PLANS AND RELATED DETAILS ARE DRAWN EXCLUSIVELY FOR THE USE OF VALDEZDESIGNS, INC.
  2. THESE PLANS AND RELATED DETAILS ARE THE LEGAL PROPERTY OF VALDEZDESIGNS, INC. LOCATED IN SAN ANTONIO, TEXAS.
  3. VALDEZDESIGNS, INC. HOLDS THE EXCLUSIVE RIGHT OF DISTRIBUTION.
  4. THE DRAWINGS BEING REPRESENTED MAY NOT BE COPIED IN FULL OR IN PART WITHOUT PRIOR WRITTEN PERMISSION GRANTED BY VALDEZDESIGNS, INC.
- VALDEZDESIGNS, INC.  
SAN ANTONIO, TEXAS  
VOICE (210) 810-1234

BRIGHTSTAR  
DEVELOPMENT LLC.  
210.882.2038


DIGNOWITY HILL  
610 DAWSON ST.  
SAN ANTONIO TX  
LOT: 3  
COUNTY BLOCK: 17

Plan Information:  
Drawn By: JV RB  
Project #: 1110  
Copyright: 2016


Revisions:  
1  
2

Issue Date:  
04-07-2016


Sheet Title & No.  
EXTERIOR  
ELEVATIONS  
A6

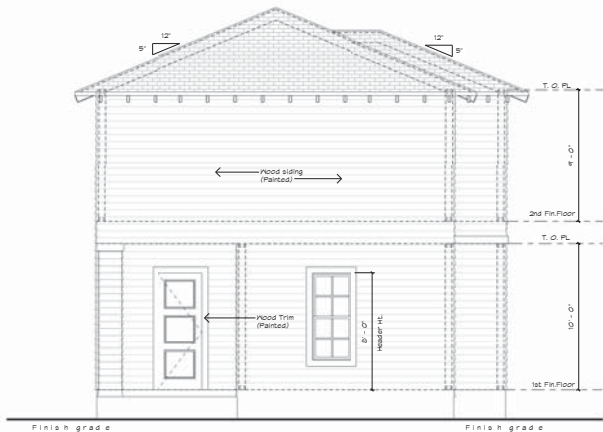


2 Building 2 Left Elevation  
1/4" = 1'-0"

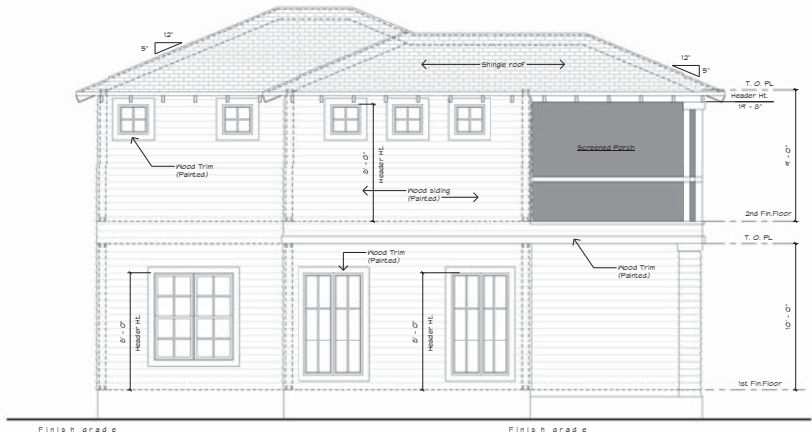

1 Building 2 Front Elevation  
1/4" = 1'-0"

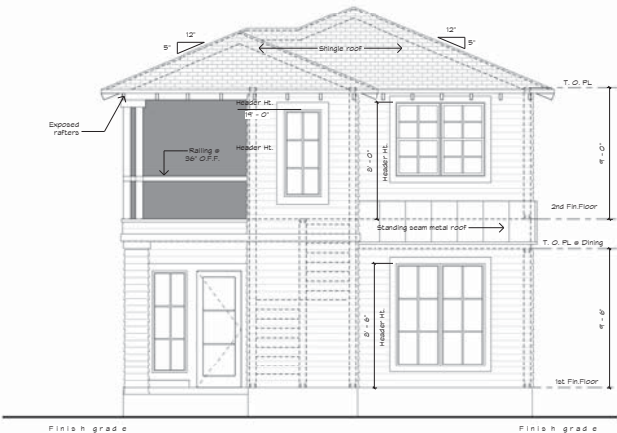


4 Building 2 Right Elevation  
1/4" = 1'-0"

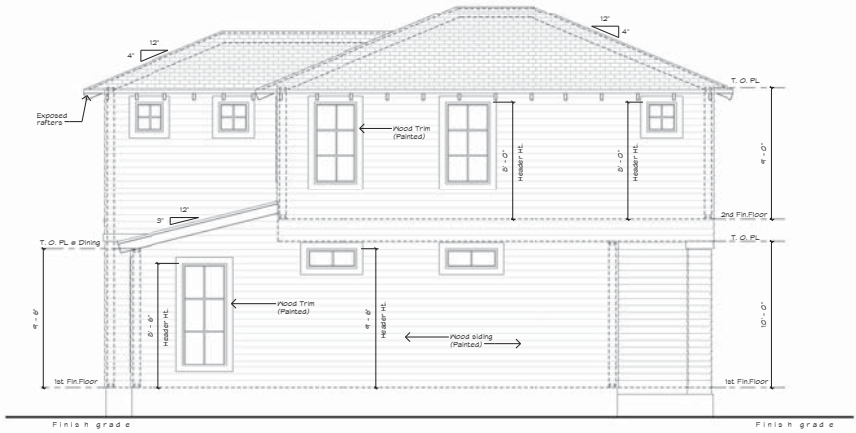





3 Building 2 Rear Elevation  
1/4" = 1'-0"




(AS-BUILT/GIO)

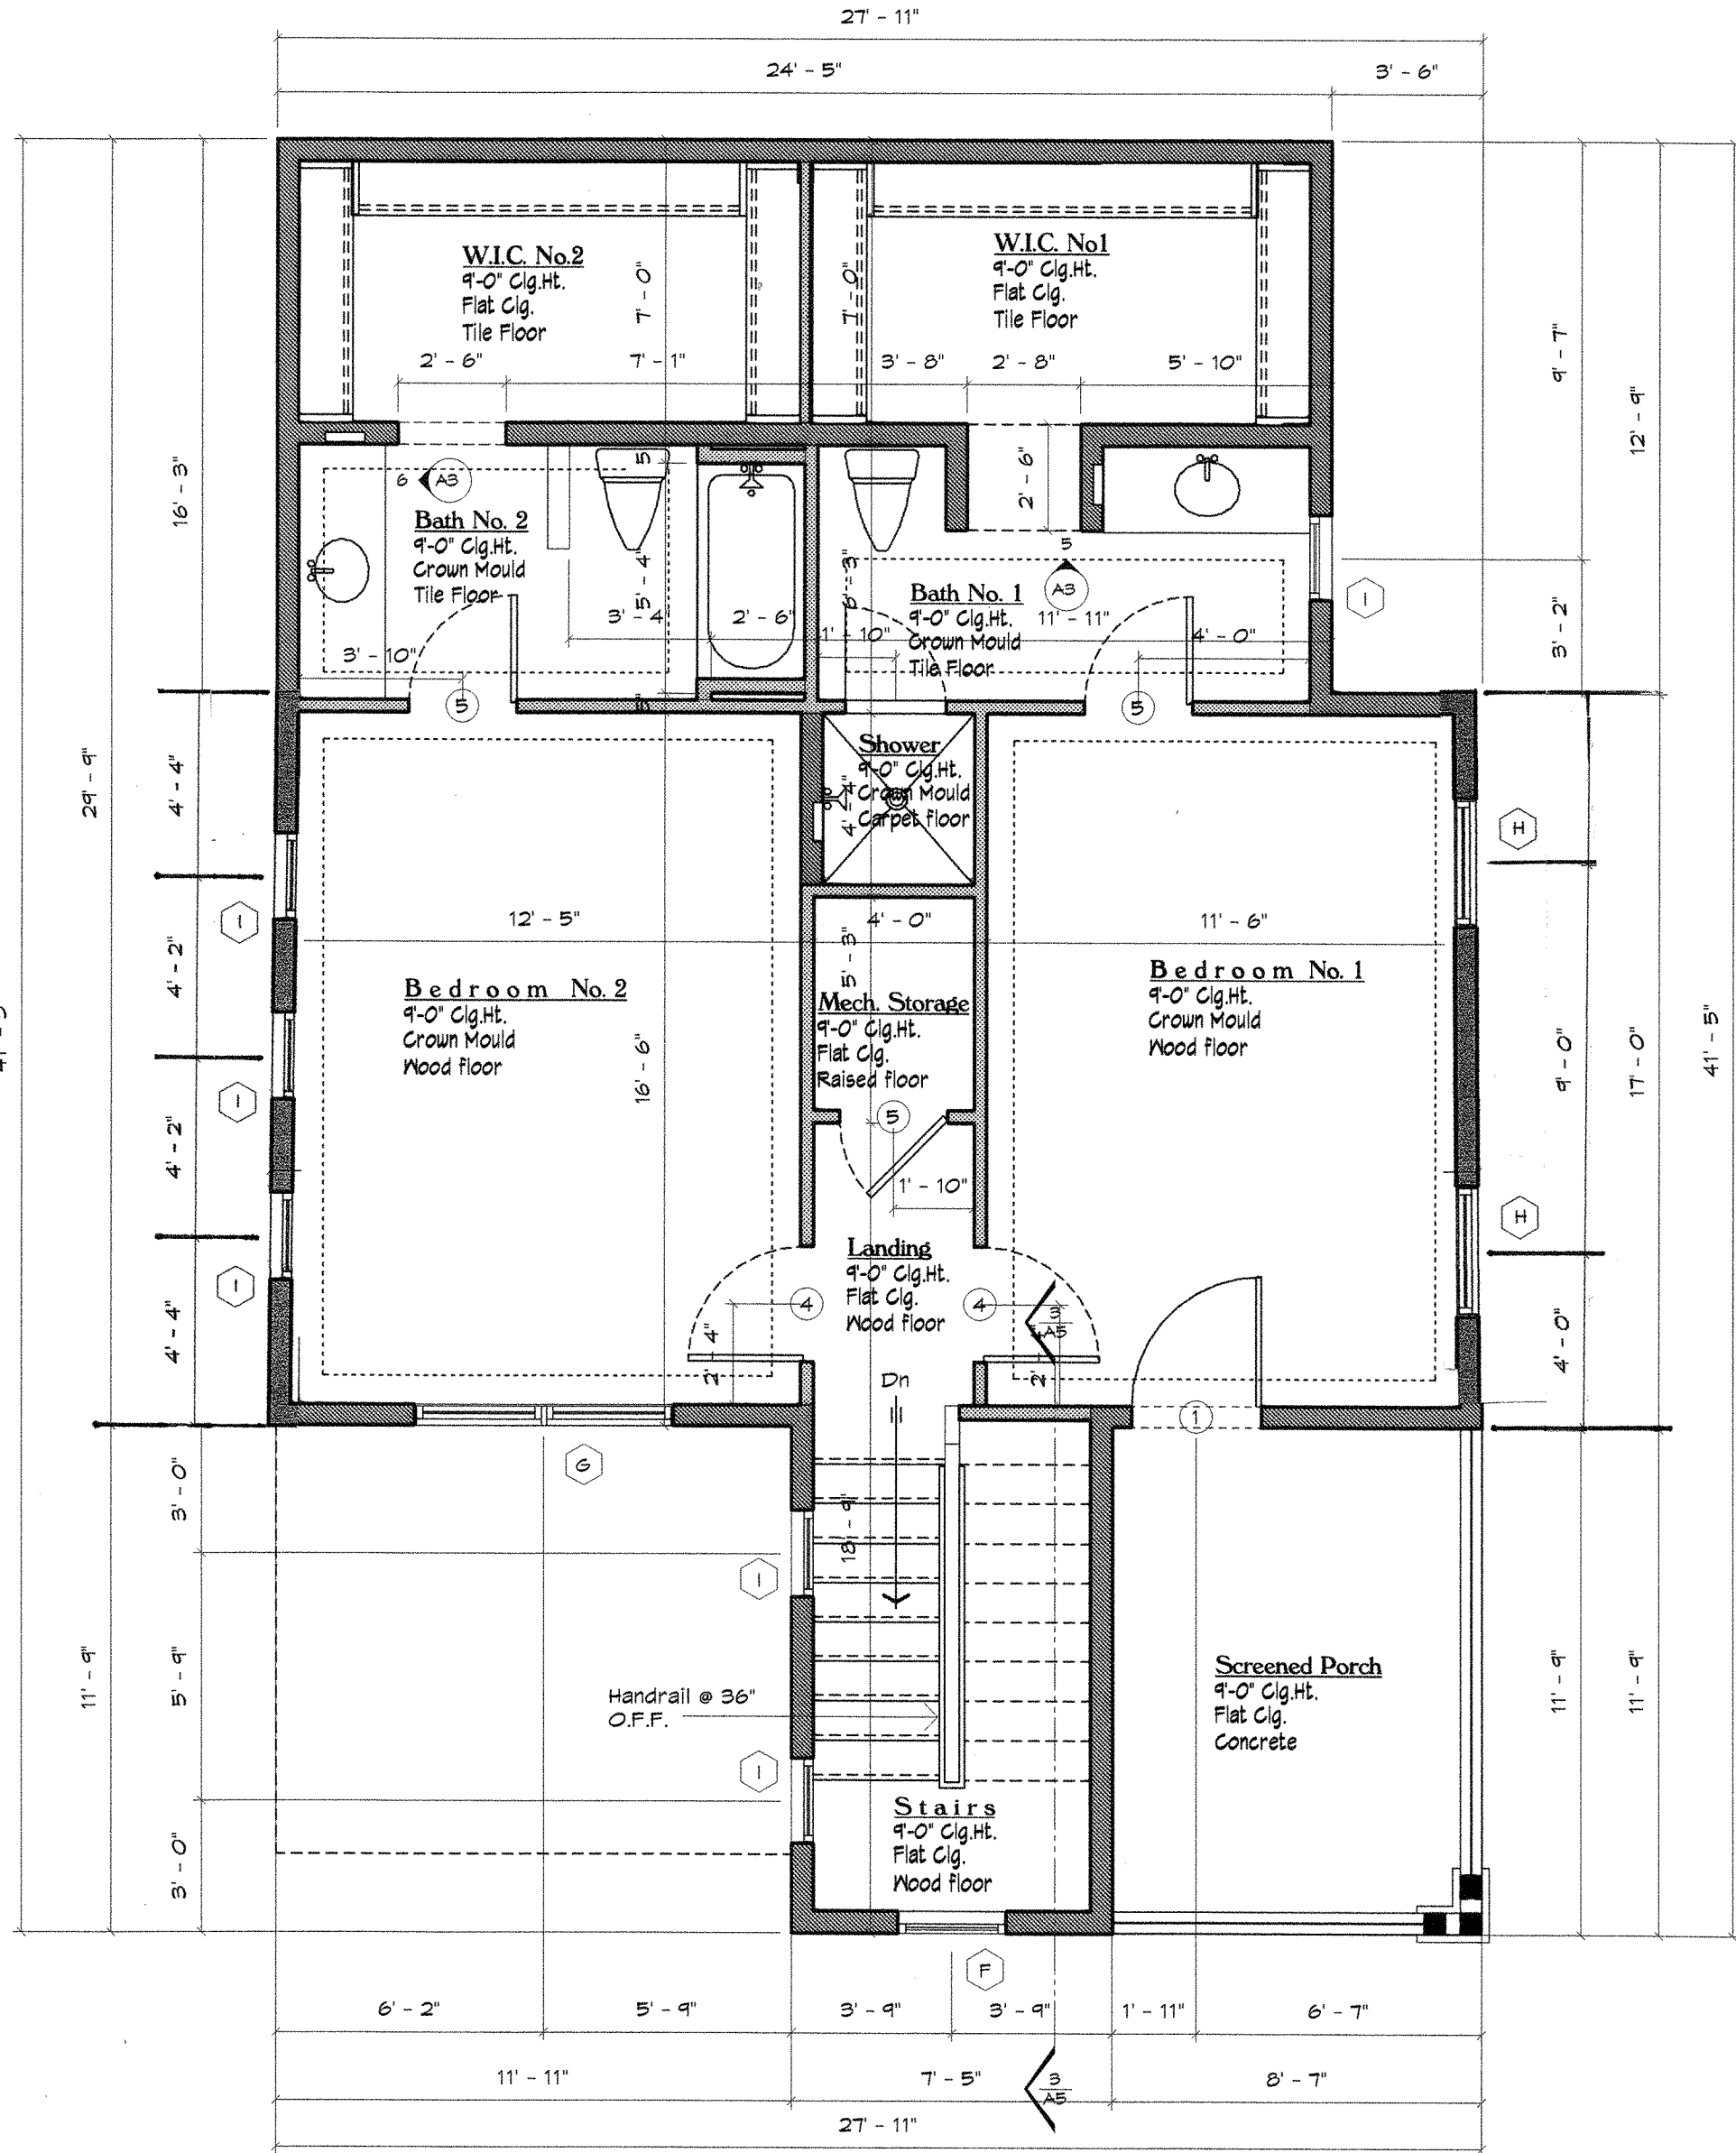


2 Second Floor Notes Plan  
1/4" = 1'-0"

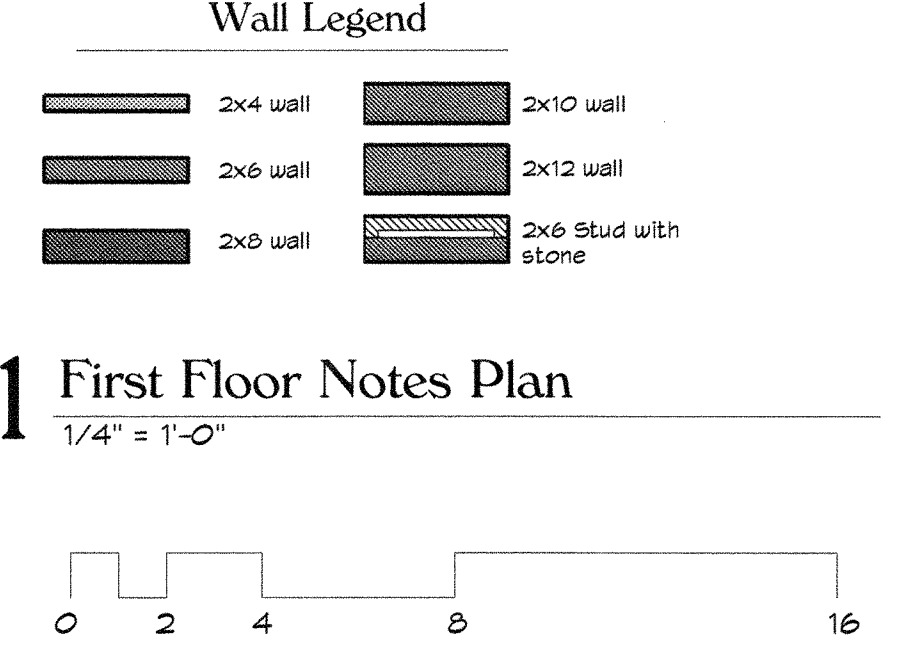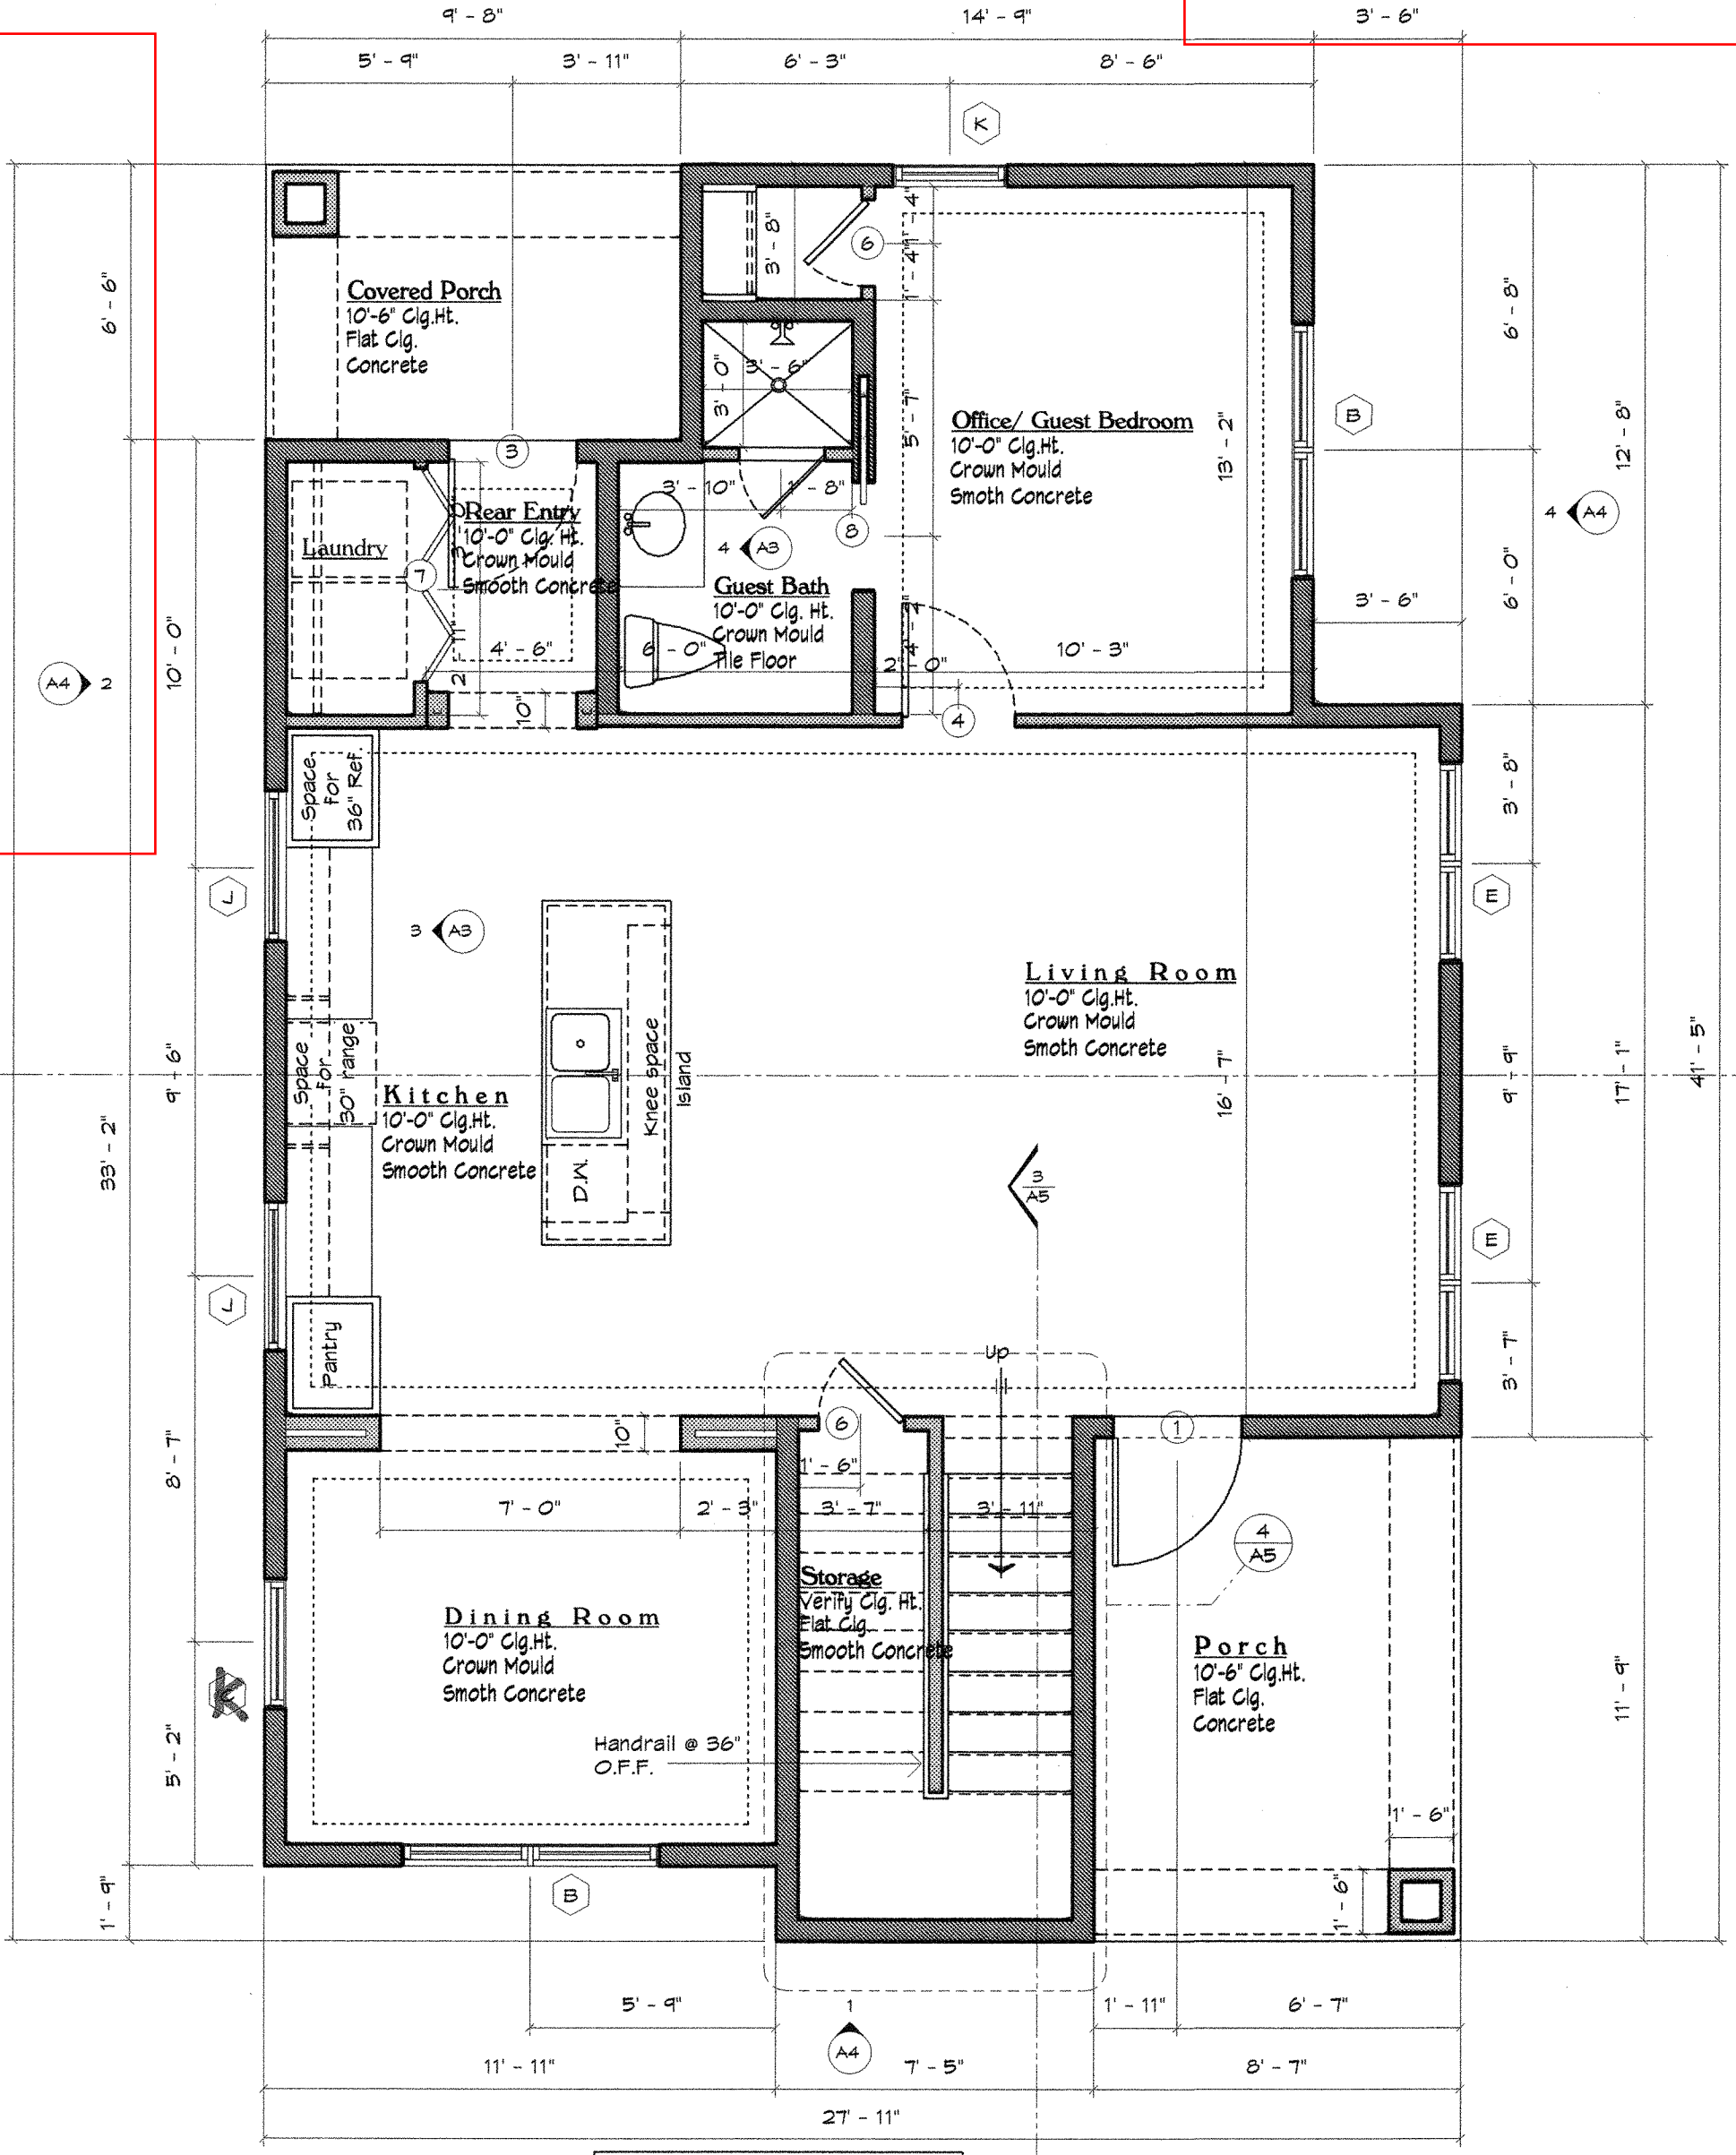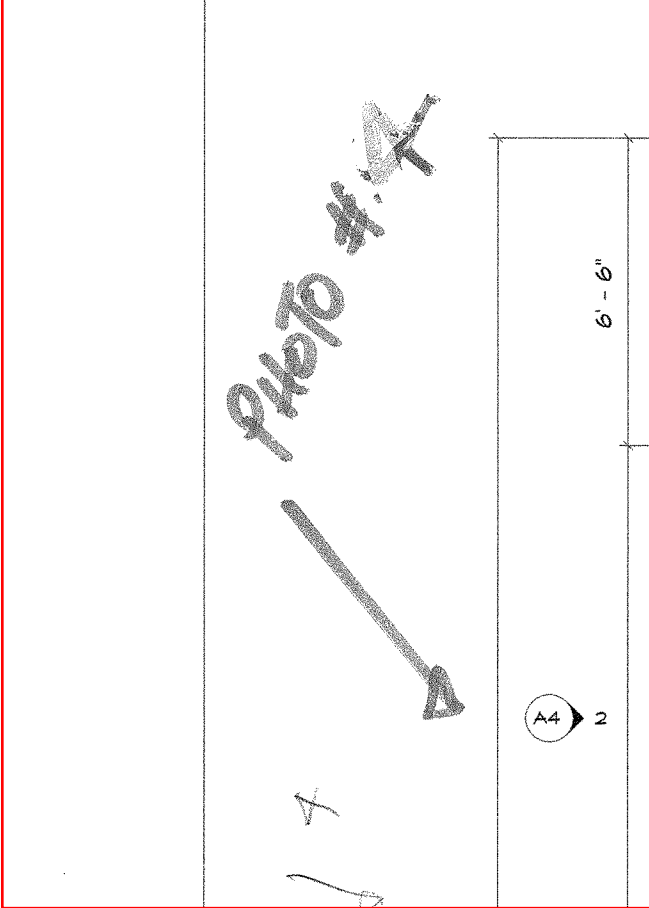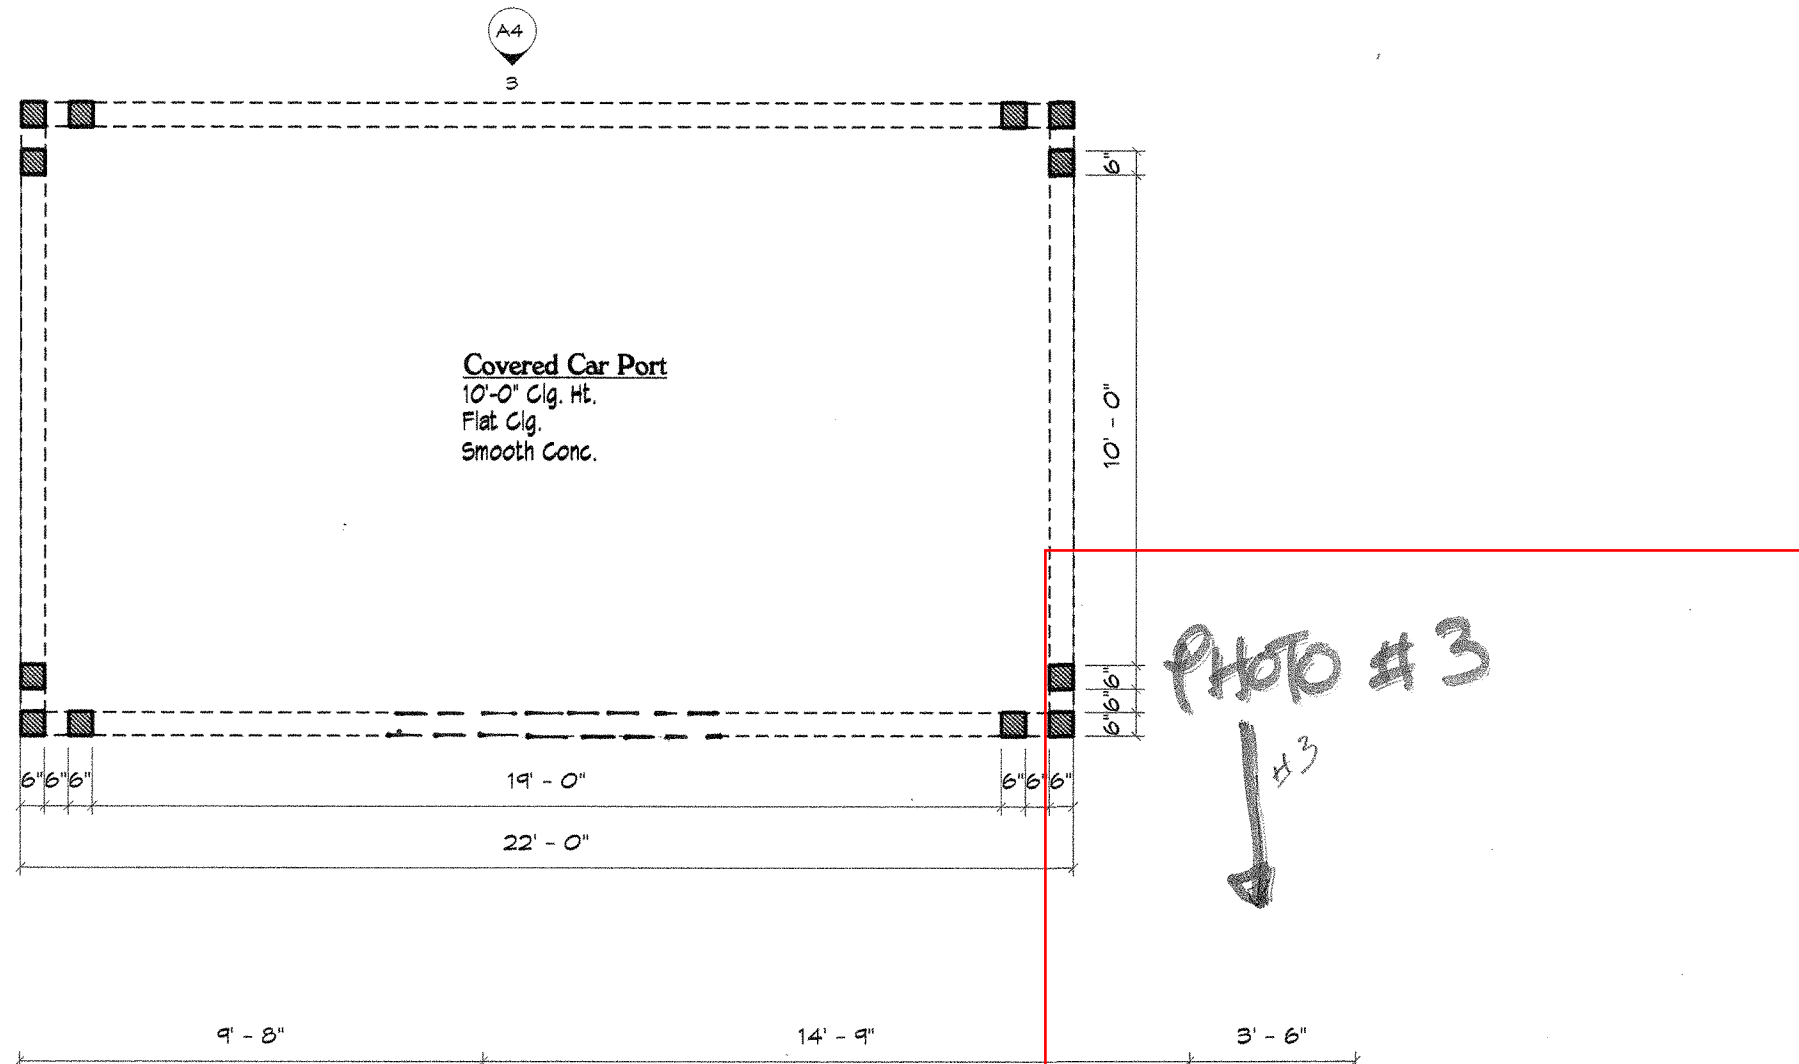


1 First Floor Notes Plan  
1/4" = 1'-0"

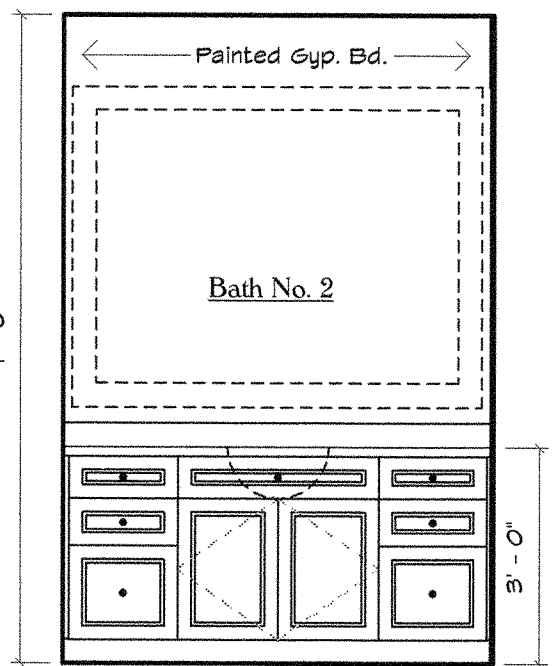



6 205 Bath No. 2  
3/8" = 1'-0"

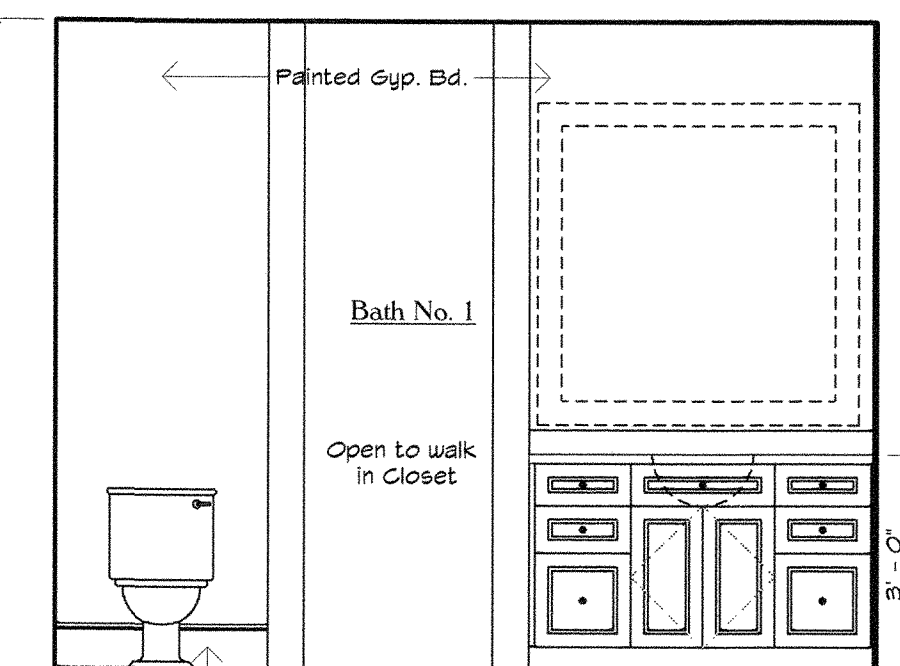


5 202 Bath No. 1  
3/8" = 1'-0"

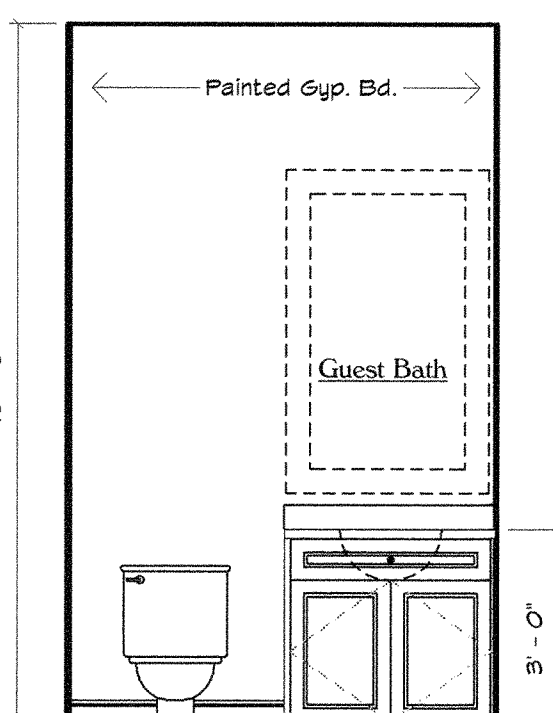

4 105 Guest Bath  
3/8" = 1'-0"

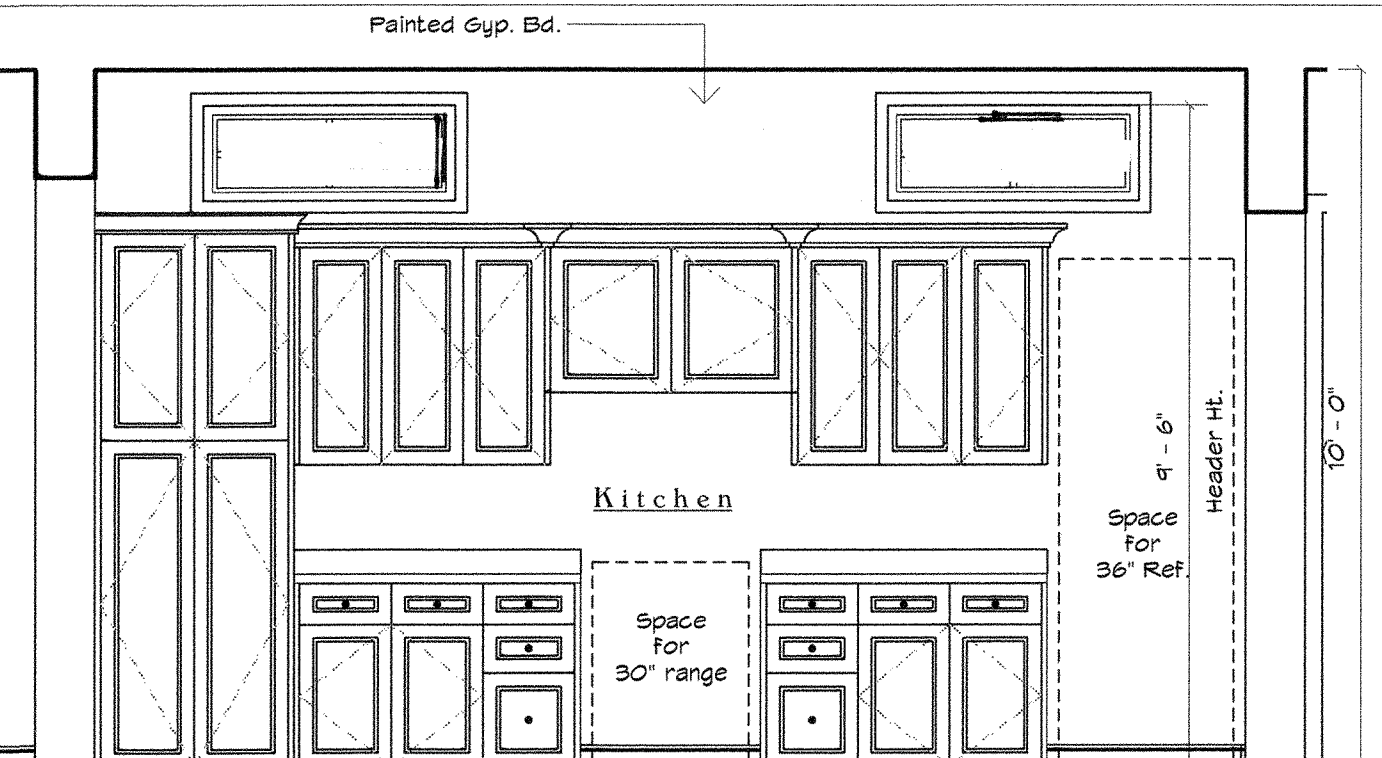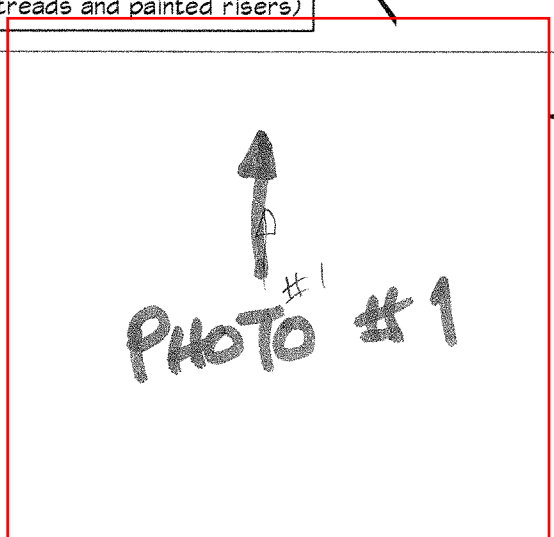

3 102 Kitchen  
3/8" = 1'-0"

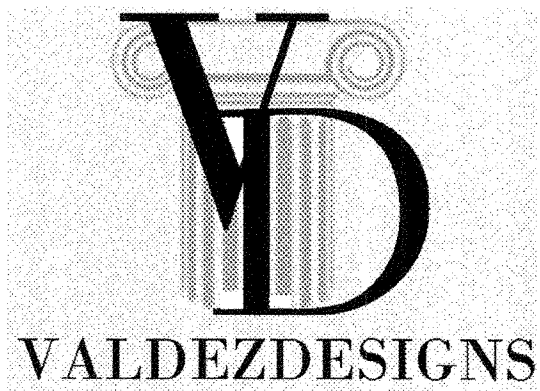

Legal Notice of Copyright:

1. THESE COPYRIGHTED PLANS AND RELATED DETAILS ARE DRAWN EXCLUSIVELY FOR THE USE OF VALDEZDESIGNS, INC.
  2. THESE PLANS AND RELATED DETAILS ARE THE LEGAL PROPERTY OF VALDEZDESIGNS, INC., LOCATED IN SAN ANTONIO, TEXAS.
  3. VALDEZDESIGNS, INC. HOLDS THE EXCLUSIVE RIGHT OF DISTRIBUTION.
  4. THE DRAWINGS BEING REPRESENTED MAY NOT BE COPIED IN FULL OR IN PART WITHOUT PRIOR WRITTEN PERMISSION GRANTED BY VALDEZDESIGNS, INC.
- VALDEZDESIGNS, Inc.  
San Antonio, Texas  
Voice (210) 618-1234

BRIGHTSTAR  
DEVELOPMENT LLC.  
210.882.2038

DIGNOWITY HILL  
610 DAWSON ST.  
SAN ANTONIO TX  
LOT: 20  
COUNTY BLOCK: 17

Plan Information:

Drawn By: JV RB  
Project #: 1110  
Copyright: 2016

Revisions:

- 1 07-14-2016
- 2

Issue Date:


07-14-2016

Sheet Title & No.

FLOOR PLANS NOTES

A3




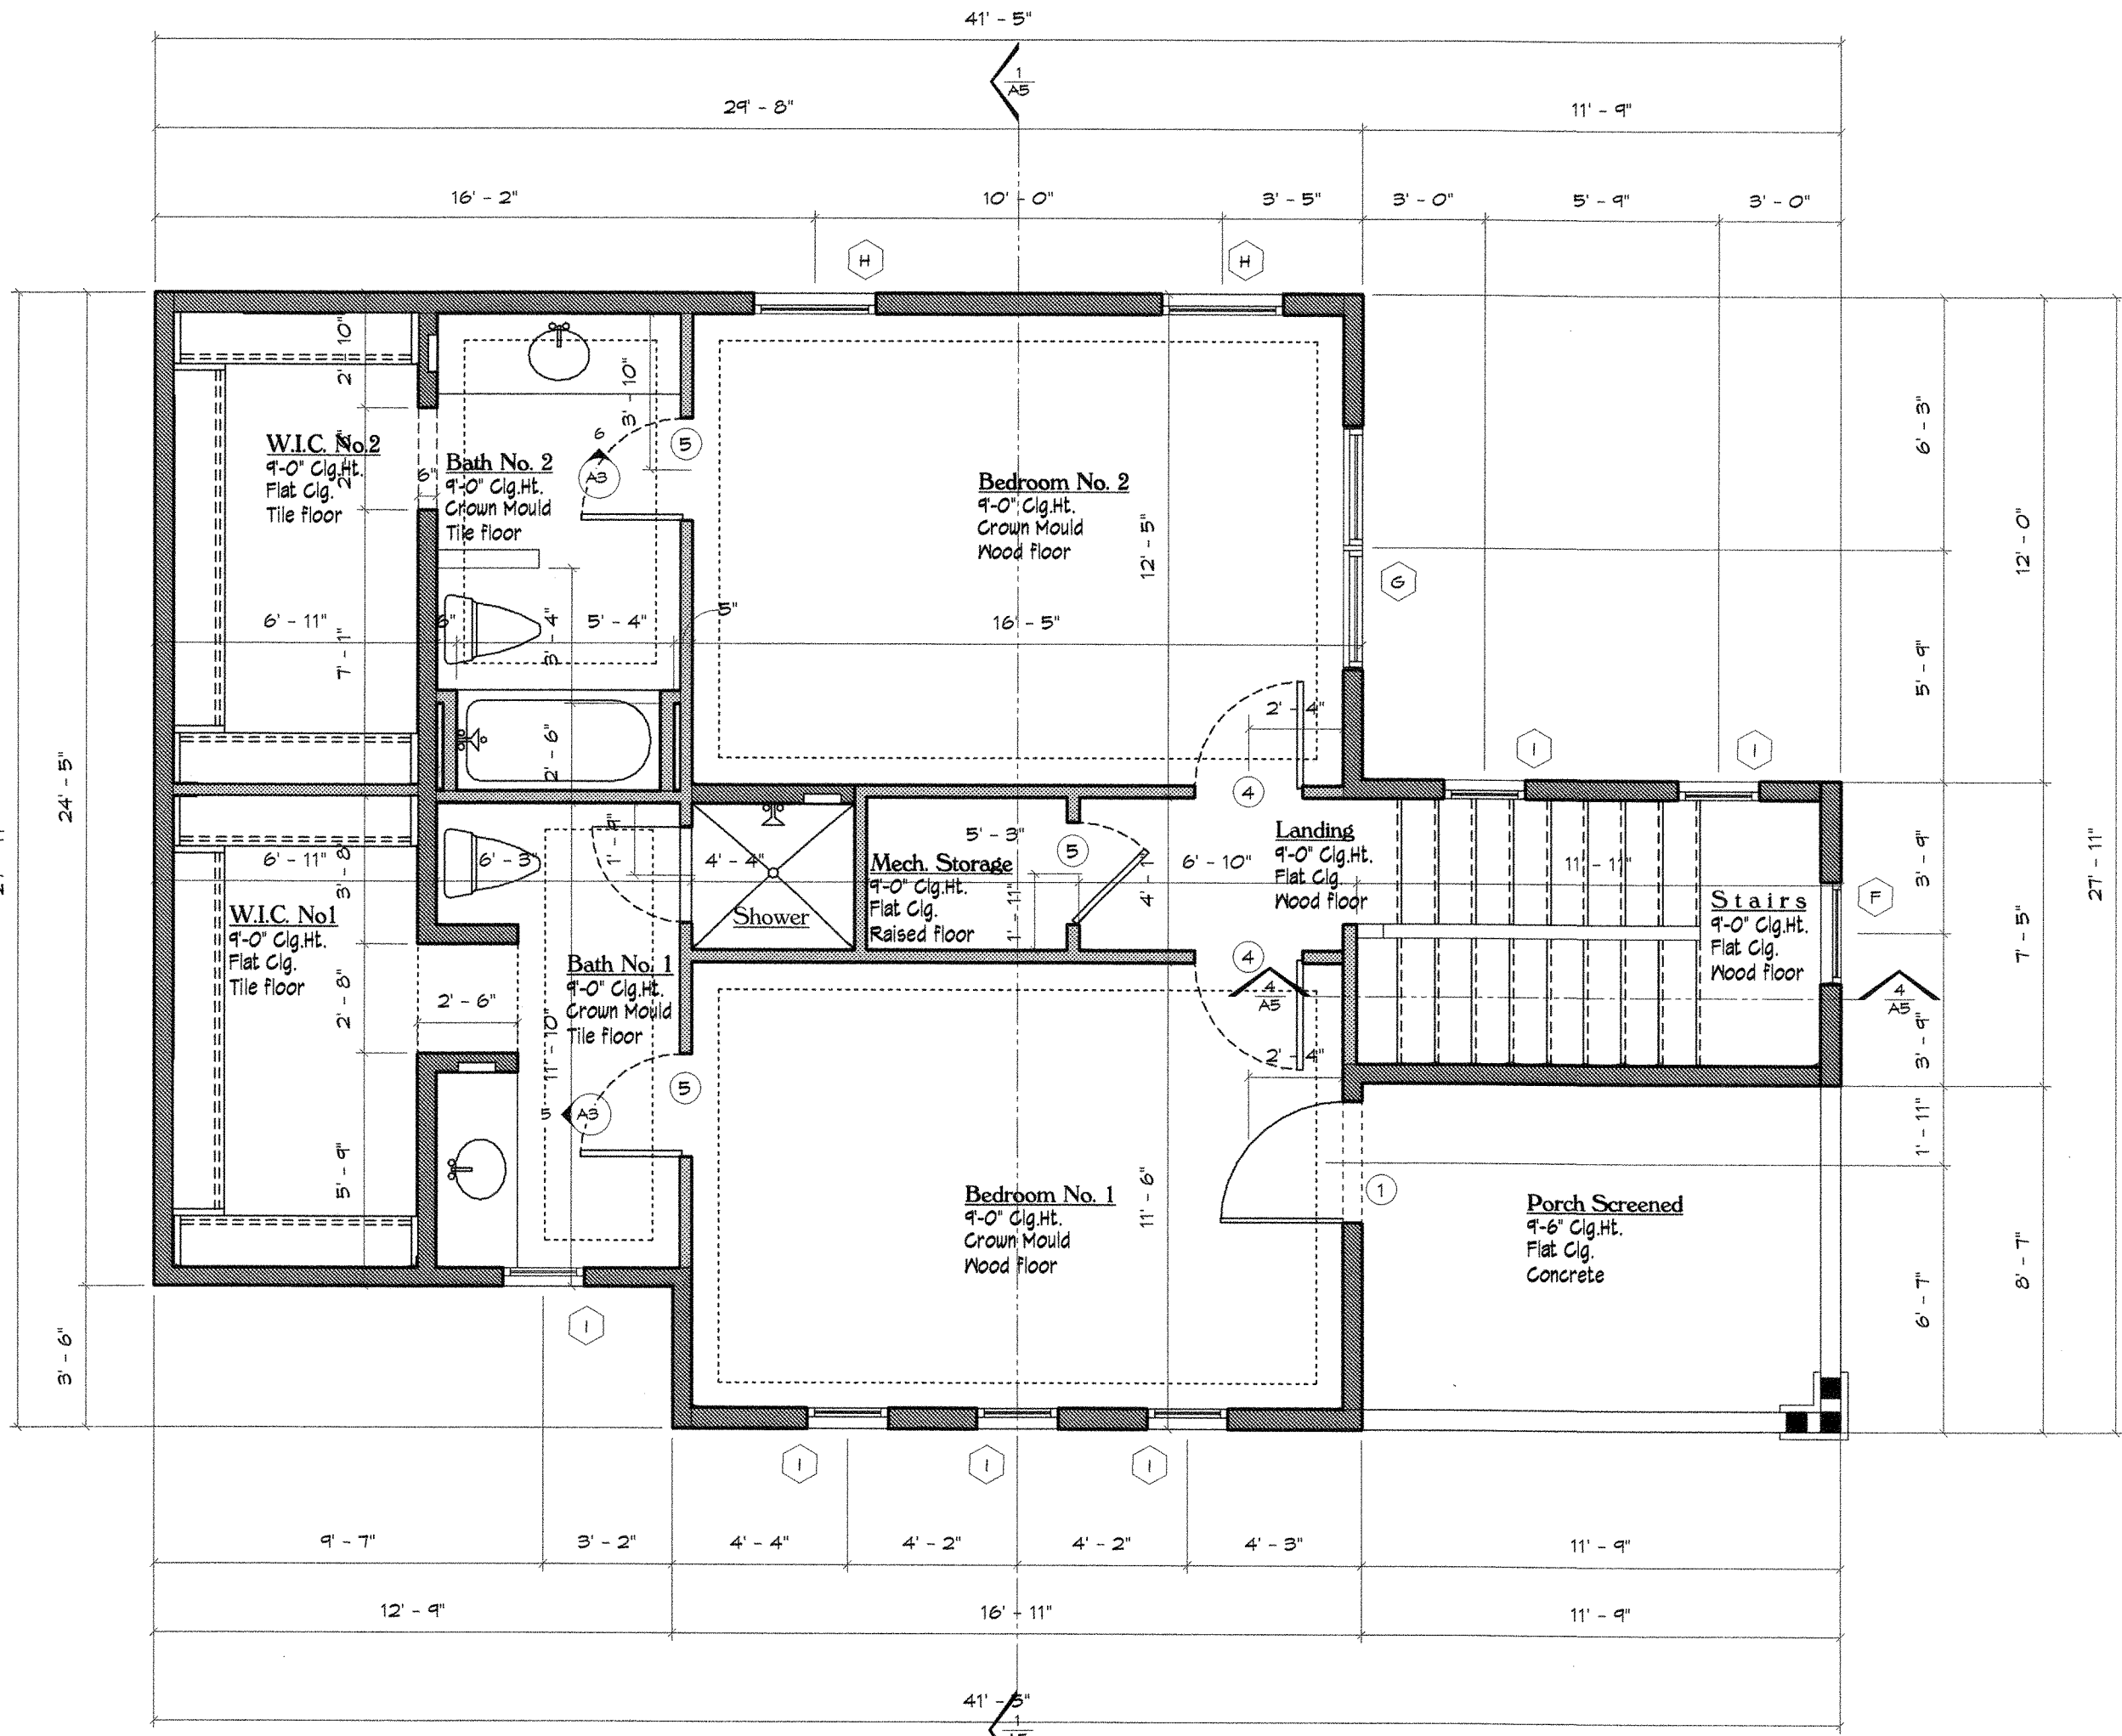




2 Second Notes Floor  
1/4" = 1'-0"

AS-BUILT / 608


PHOTO # 7

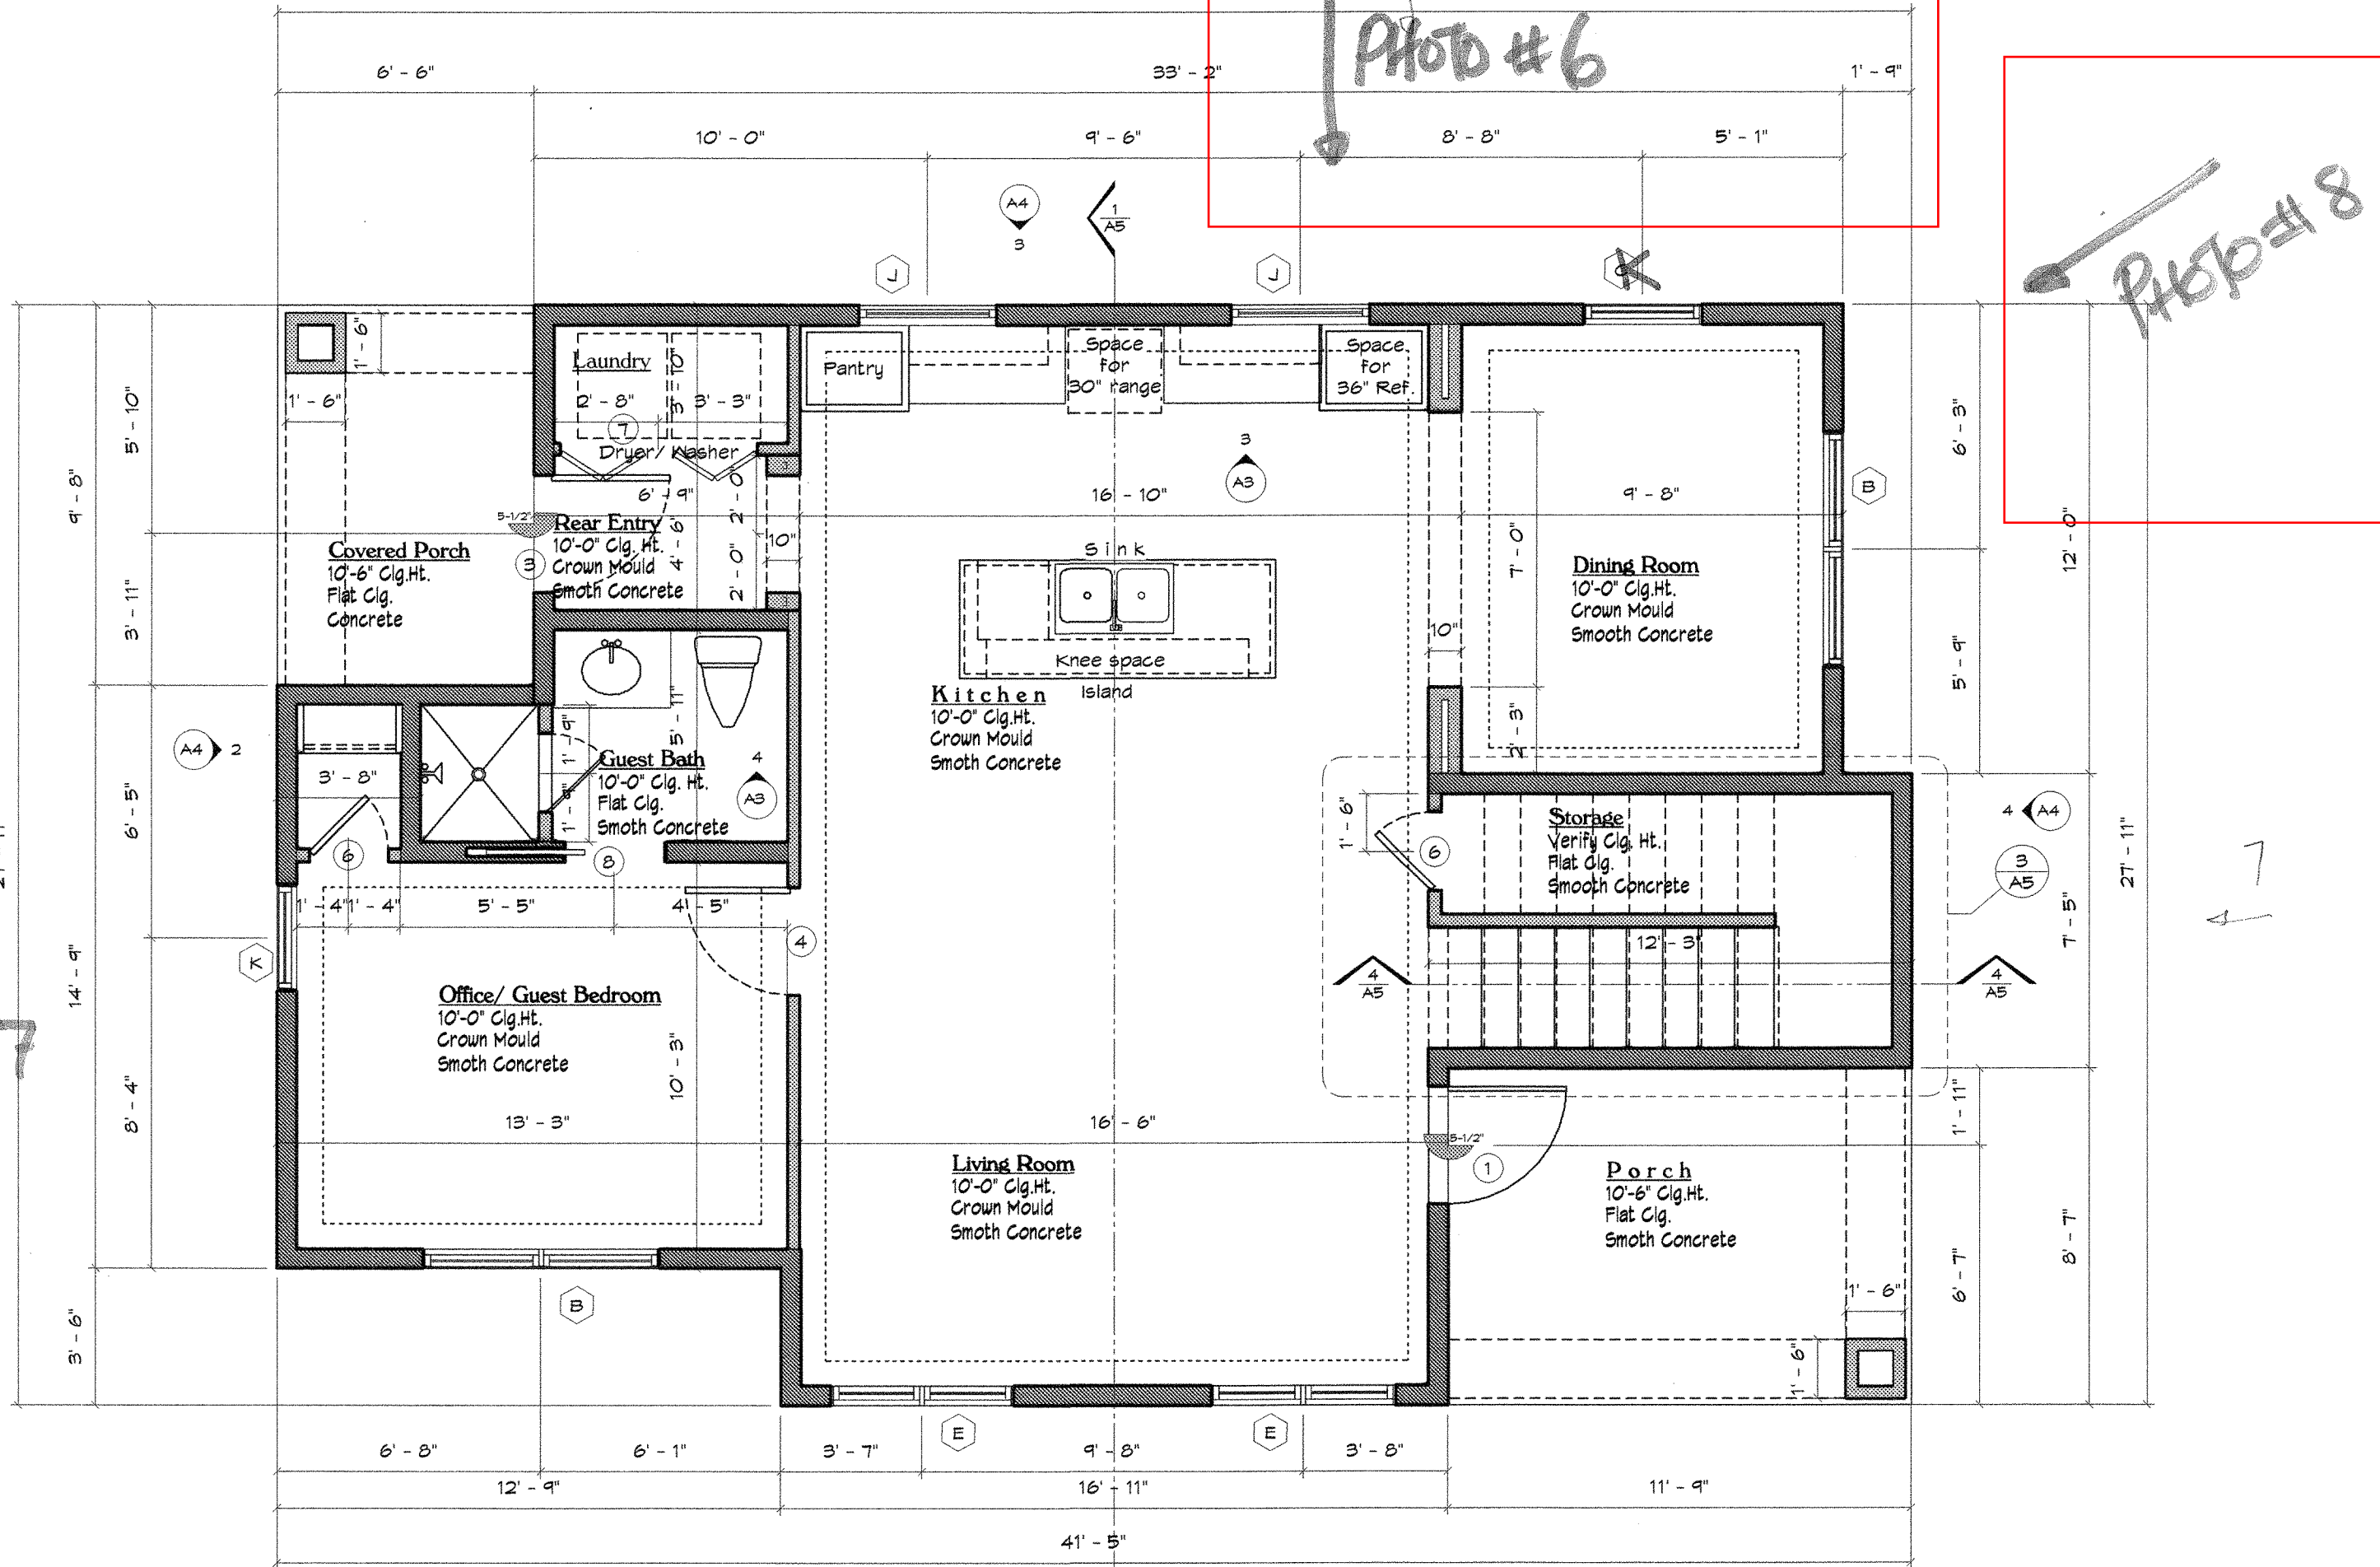


1 First Floor Notes Plan  
1/4" = 1'-0"

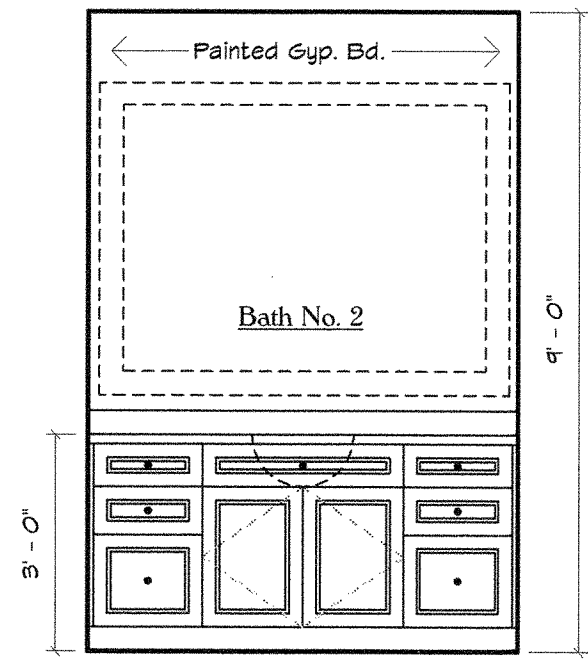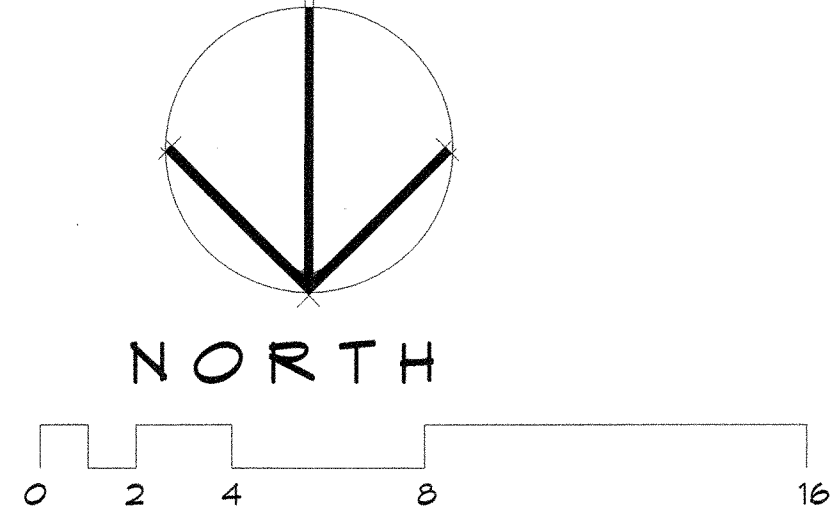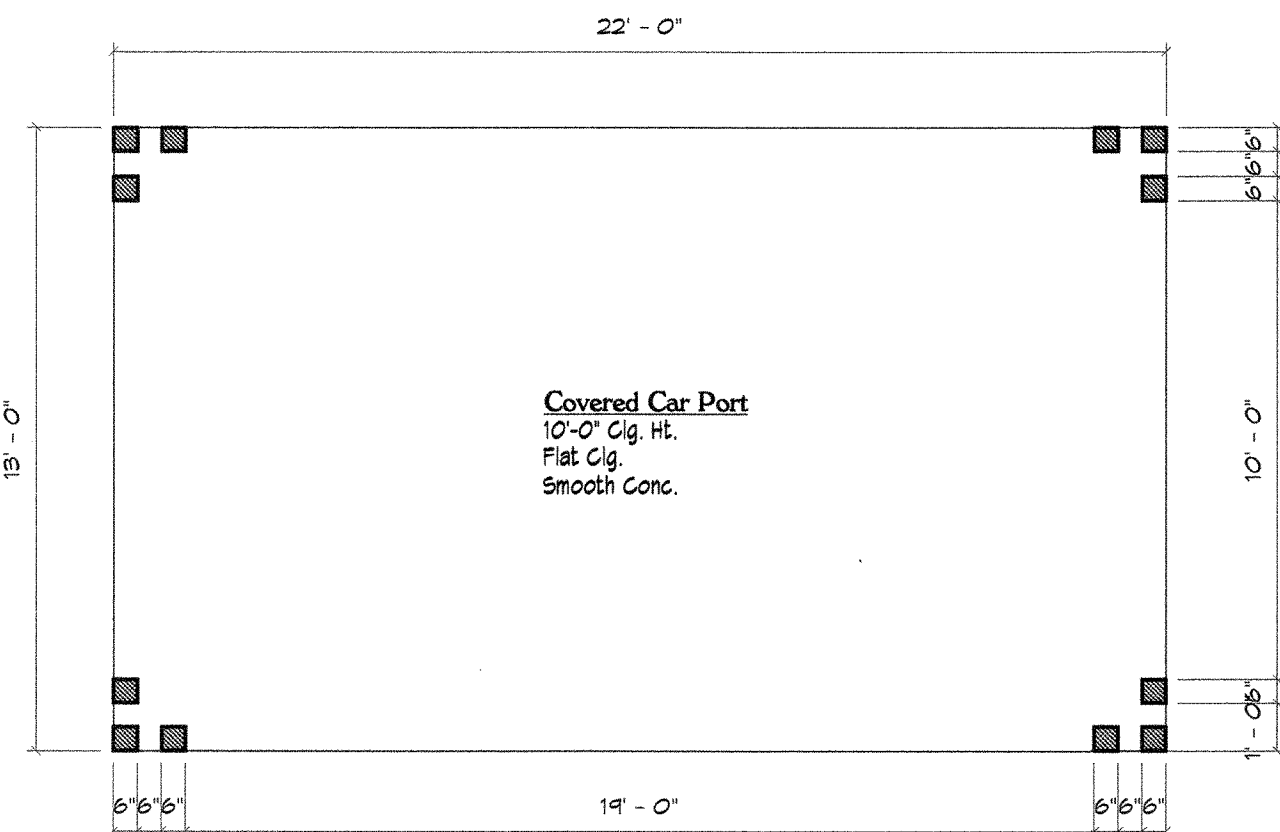


6 205 Bath No. 2  
3/8" = 1'-0"

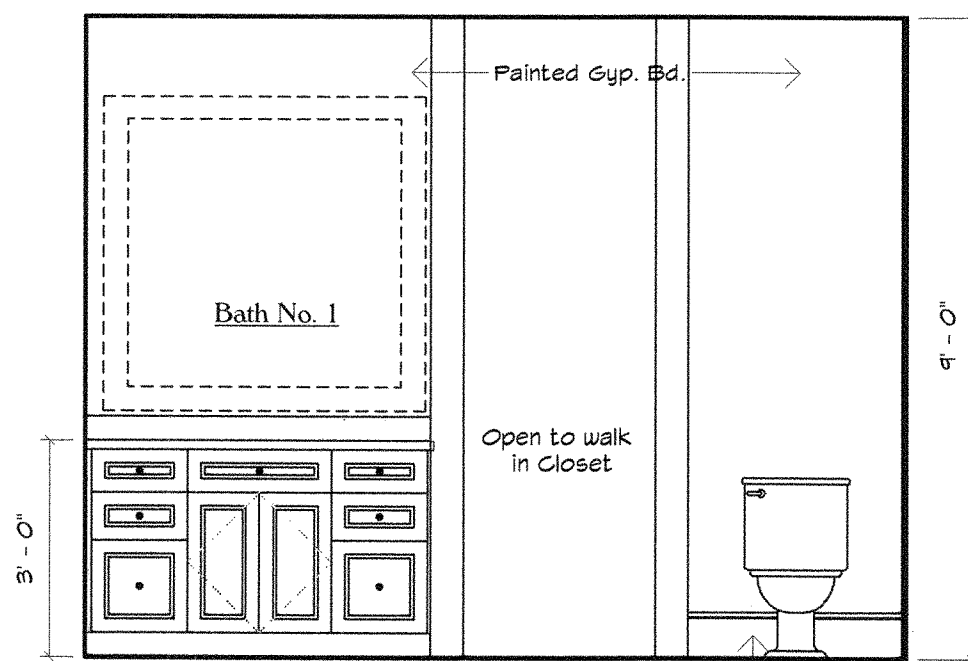


5 202 Bath No. 1  
3/8" = 1'-0"

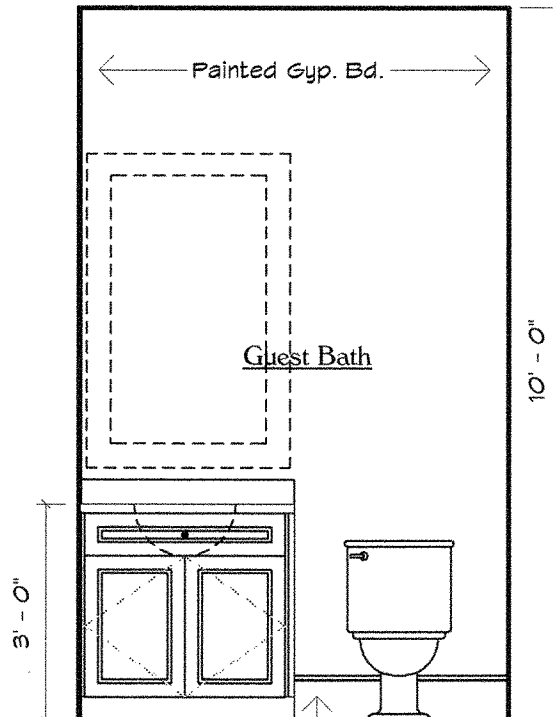

4 105 Guest Bath  
3/8" = 1'-0"

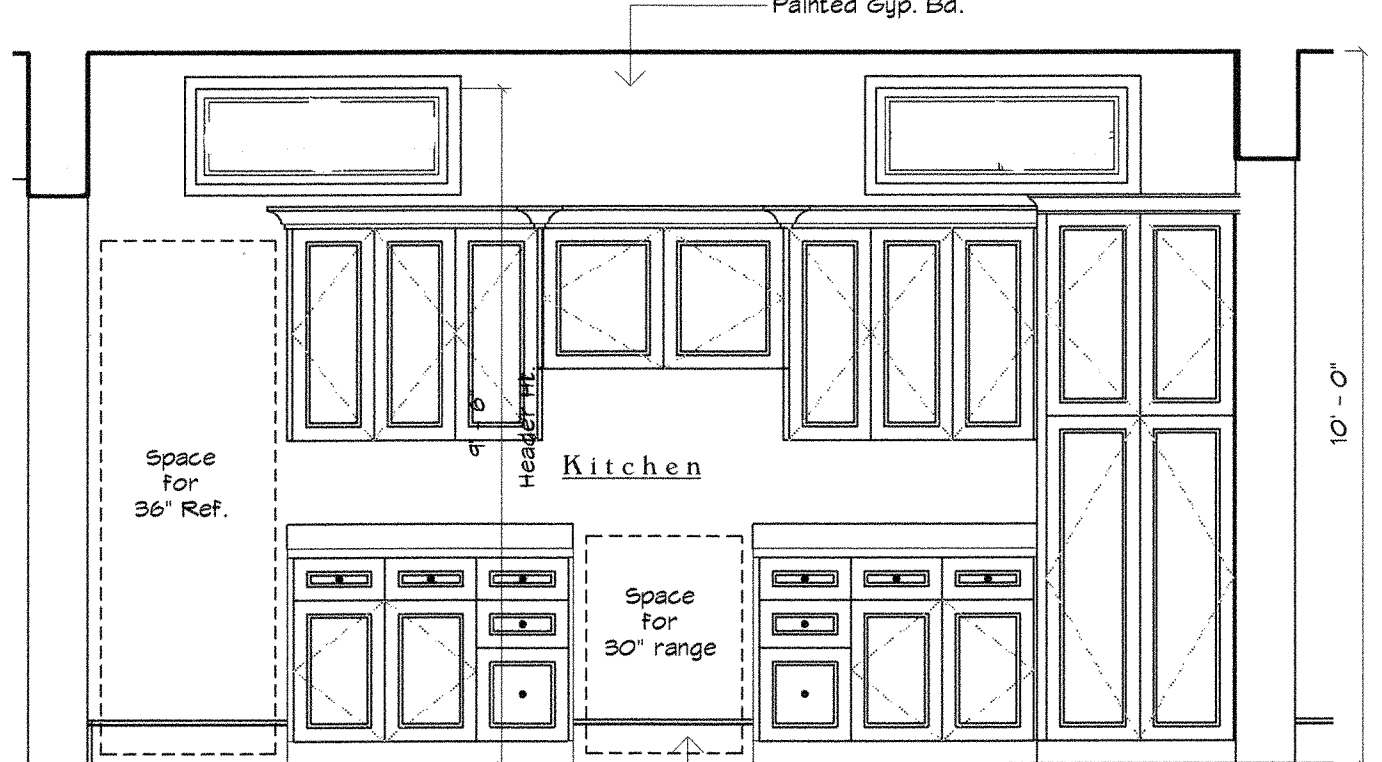

3 102 Kitchen  
3/8" = 1'-0"

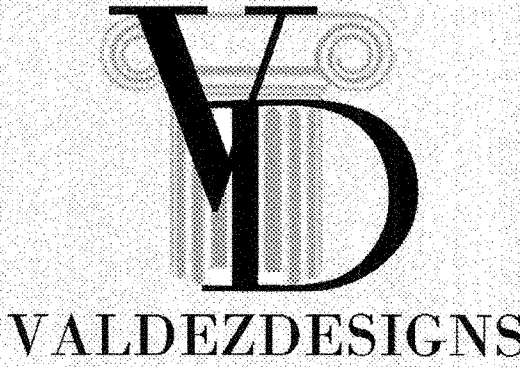

Legal Notice of Copyright:

1. THESE COPYRIGHTED PLANS AND RELATED DETAILS ARE DRAWN EXCLUSIVELY FOR THE USE OF VALDEZDESIGNS, INC.
  2. THESE PLANS AND RELATED DETAILS ARE THE LEGAL PROPERTY OF VALDEZDESIGNS, INC. LOCATED IN SAN ANTONIO, TEXAS
  3. VALDEZDESIGNS, INC. HOLDS THE EXCLUSIVE RIGHT OF DISTRIBUTION.
  4. THE DRAWINGS BEING REPRESENTED MAY NOT BE COPIED IN FULL OR IN PART WITHOUT PRIOR WRITTEN PERMISSION GRANTED BY VALDEZDESIGNS, INC.
- VALDEZDESIGNS, Inc.  
San Antonio, Texas  
Voice (210) 618-1294

BRIGHTSTAR  
DEVELOPMENT LLC.  
210.882.2038

DIGNOWITY HILL  
608 Dawson St  
SAN ANTONIO TX  
LOT: 19  
COUNTY BLOCK: 17

(3)

Plan Information:

Drawn By: JV RB  
Project #: 1110  
Copyright: 2016

Revisions:

- 1 07-14-2016
- 2

Issue Date:

07-14-2016


Sheet Title & No.

FLOOR PLANS

A3



SUBMITTED BY APPLICANT 1/ /2 17

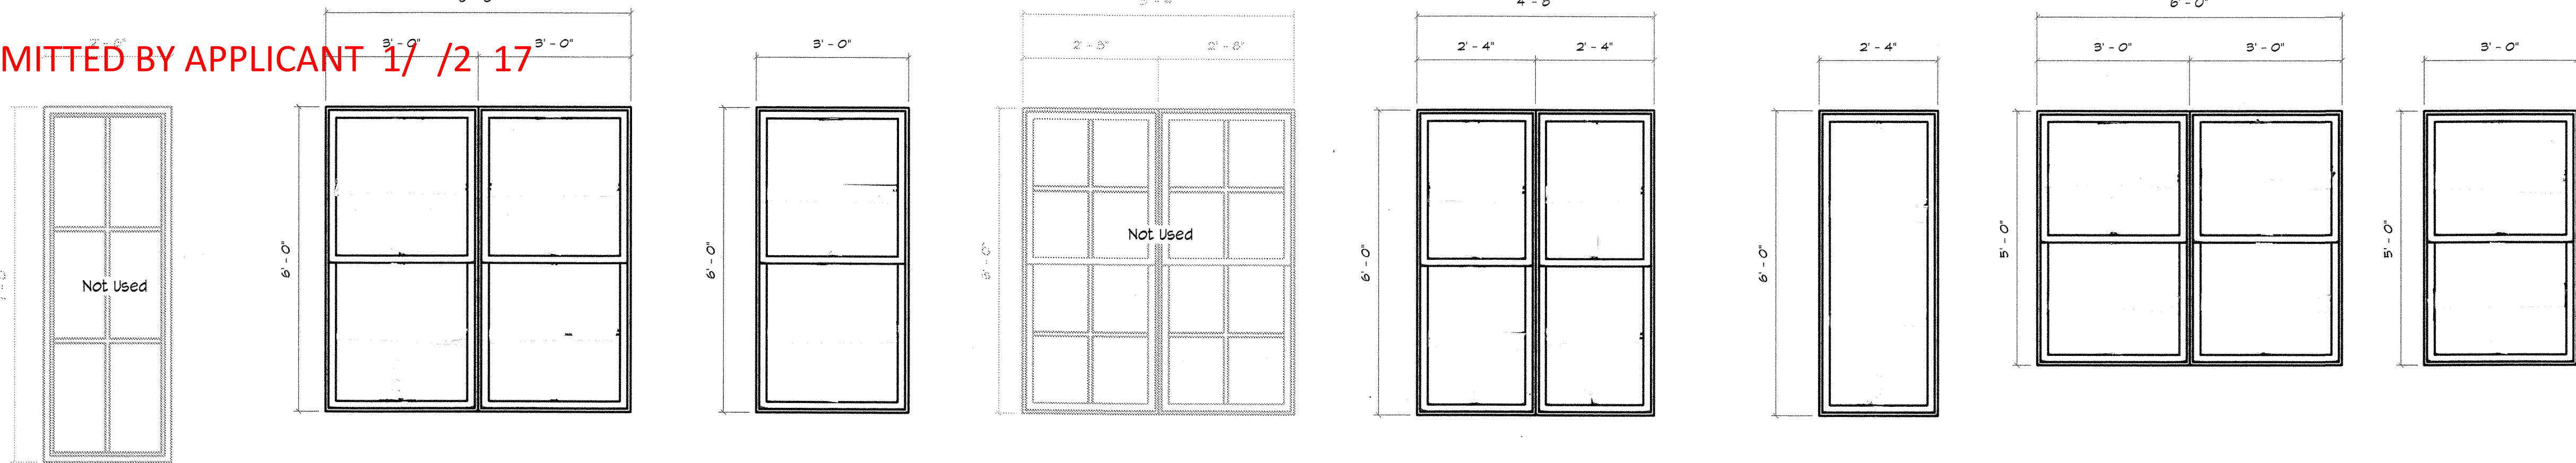


Window Notes

1. All windows and exterior doors will be wood.
2. All windows are to have a slope sill to prevent water damage.
3. Rough openings for windows/ milled assemblies are approximate and must be verified with window manufacturer and shop drawings must be approved by builder.
4. Refer to floor plans and elevations for proper operation of each individual window.

1 Window Schedule

scale: 1/2" = 1'-0"

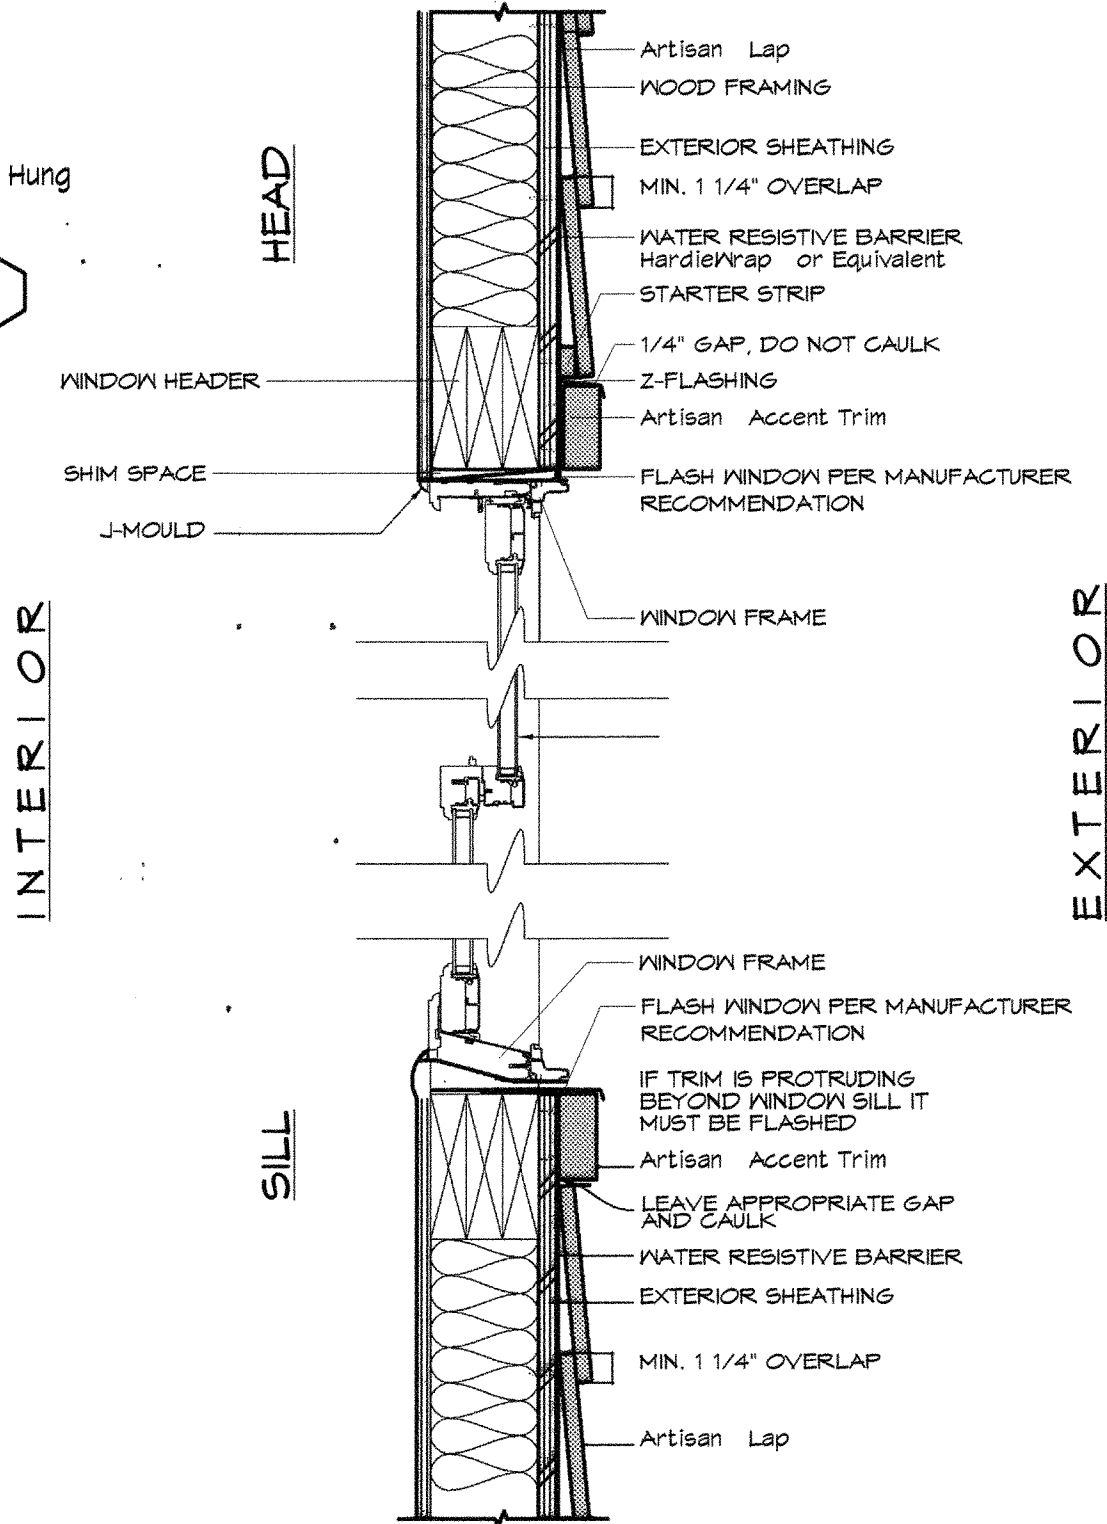

2 Wood Window Detail @ Lap Siding

1 1/2" = 1'-0"


Door Notes

1. All interior Panel Doors will be 3 panel and coordinated with interior designer and owner.
2. Odd size attic access doors are flush panel/ fully gasketed and weather-stripped.
3. All exterior doors to be also fully gasketed and weather-stripped to prevent all weather damage.
4. Verify all door operations and directions with owner prior to purchasing doors and installation.

3 Door Schedule


scale: 1/2" = 1'-0"

SEE PHOTO OF PROPOSED DOOR FOR DETAILS

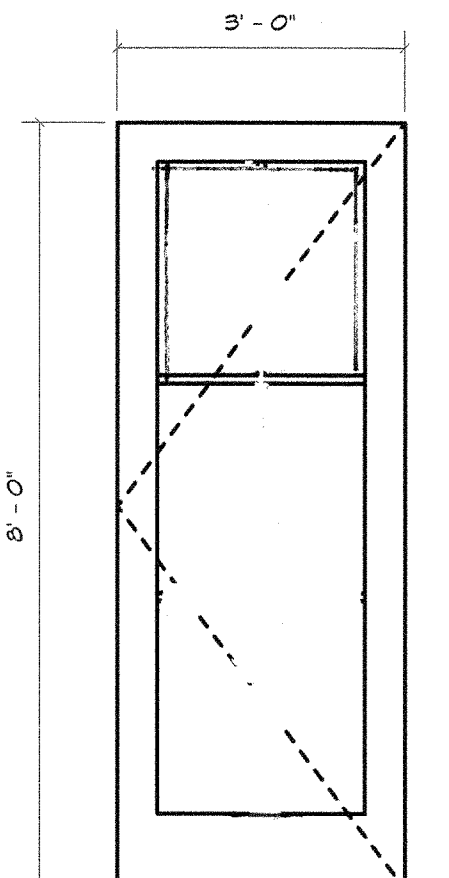

French Door  
To be picked by Builder

1

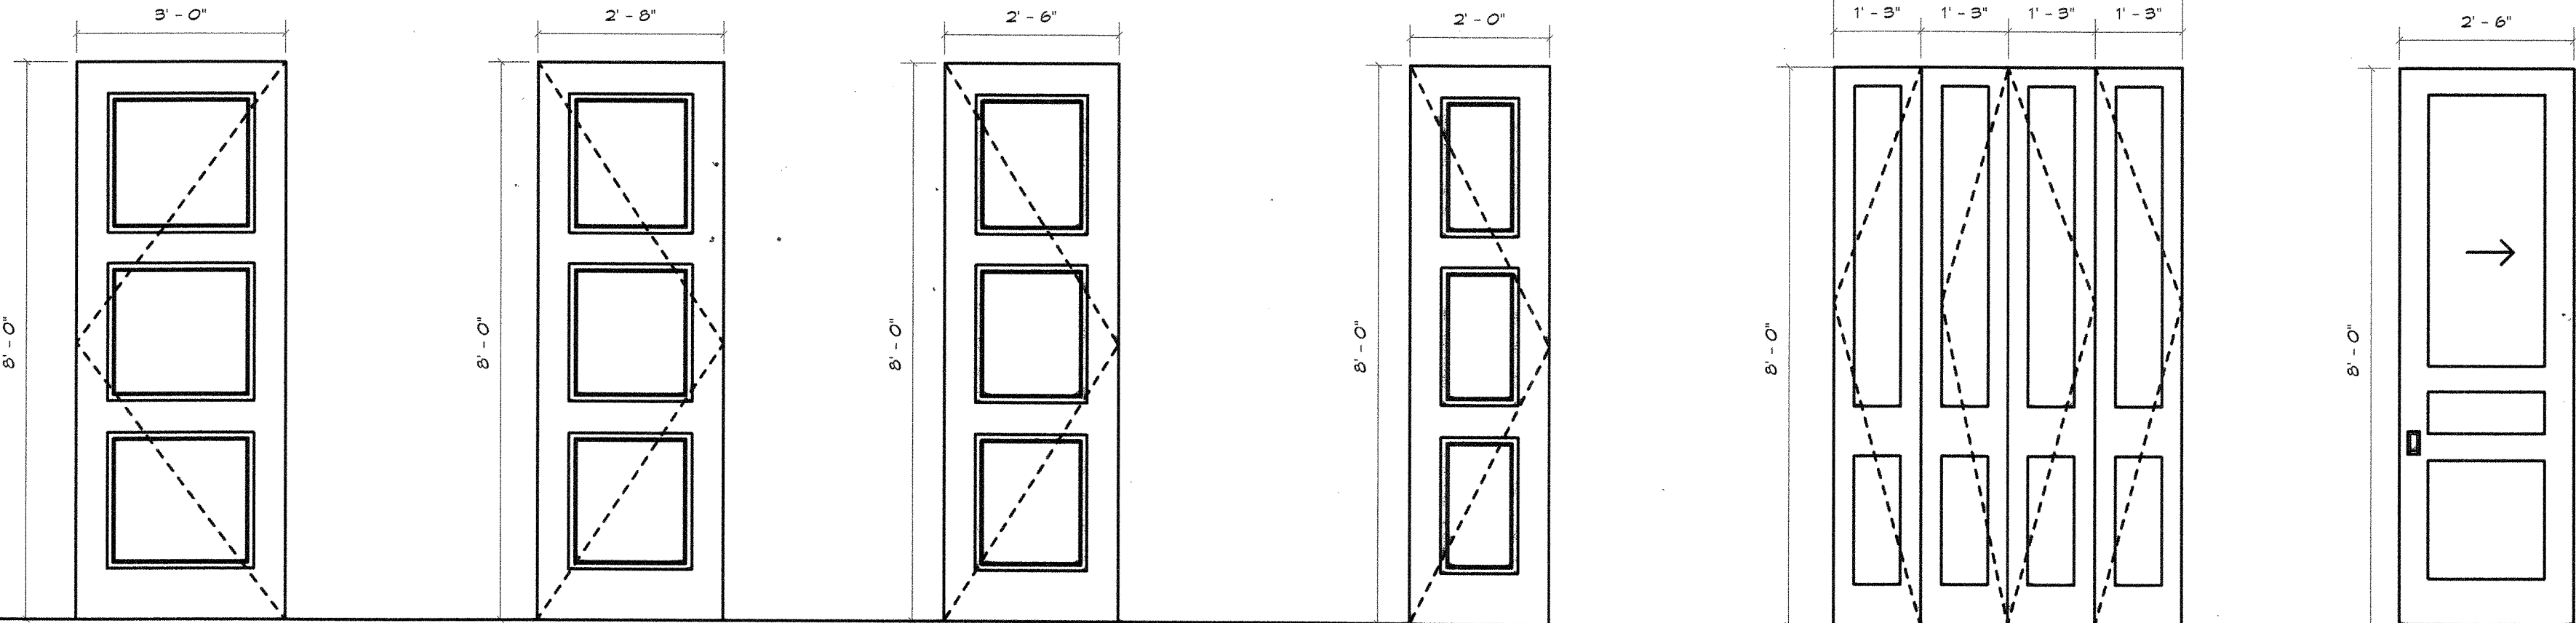

Solid core door  
with closer  
(Painted)

3

Panel door  
Interior Door  
(Painted)

4

Panel door  
Interior Door  
(Painted)

5

Panel door  
Interior Door  
(Painted)


6

Panel Bi-fold door  
(Painted)

7

Panel Pocket door  
(Painted)

8

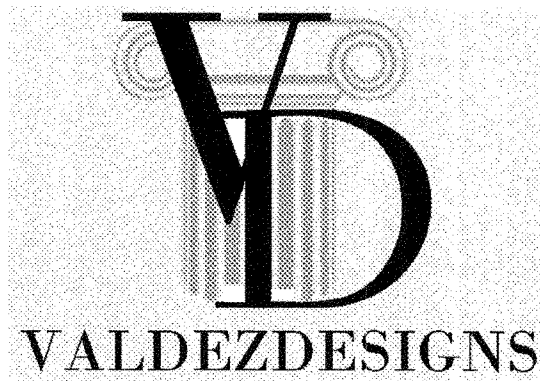

Legal Notice of Copyright:

1. THESE COPYRIGHTED PLANS AND RELATED DETAILS ARE DRAWN EXCLUSIVELY FOR THE USE OF VALDEZDESIGNS, INC.

2. THESE PLANS AND RELATED DETAILS ARE THE LEGAL PROPERTY OF VALDEZDESIGNS INC. LOCATED IN SAN ANTONIO, TEXAS

3. VALDEZDESIGNS, INC. HOLDS THE EXCLUSIVE RIGHT OF DISTRIBUTION.

4. THE DRAWINGS BEING REPRESENTED MAY NOT BE COPIED IN FULL OR IN PART WITHOUT PRIOR WRITTEN PERMISSION GRANTED BY VALDEZDESIGNS, INC.

VALDEZDESIGNS, Inc.  
San Antonio, Texas  
Voice (210) 618-1294

BRIGHTSTAR  
DEVELOPMENT LLC.  
210.882.2038

DIGNOWITY HILL  
610/608 608 Dawson St  
SAN ANTONIO TX  
LOT: 19  
COUNTY BLOCK: 17

Plan Information:

Drawn By: JV RB

Project #: 1110

Copyright: 2016

Revisions:

1 07-14-2016

2

Issue Date:

07-14-2016

Sheet Title & No.


DOORS AND  
WINDOWS

A6







ELEVATIONS APPROVED BY HDRC // 16  
BUILDING 1 - 61 DAWSON

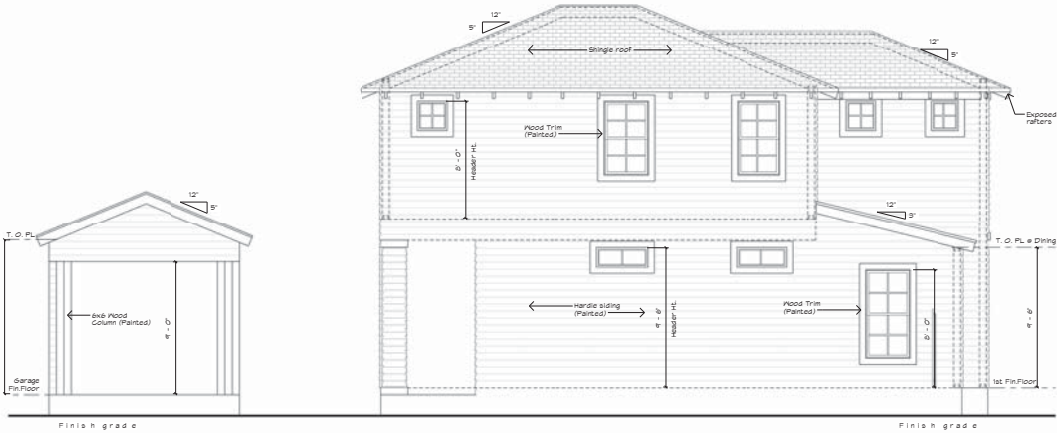


2 Building 1 Left Elevation  
1/4" = 1'-0"

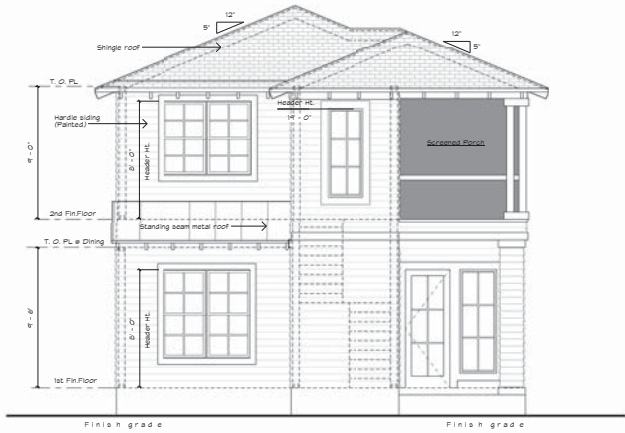

1 Building 1 Front elevation  
1/4" = 1'-0"

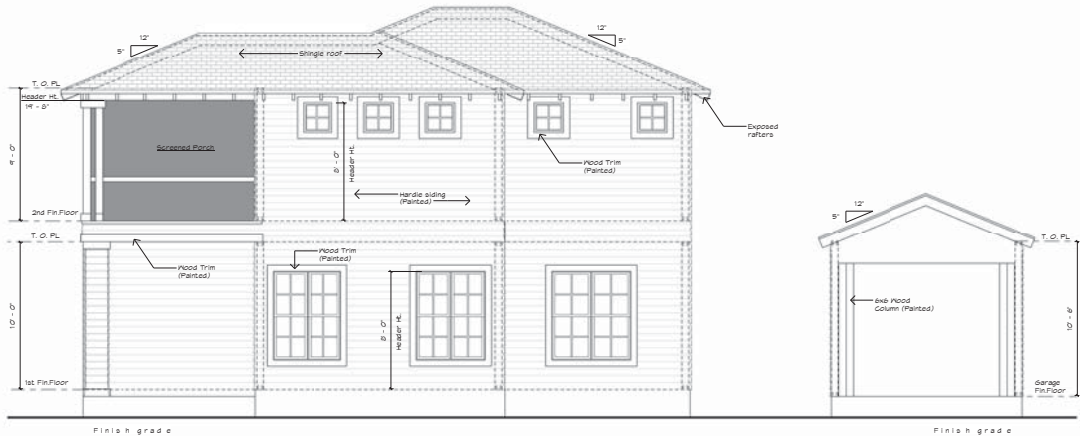

4 Building 1 Right Elevation  
1/4" = 1'-0"

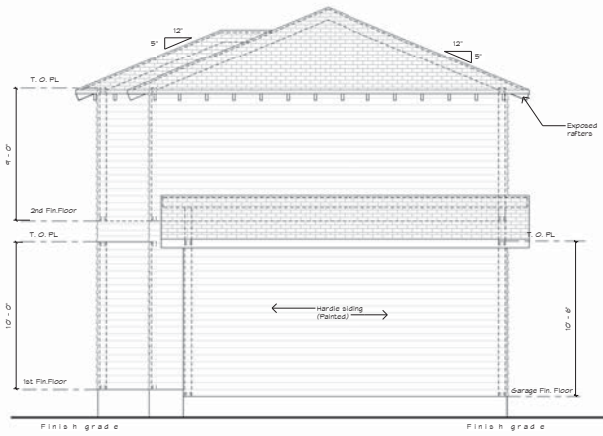

3 Building 1 Rear Elevation  
1/4" = 1'-0"

CARPORT



Legal Notice of Copyright:

1. THESE COPYRIGHTED PLANS AND RELATED DETAILS ARE DRAWN EXCLUSIVELY FOR THE USE OF VALDEZDESIGNS, INC.
2. THESE PLANS AND RELATED DETAILS ARE THE LEGAL PROPERTY OF VALDEZDESIGNS, INC. LOCATED IN SAN ANTONIO, TEXAS.
3. VALDEZDESIGNS, INC. HOLDS THE EXCLUSIVE RIGHT OF DISTRIBUTION.
4. THE DRAWINGS BEING REPRESENTED MAY NOT BE COPIED IN FULL OR IN PART WITHOUT PRIOR WRITTEN PERMISSION GRANTED BY VALDEZDESIGNS, INC.

BRIGHTSTAR  
DEVELOPMENT LLC.  
210.882.2058

DIGNOWITY HILL  
610 DAWSON ST.  
SAN ANTONIO TX  
LOT: 3  
COUNTY BLOCK: 17

Plan Information:  
Drawn By: JV RB  
Project #: 1110  
Copyright: 2016

Revisions:  
1  
2


Issue Date:  
04-07-2016

Sheet Title & No.

EXTERIOR  
ELEVATIONS  
A4



SUBMITTED BY APPLICANT 1/ /2 17  
BUILDIN 1-61 DAWSON  
AS-BUILT/610

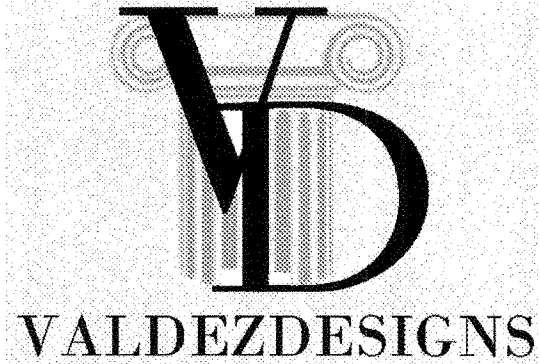

Legal Notice of Copyright:

1. THESE COPYRIGHTED PLANS AND RELATED DETAILS ARE DRAWN EXCLUSIVELY FOR THE USE OF VALDEZDESIGNS, INC.
  2. THESE PLANS AND RELATED DETAILS ARE THE LEGAL PROPERTY OF VALDEZDESIGNS, INC. LOCATED IN SAN ANTONIO, TEXAS
  3. VALDEZDESIGNS, INC. HOLDS THE EXCLUSIVE RIGHT OF DISTRIBUTION.
  4. THE DRAWINGS BEING REPRESENTED MAY NOT BE COPIED IN FULL OR IN PART WITHOUT PRIOR WRITTEN PERMISSION GRANTED BY VALDEZDESIGNS, INC.
- VALDEZDESIGNS, Inc.  
San Antonio, Texas  
Voice (210) 618-1294

BRIGHTSTAR  
DEVELOPMENT LLC.  
210.882.2038

DIGNOWITY HILL  
610 DAWSON ST.  
SAN ANTONIO TX  
LOT: 20  
COUNTY BLOCK: 17

Plan Information:

Drawn By: JV RB

Project #: 1110

Copyright: 2016

Revisions:

1 07-14-2016

2


Issue Date:

07-14-2016

Sheet Title & No.

EXTERIOR  
ELEVATIONS


A4

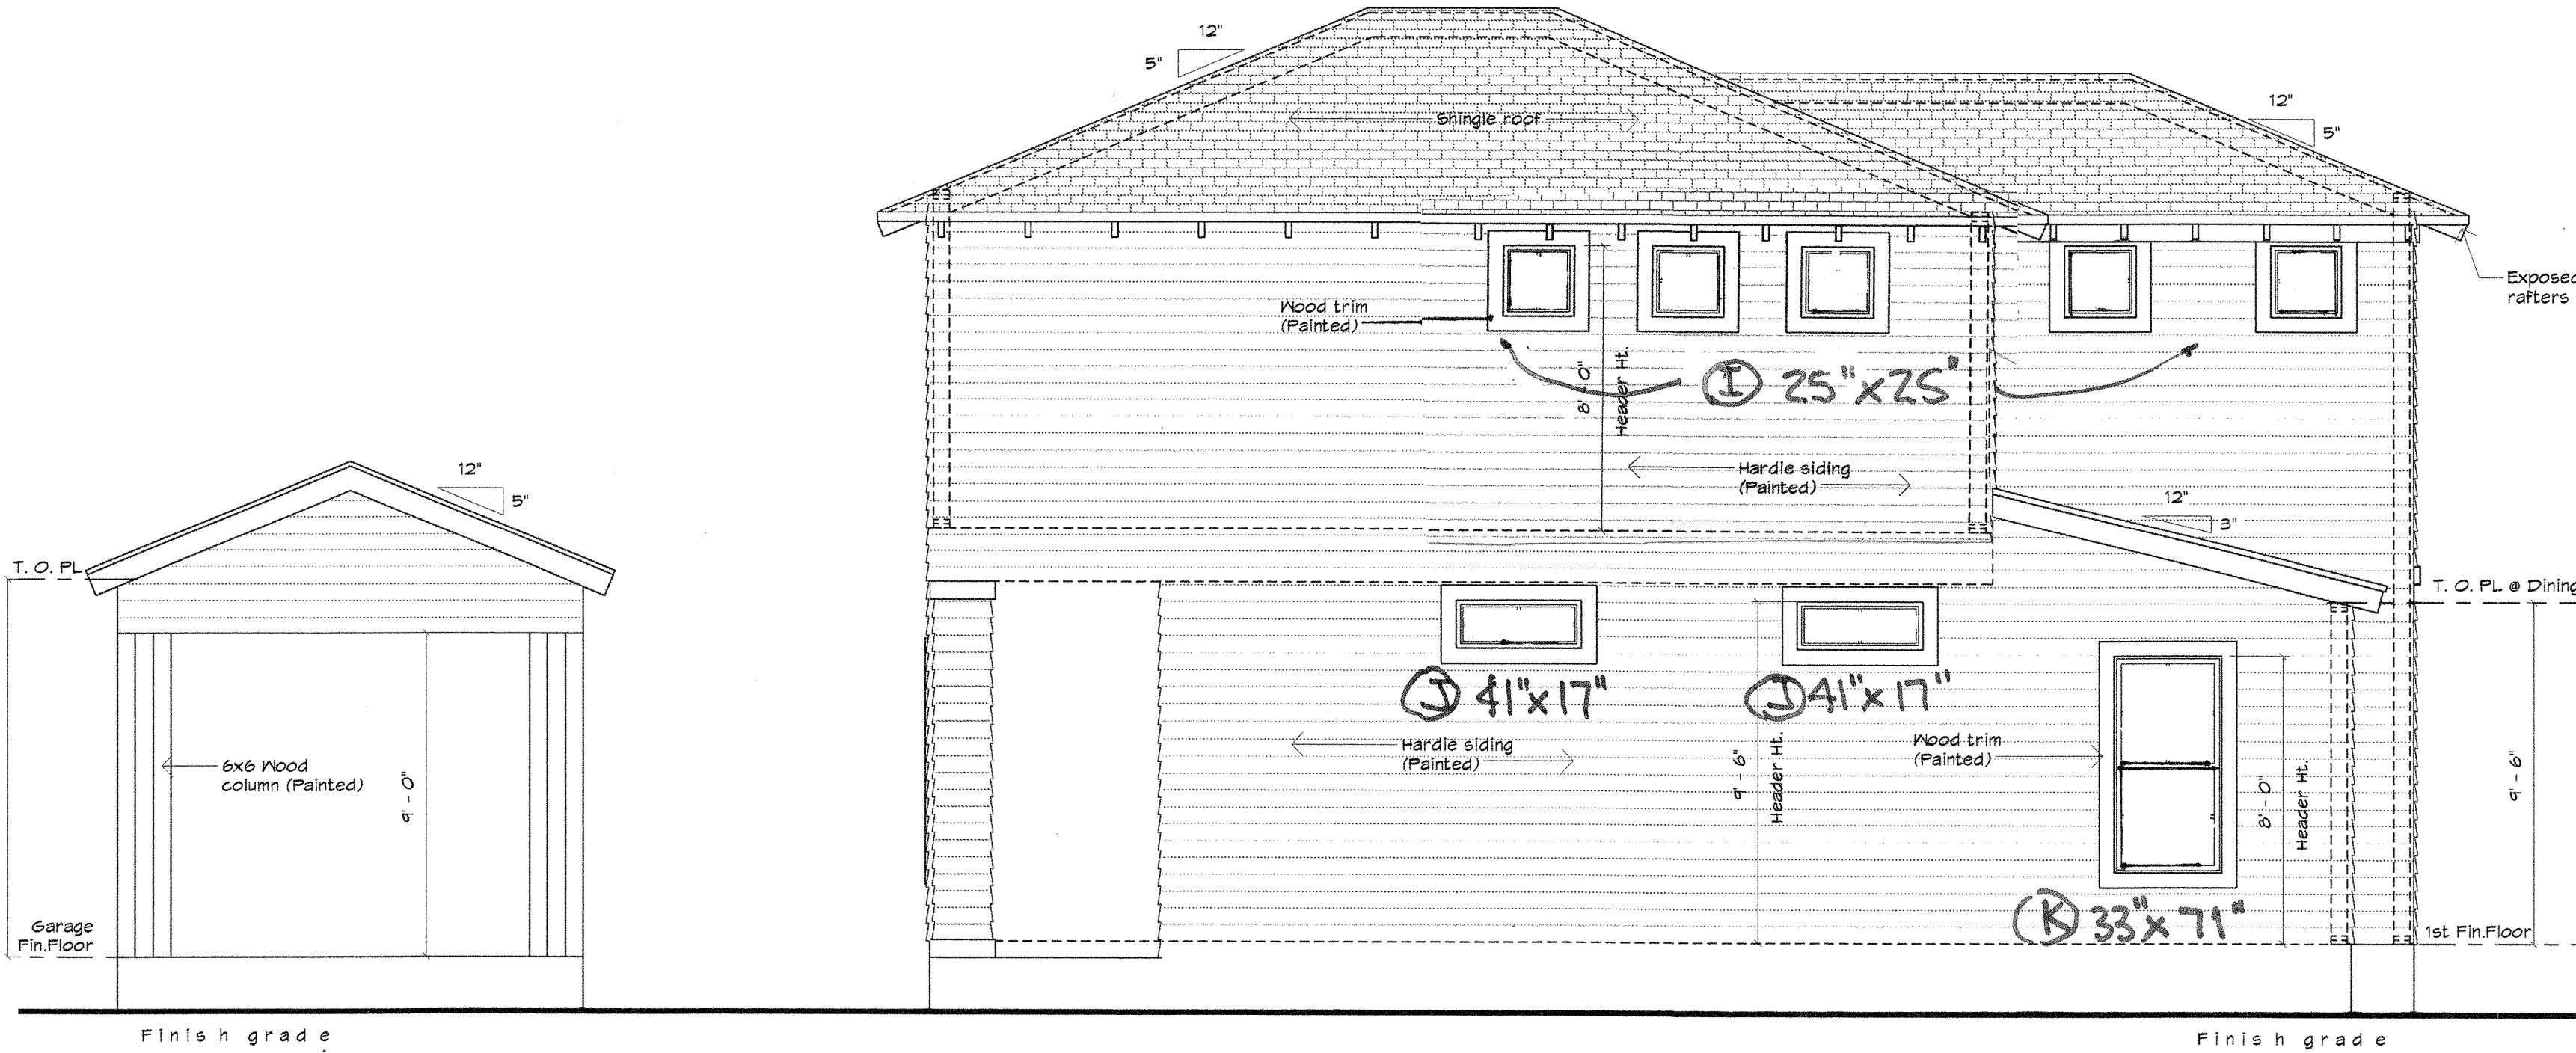


2 Left Elevation  
1/4" = 1'-0"



1 Front Elevation  
1/4" = 1'-0"

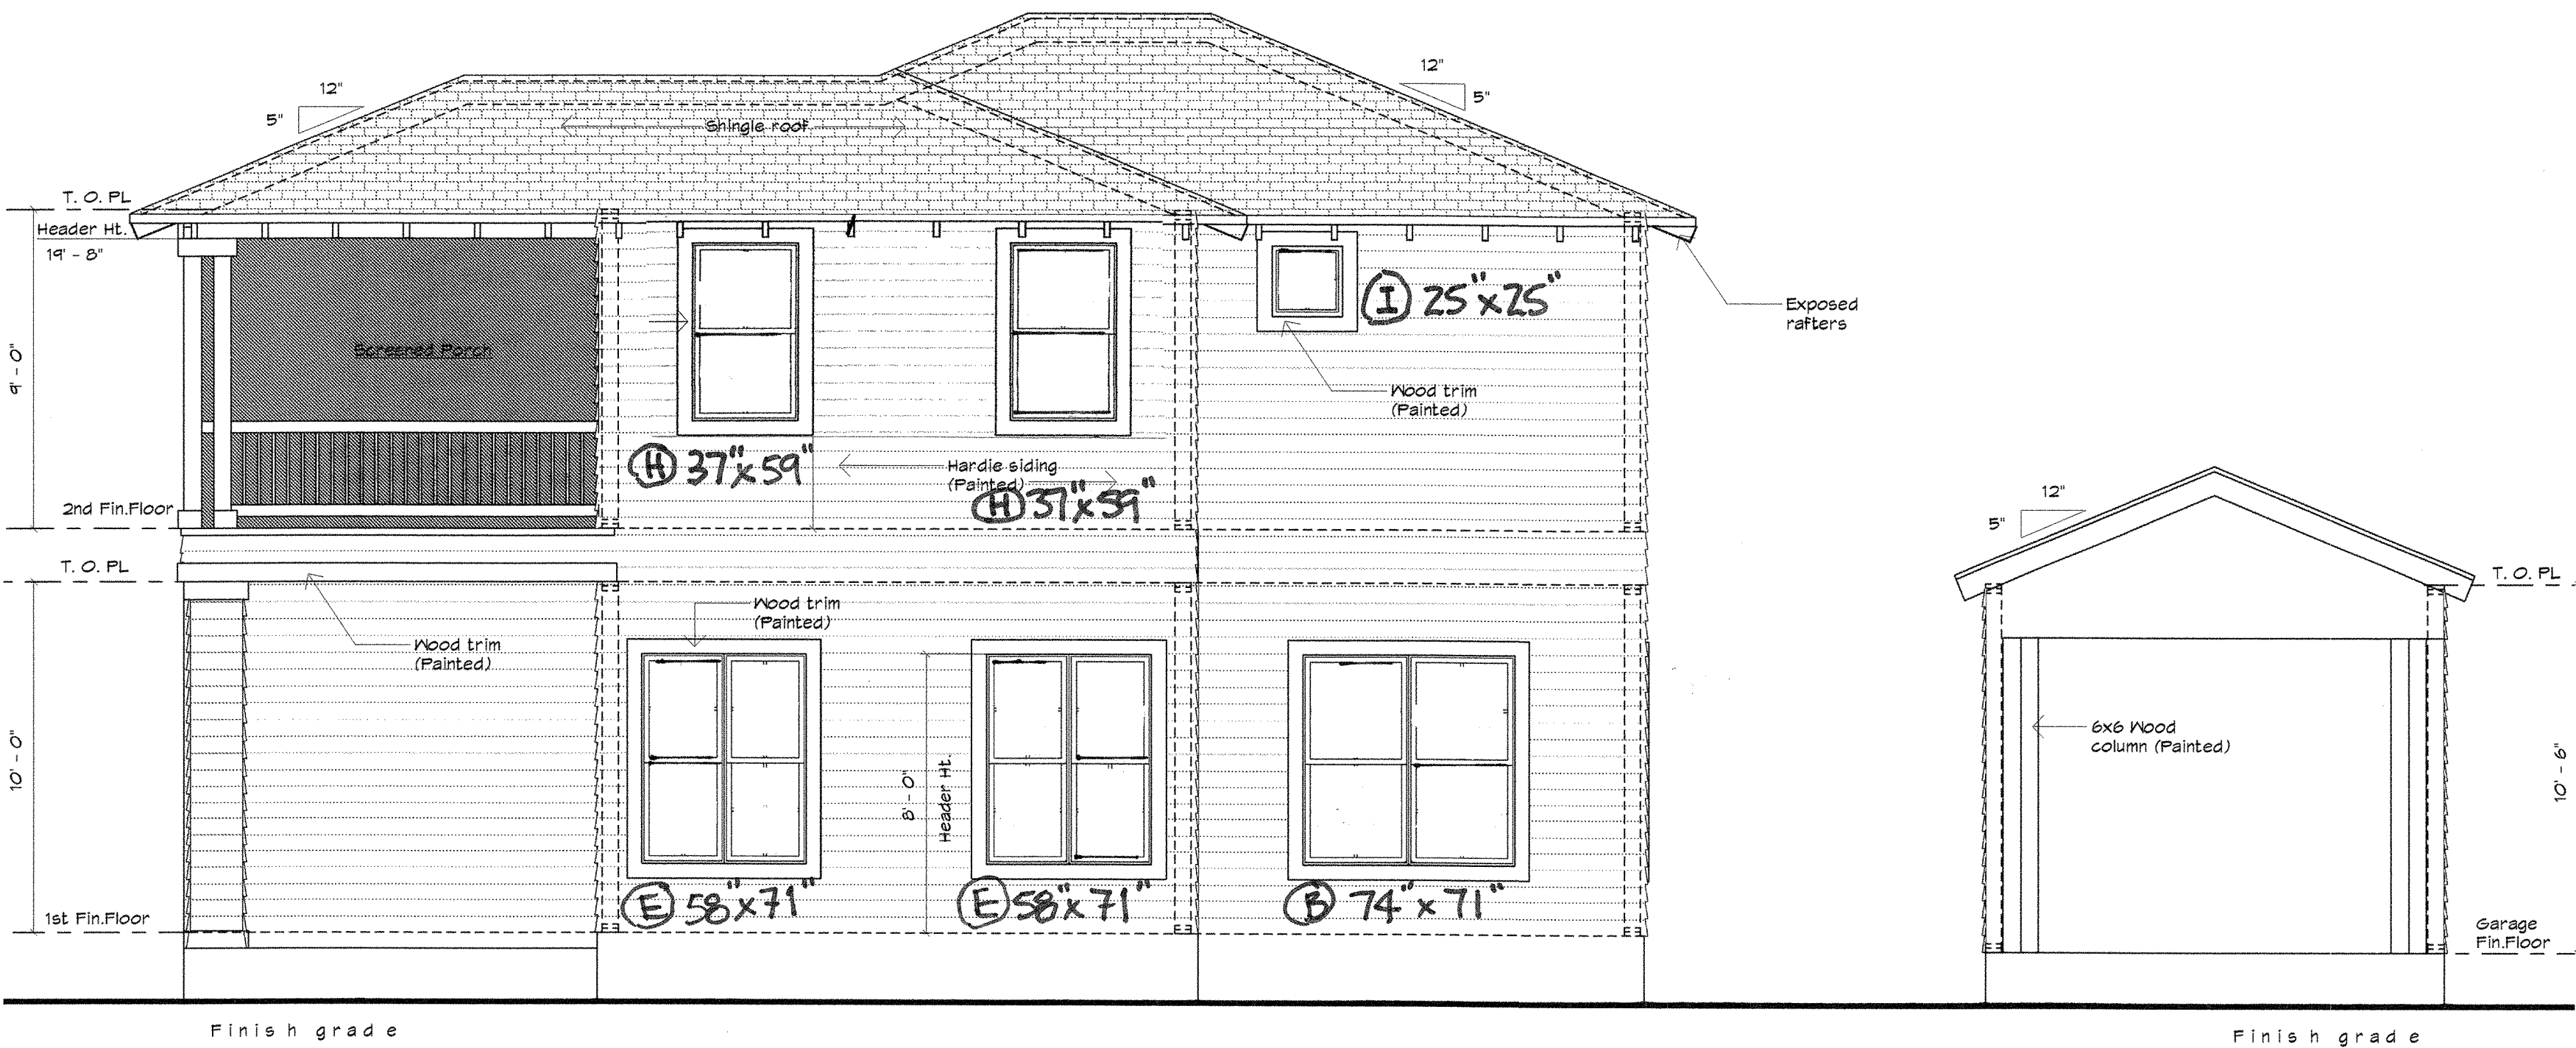


4 Right Elevation  
1/4" = 1'-0"

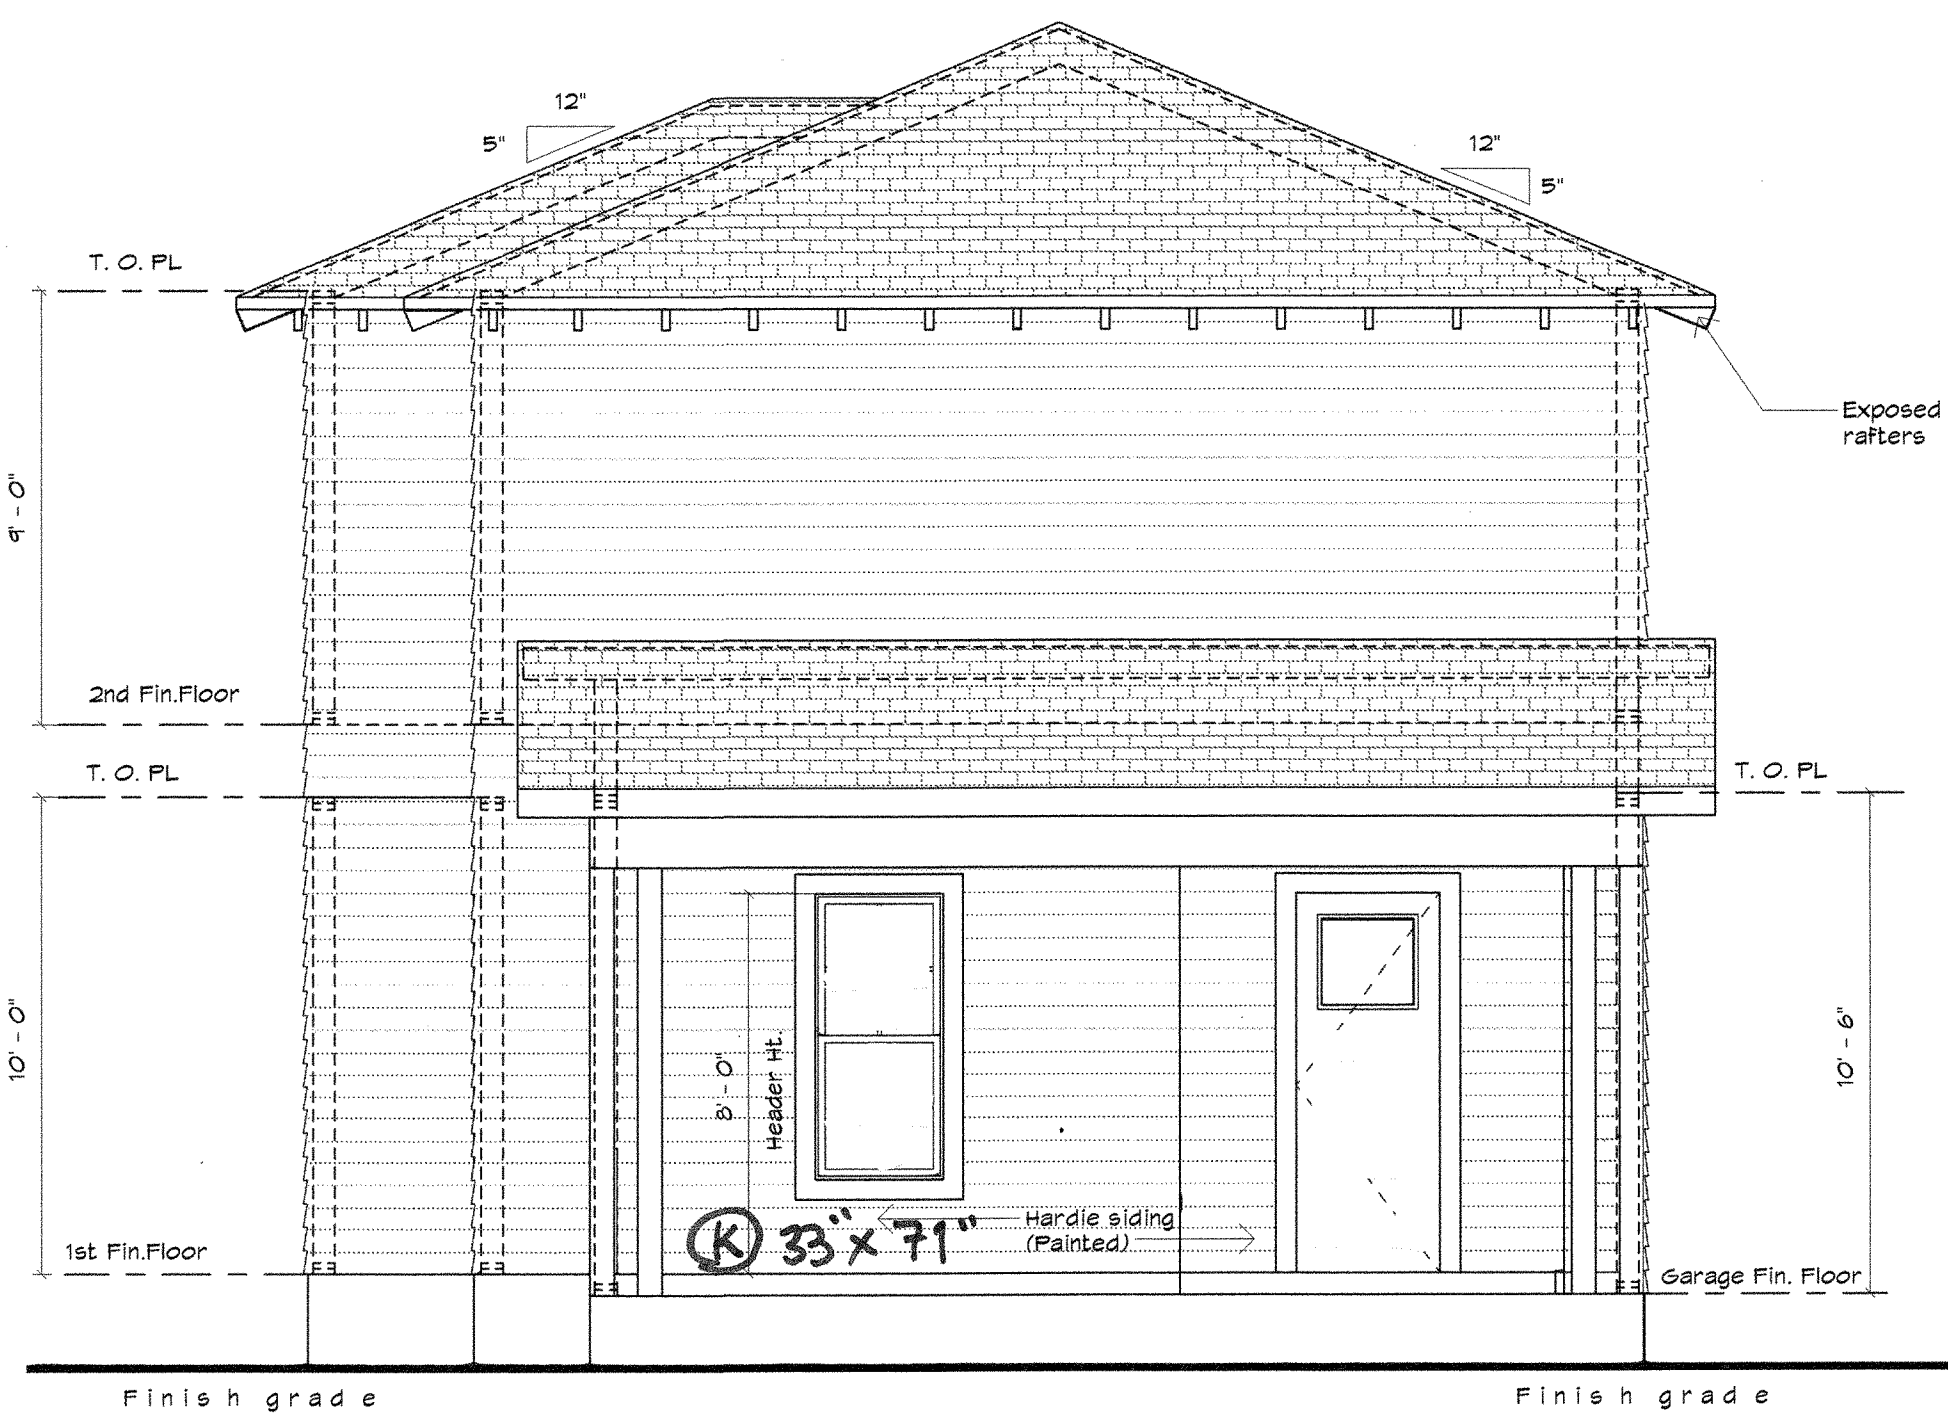

3 Rear Elevation  
1/4" = 1'-0"




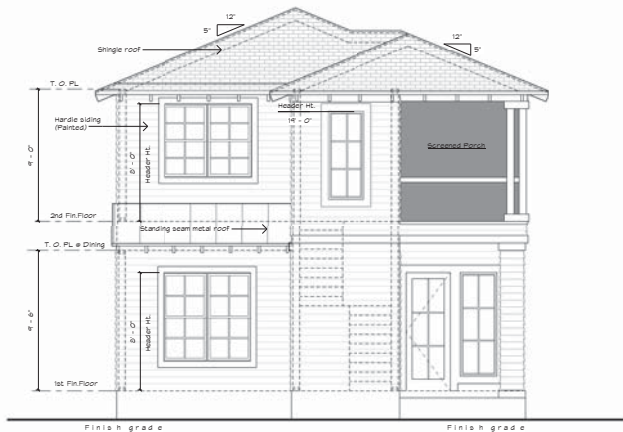

# 1 Building 1 Front elevation

1/4" = 1'-0"



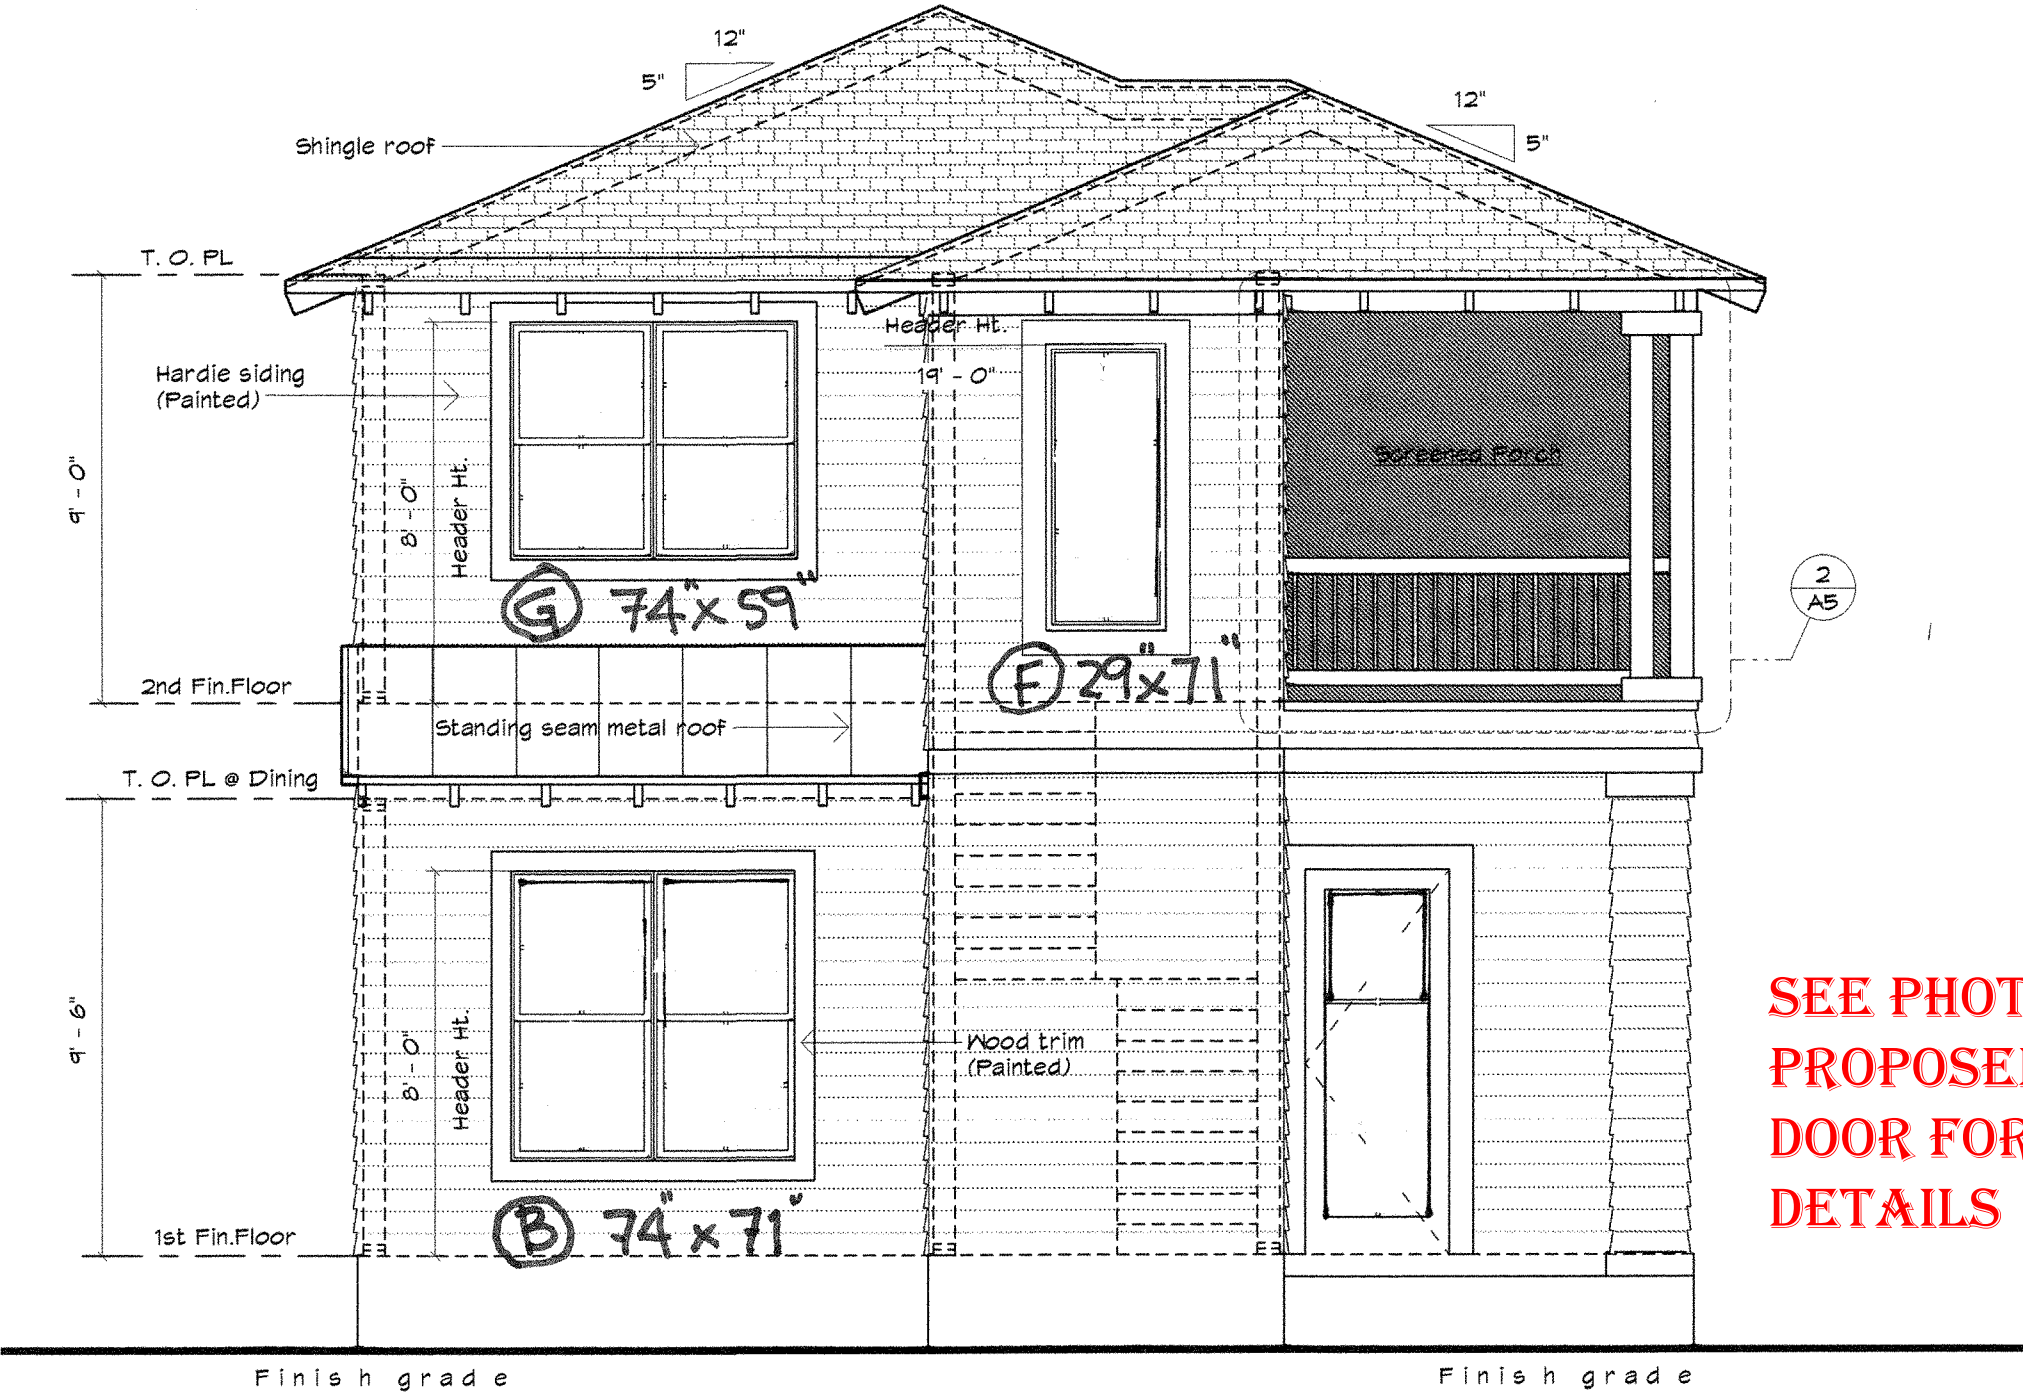

SEE PHOTO OF  
PROPOSED  
DOOR FOR  
DETAILS

1 Front Elevation  
1/4" = 1'-0"


**From:** Carlos Rodriguez <[crrtx@yahoo.com](mailto:crrtx@yahoo.com)>

**Date:** January 3, 2017 at 4:00:37 PM CST

**To:** [crrtx@yahoo.com](mailto:crrtx@yahoo.com)

**Subject:** Photos Dawson 608/610



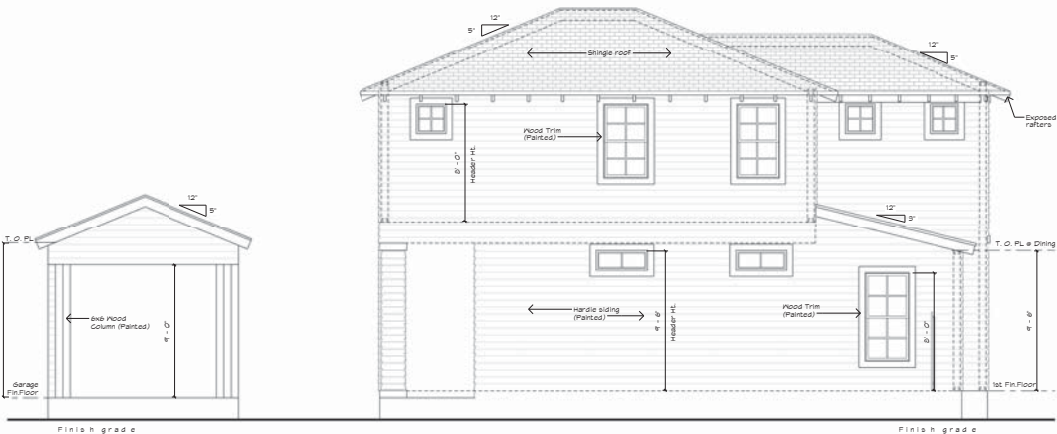

2 Building 1 Left Elevation  
1/4" = 1'-0"



AS-BUILT/610


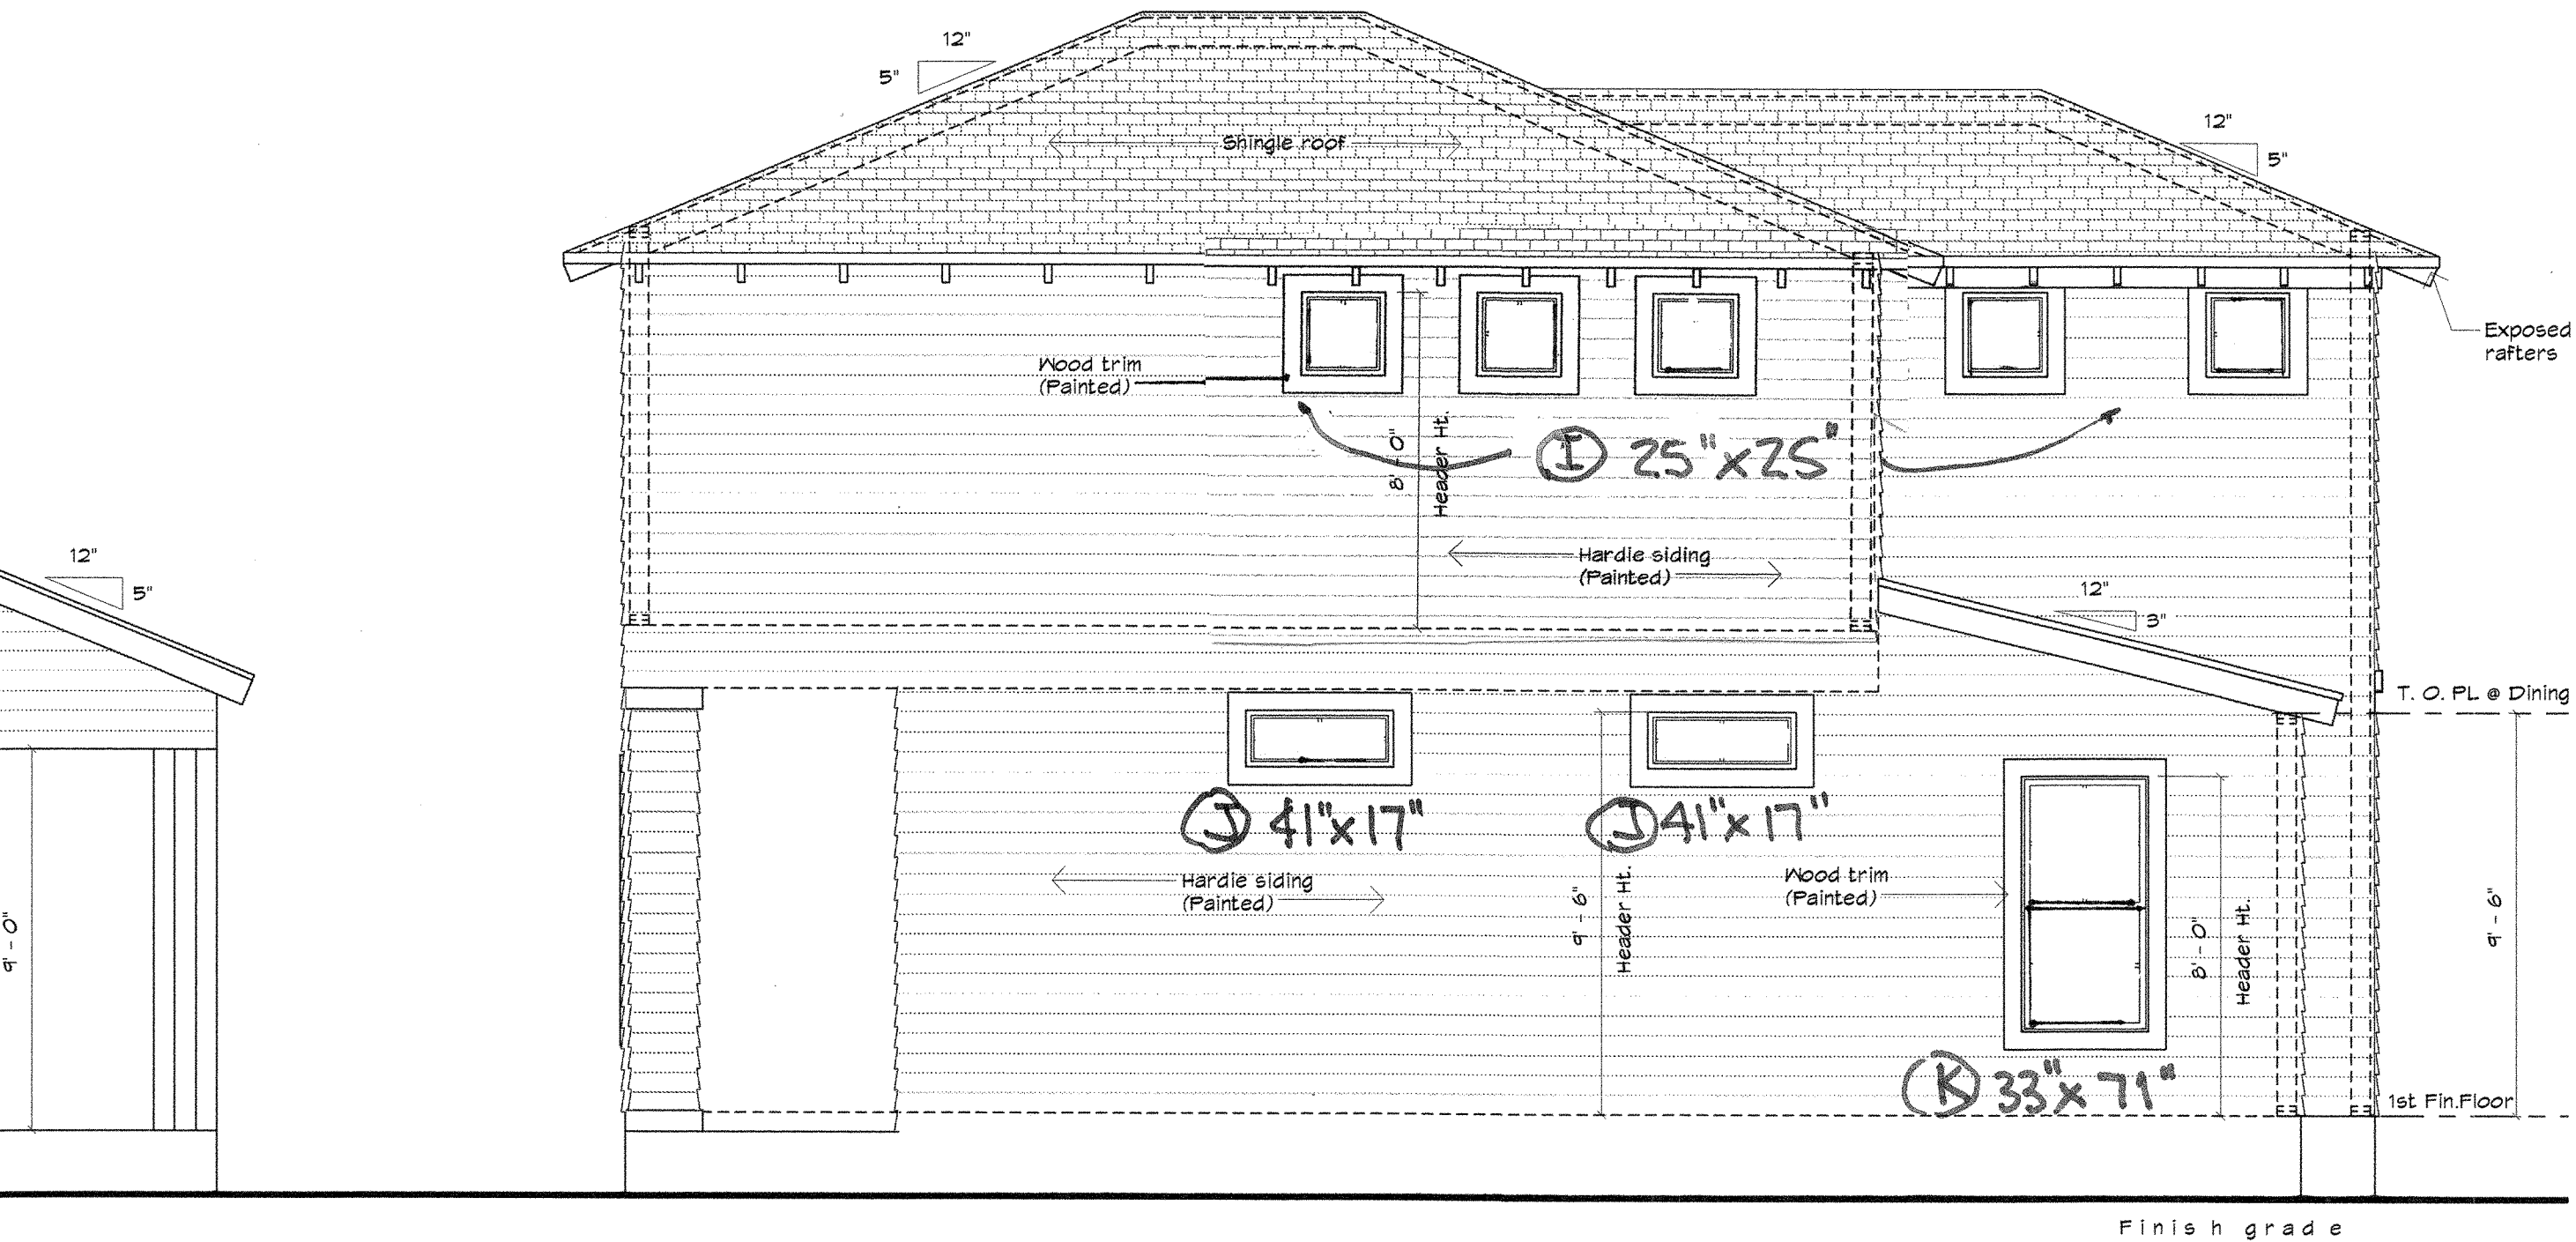




Photo #4  
East partial elevation



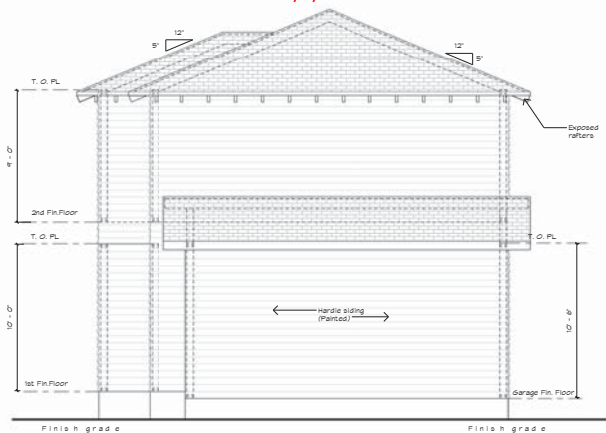


3 Building 1 Rear Elevation  
1/4" = 1'-0"

CARPORT




BUILDING REAR ELEVATION

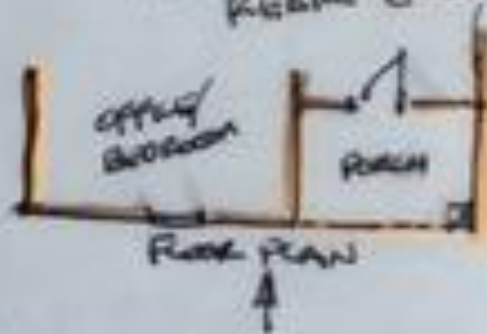

DRAWING PLACE

NOTE: REVERSE OF BUILDING IS LEFT ELEVATION

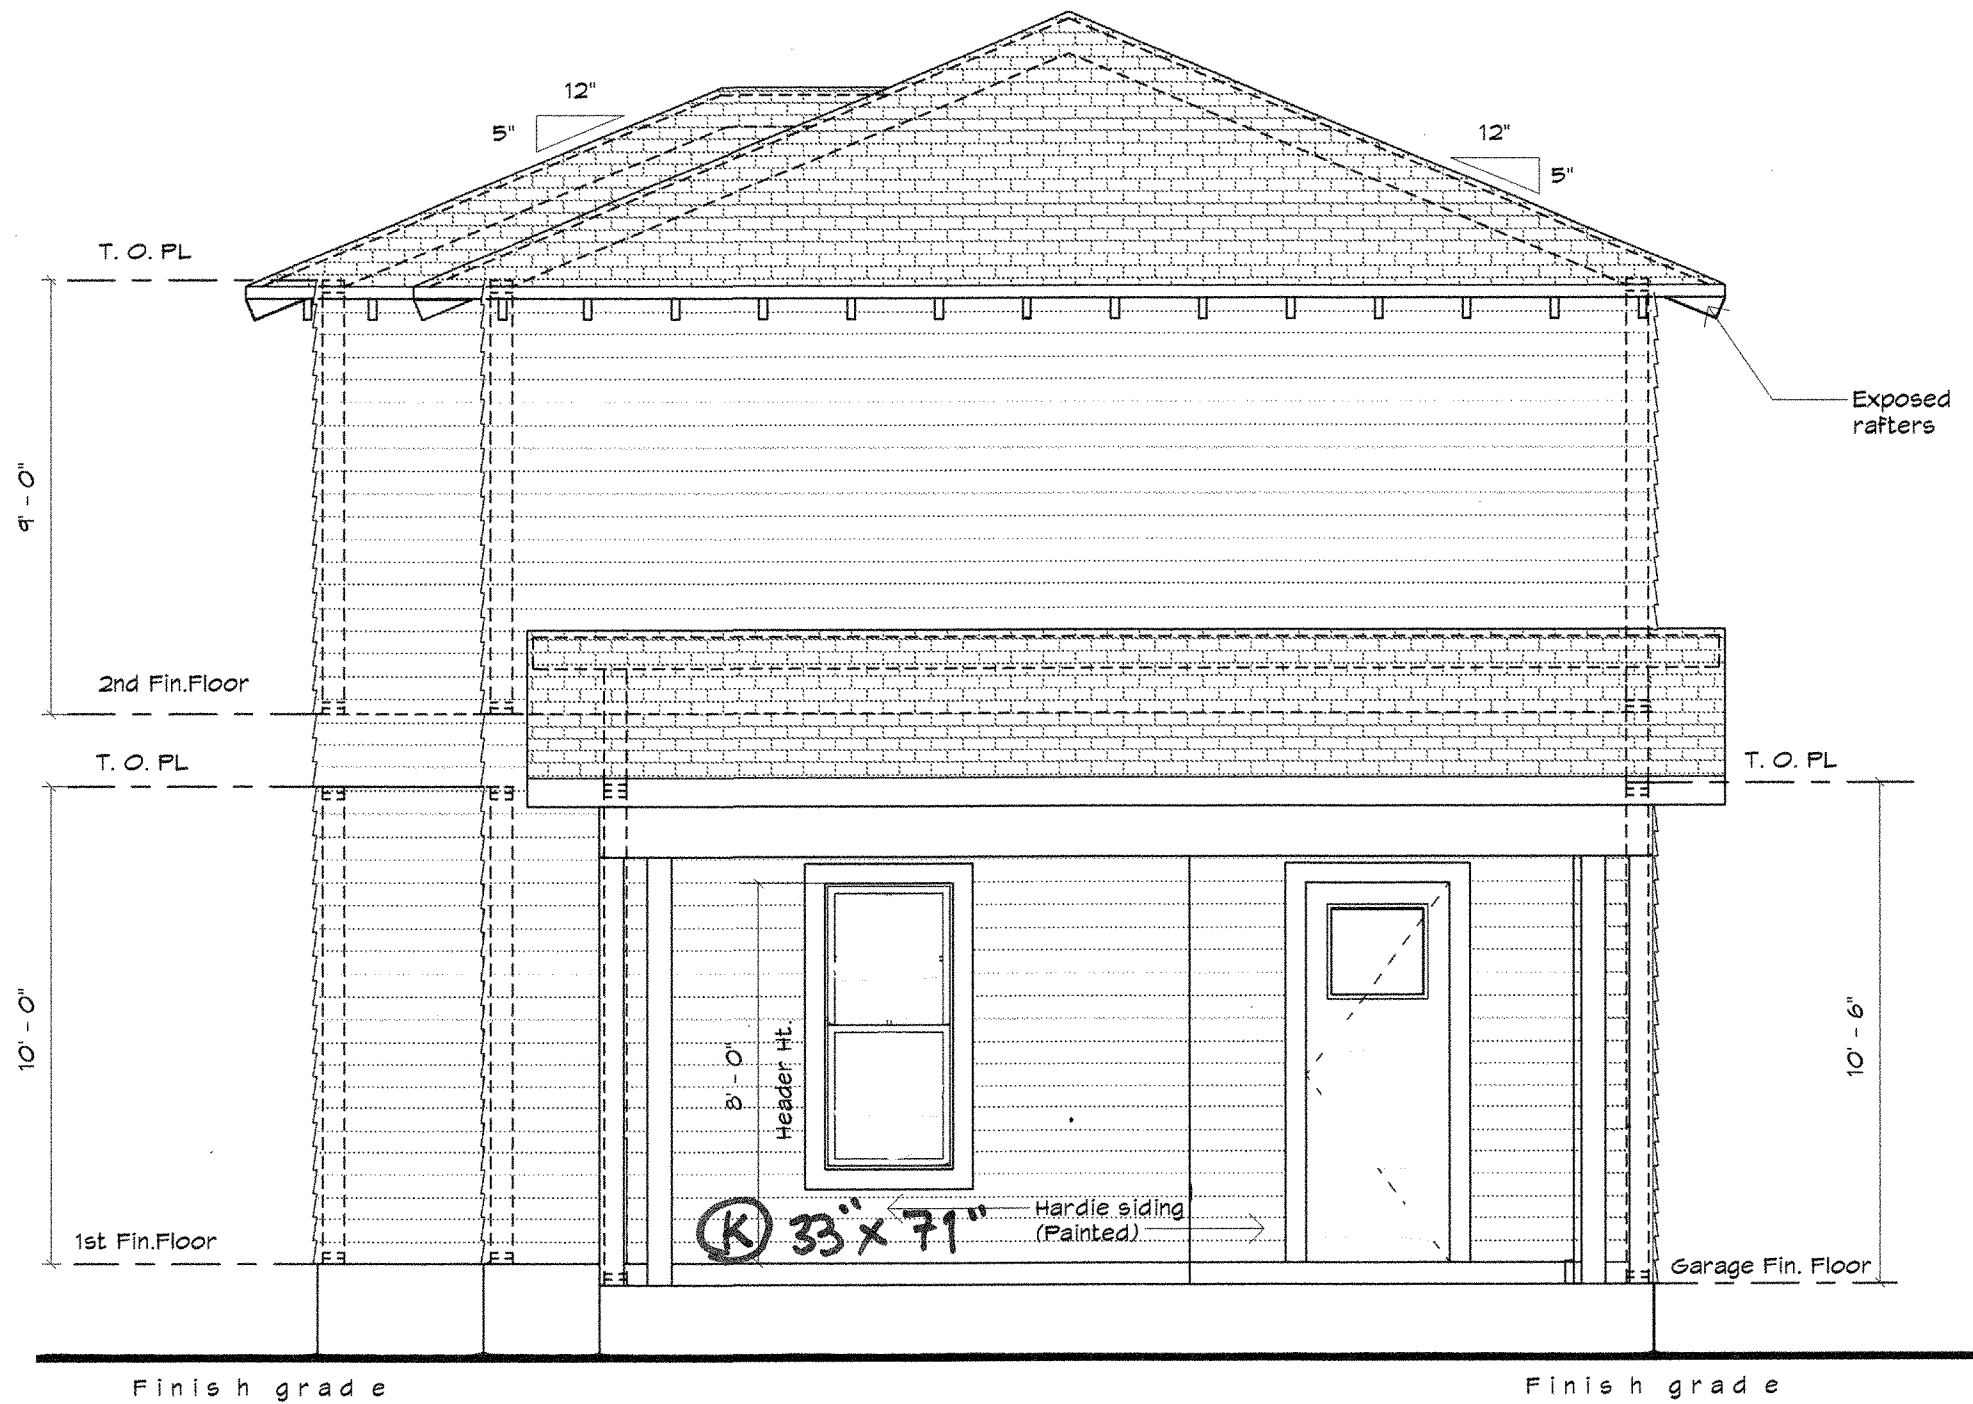

3 Rear Elevation  
1/4" = 1'-0"





Photo#3  
South elevation/610



1. THESE COPYRIGHTED PLANS AND RELATED DETAILS ARE DRAWN EXCLUSIVELY FOR THE USE OF VALDEZDESIGNS, INC.
  2. THESE PLANS AND RELATED DETAILS ARE THE LEGAL PROPERTY OF VALDEZDESIGNS, INC. LOCATED IN SAN ANTONIO, TEXAS.
  3. VALDEZDESIGNS, INC. HOLDS THE EXCLUSIVE RIGHT OF DISTRIBUTION.
  4. THE DRAWINGS BEING REPRESENTED MAY NOT BE COPIED IN FULL OR IN PART WITHOUT PRIOR WRITTEN PERMISSION GRANTED BY VALDEZDESIGNS, INC.
- VALDEZDESIGNS, Inc.  
San Antonio, Texas  
Voice (210) 618-1294

BRIGHTSTAR  
DEVELOPMENT LLC.  
210.882.2038

DIGNOWITY HILL  
608 Dawson St  
SAN ANTONIO TX  
COUNTY BLOCK: 17  
LOT: 19

Plan Information:

Drawn By: JV RB  
Project #: 1110  
Copyright: 2016

Revisions:

- |   |            |
|---|------------|
| 1 | 07-14-2016 |
| 2 |            |


Issue Date:

07-14-2016


Sheet Title & No.

EXTERIOR  
ELEVATIONS

A4

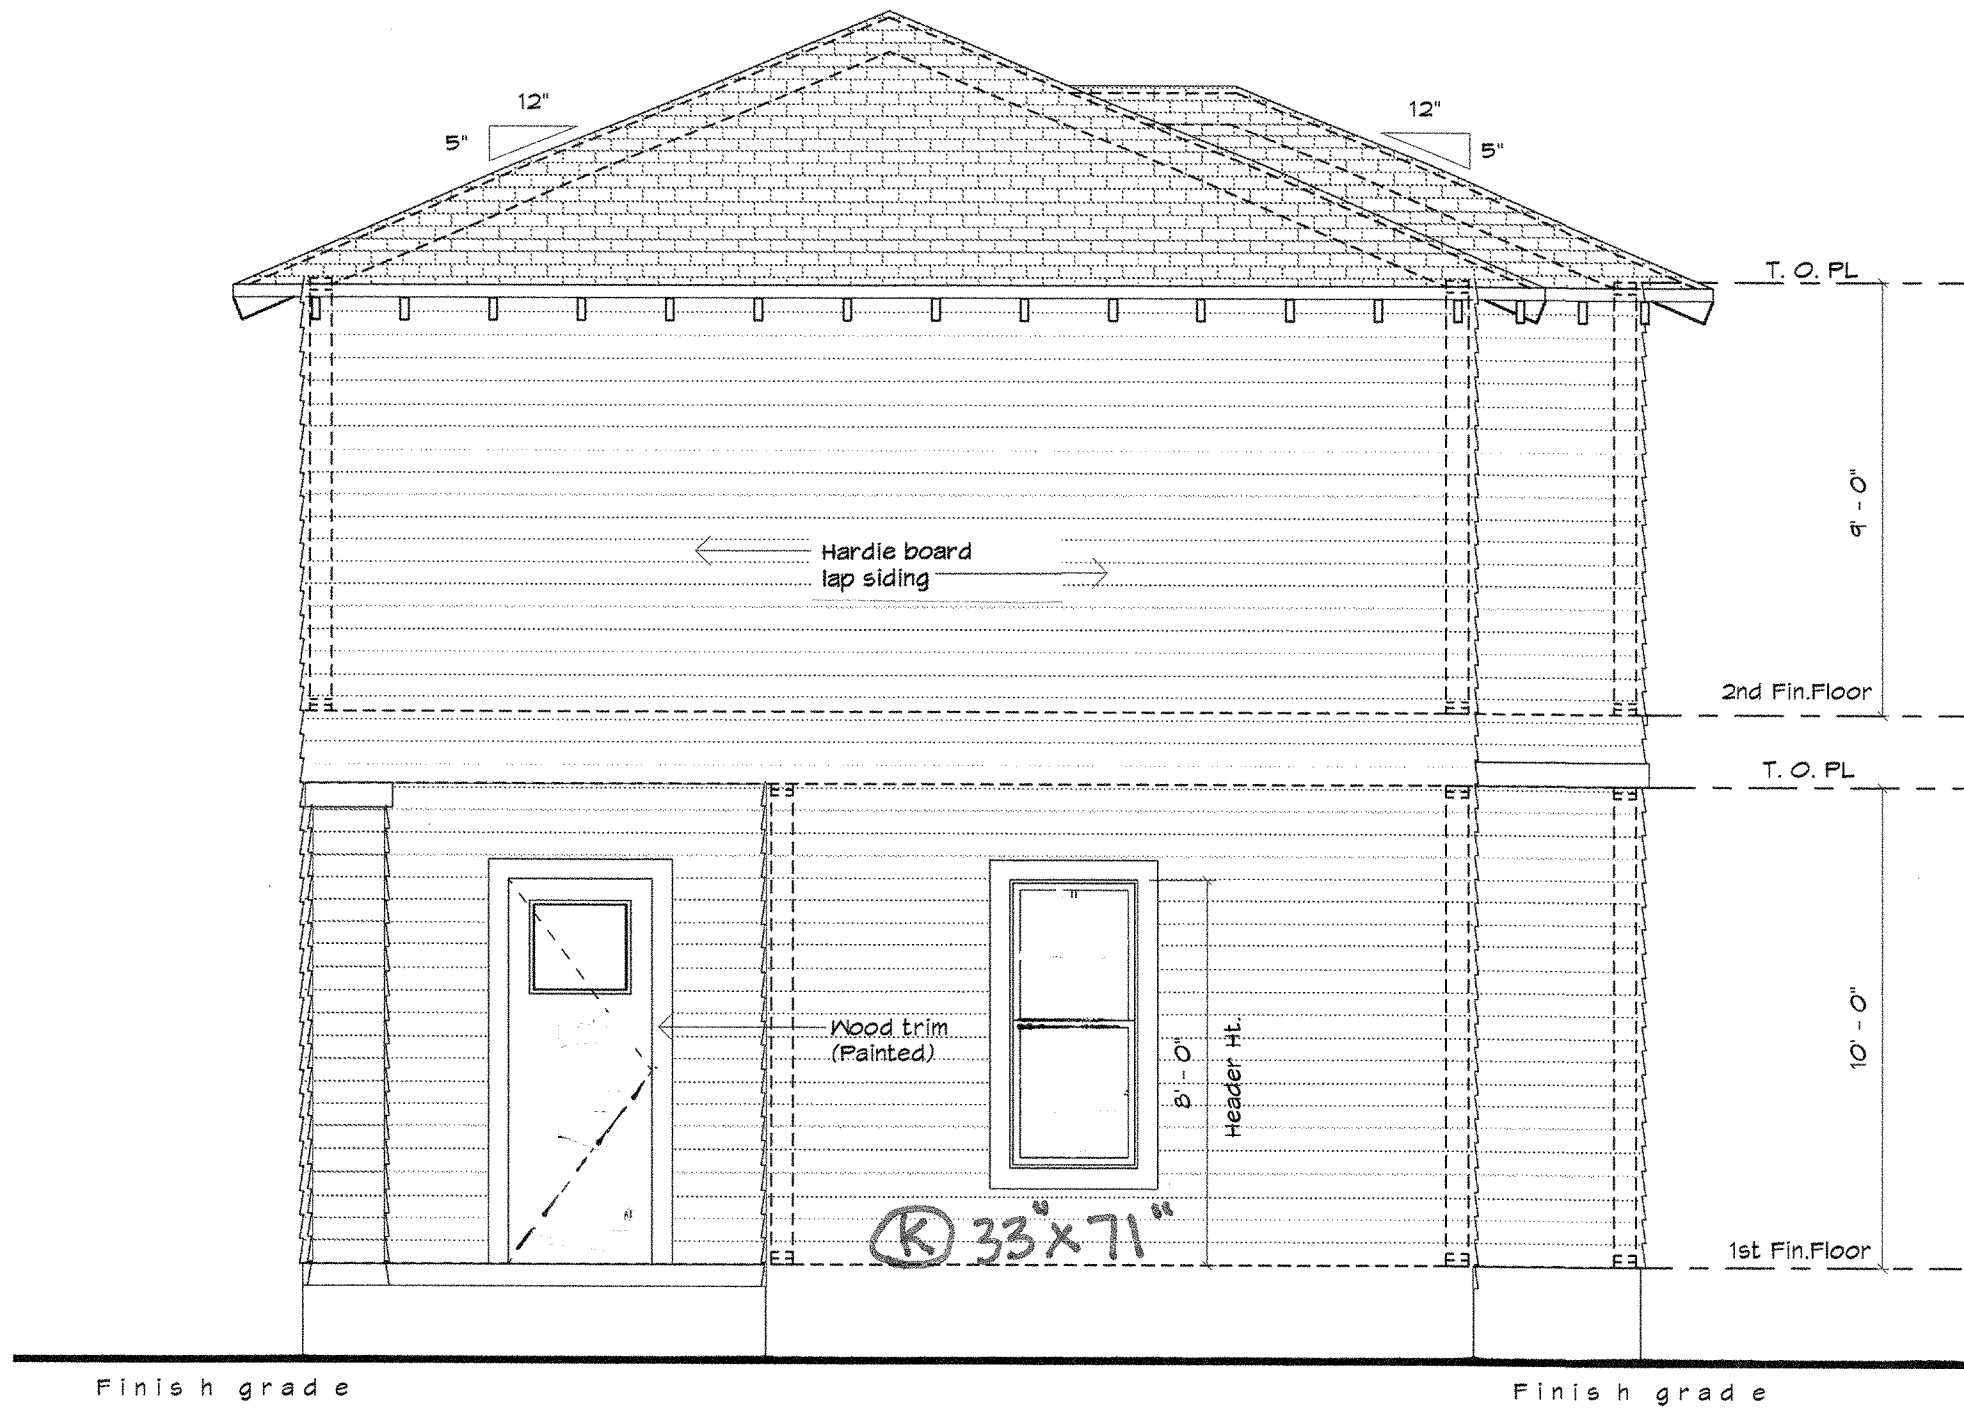


2 Left Elevation  
1/4" = 1'-0"

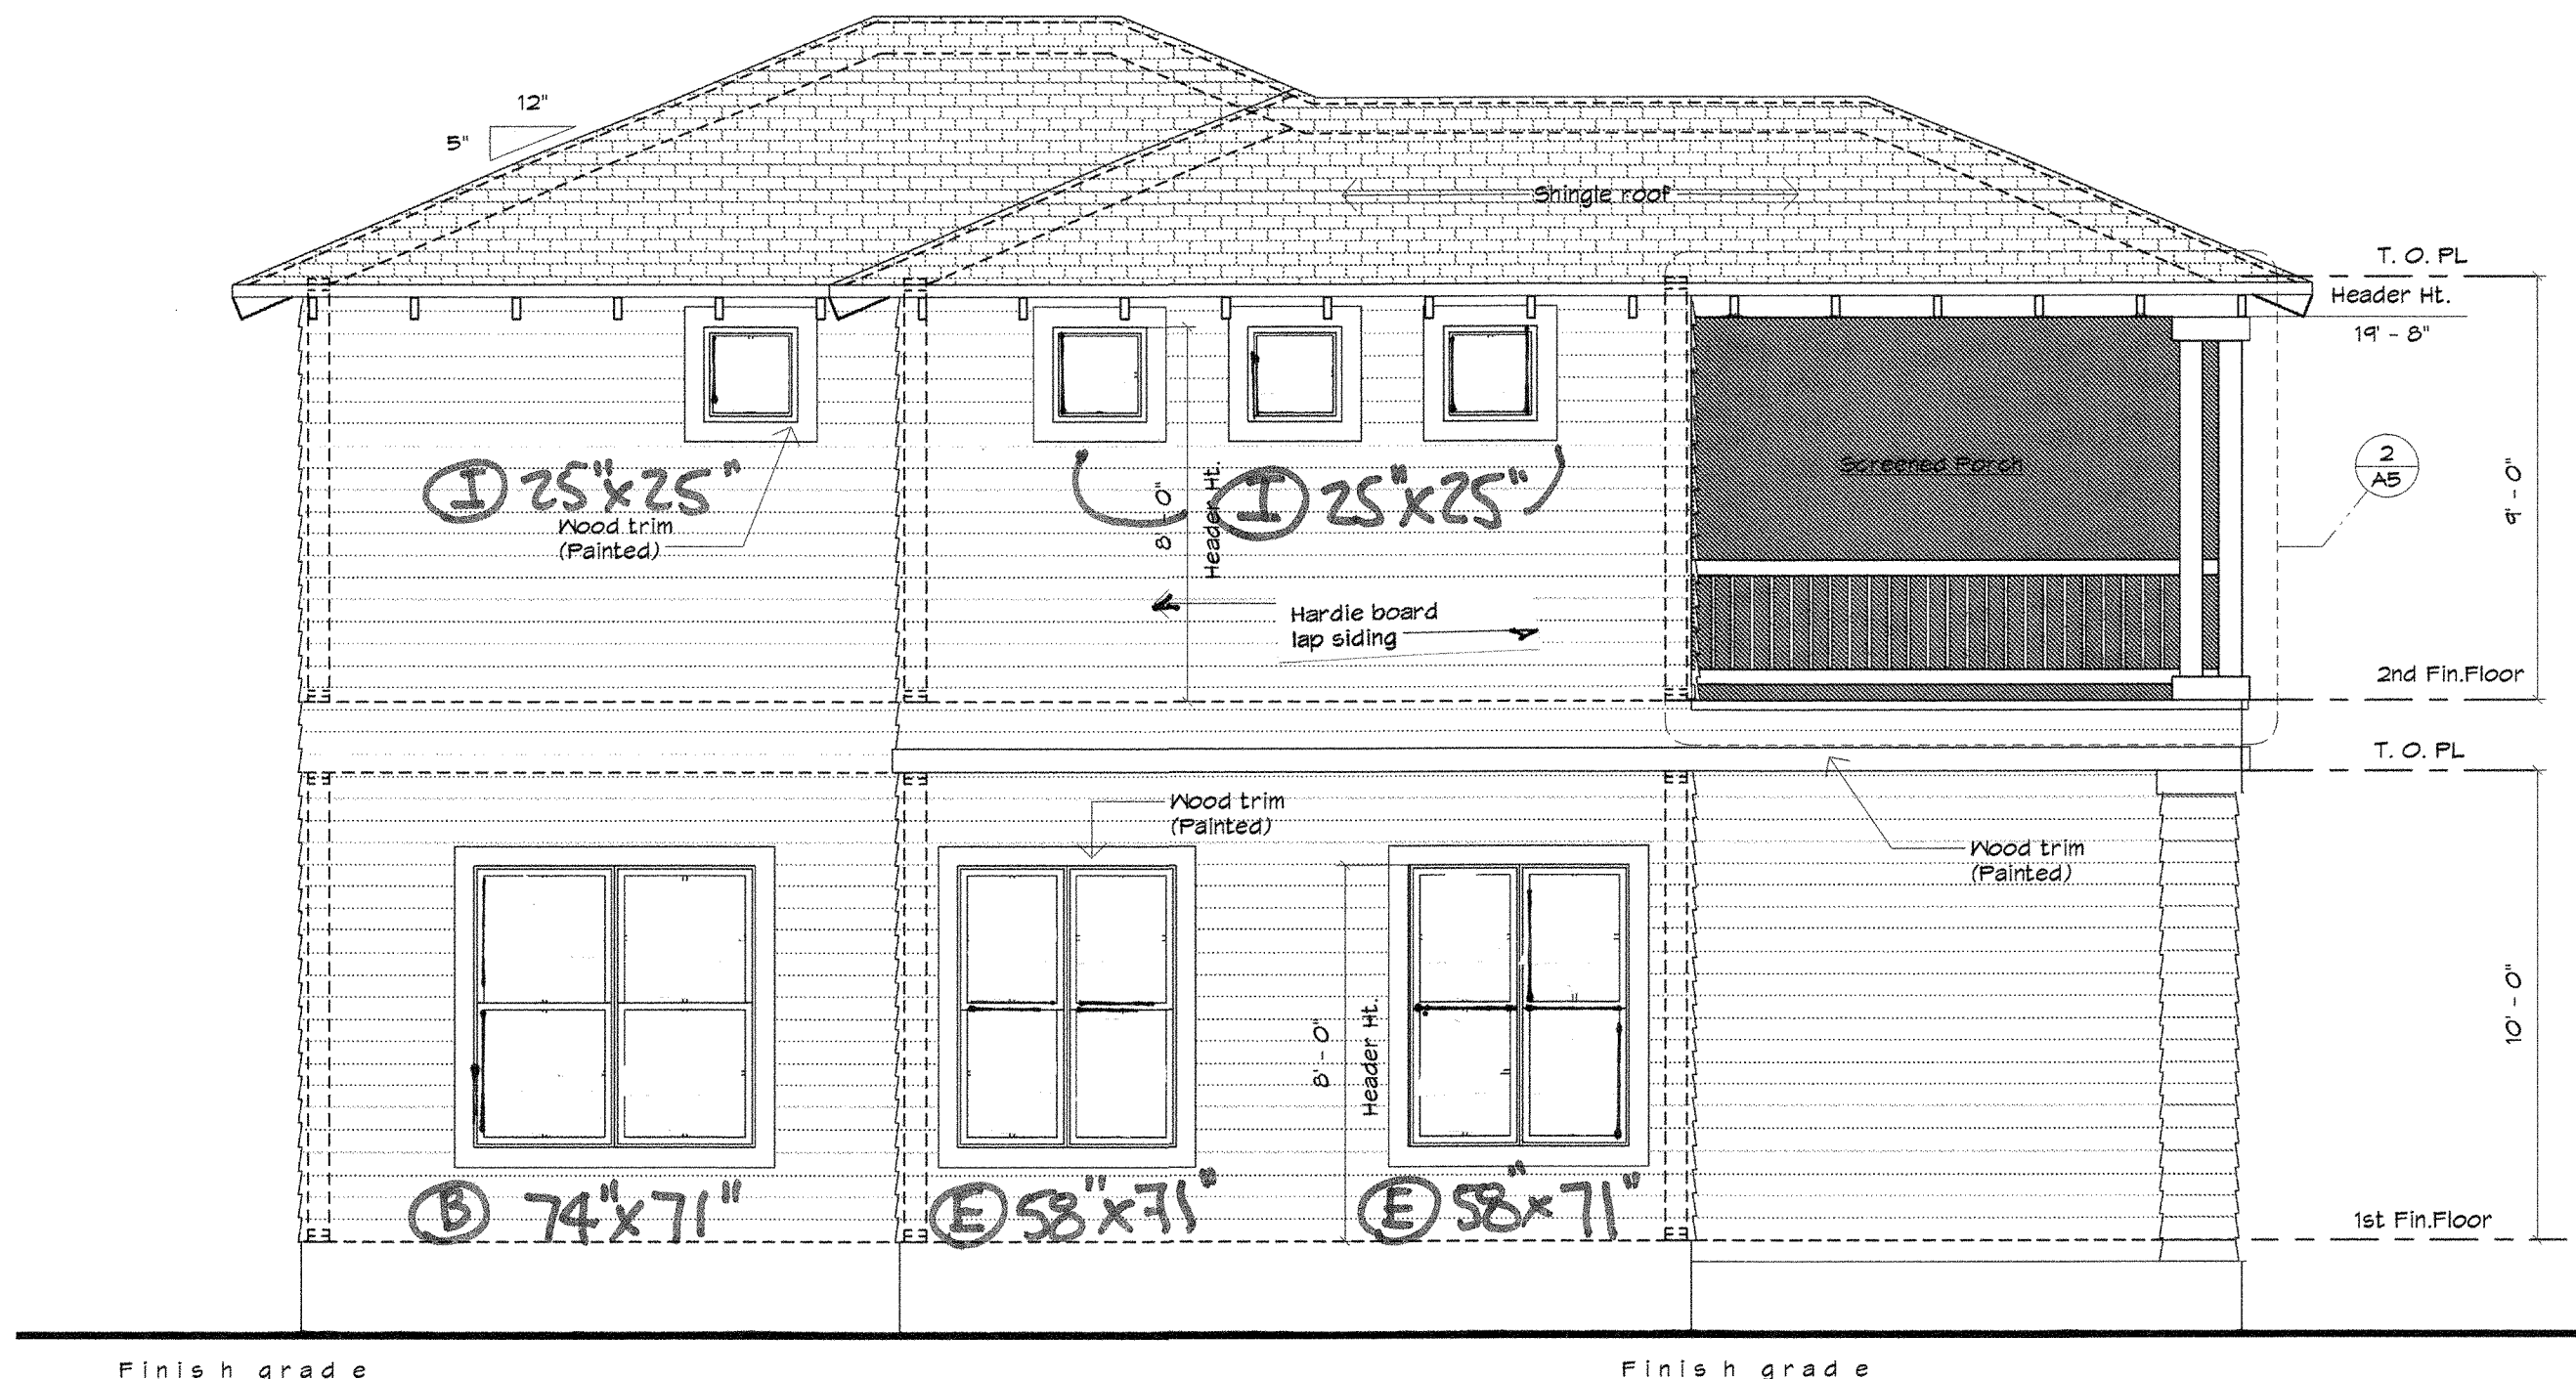

1 Front Elevation  
1/4" = 1'-0"




4 Right Elevation  
1/4" = 1'-0"

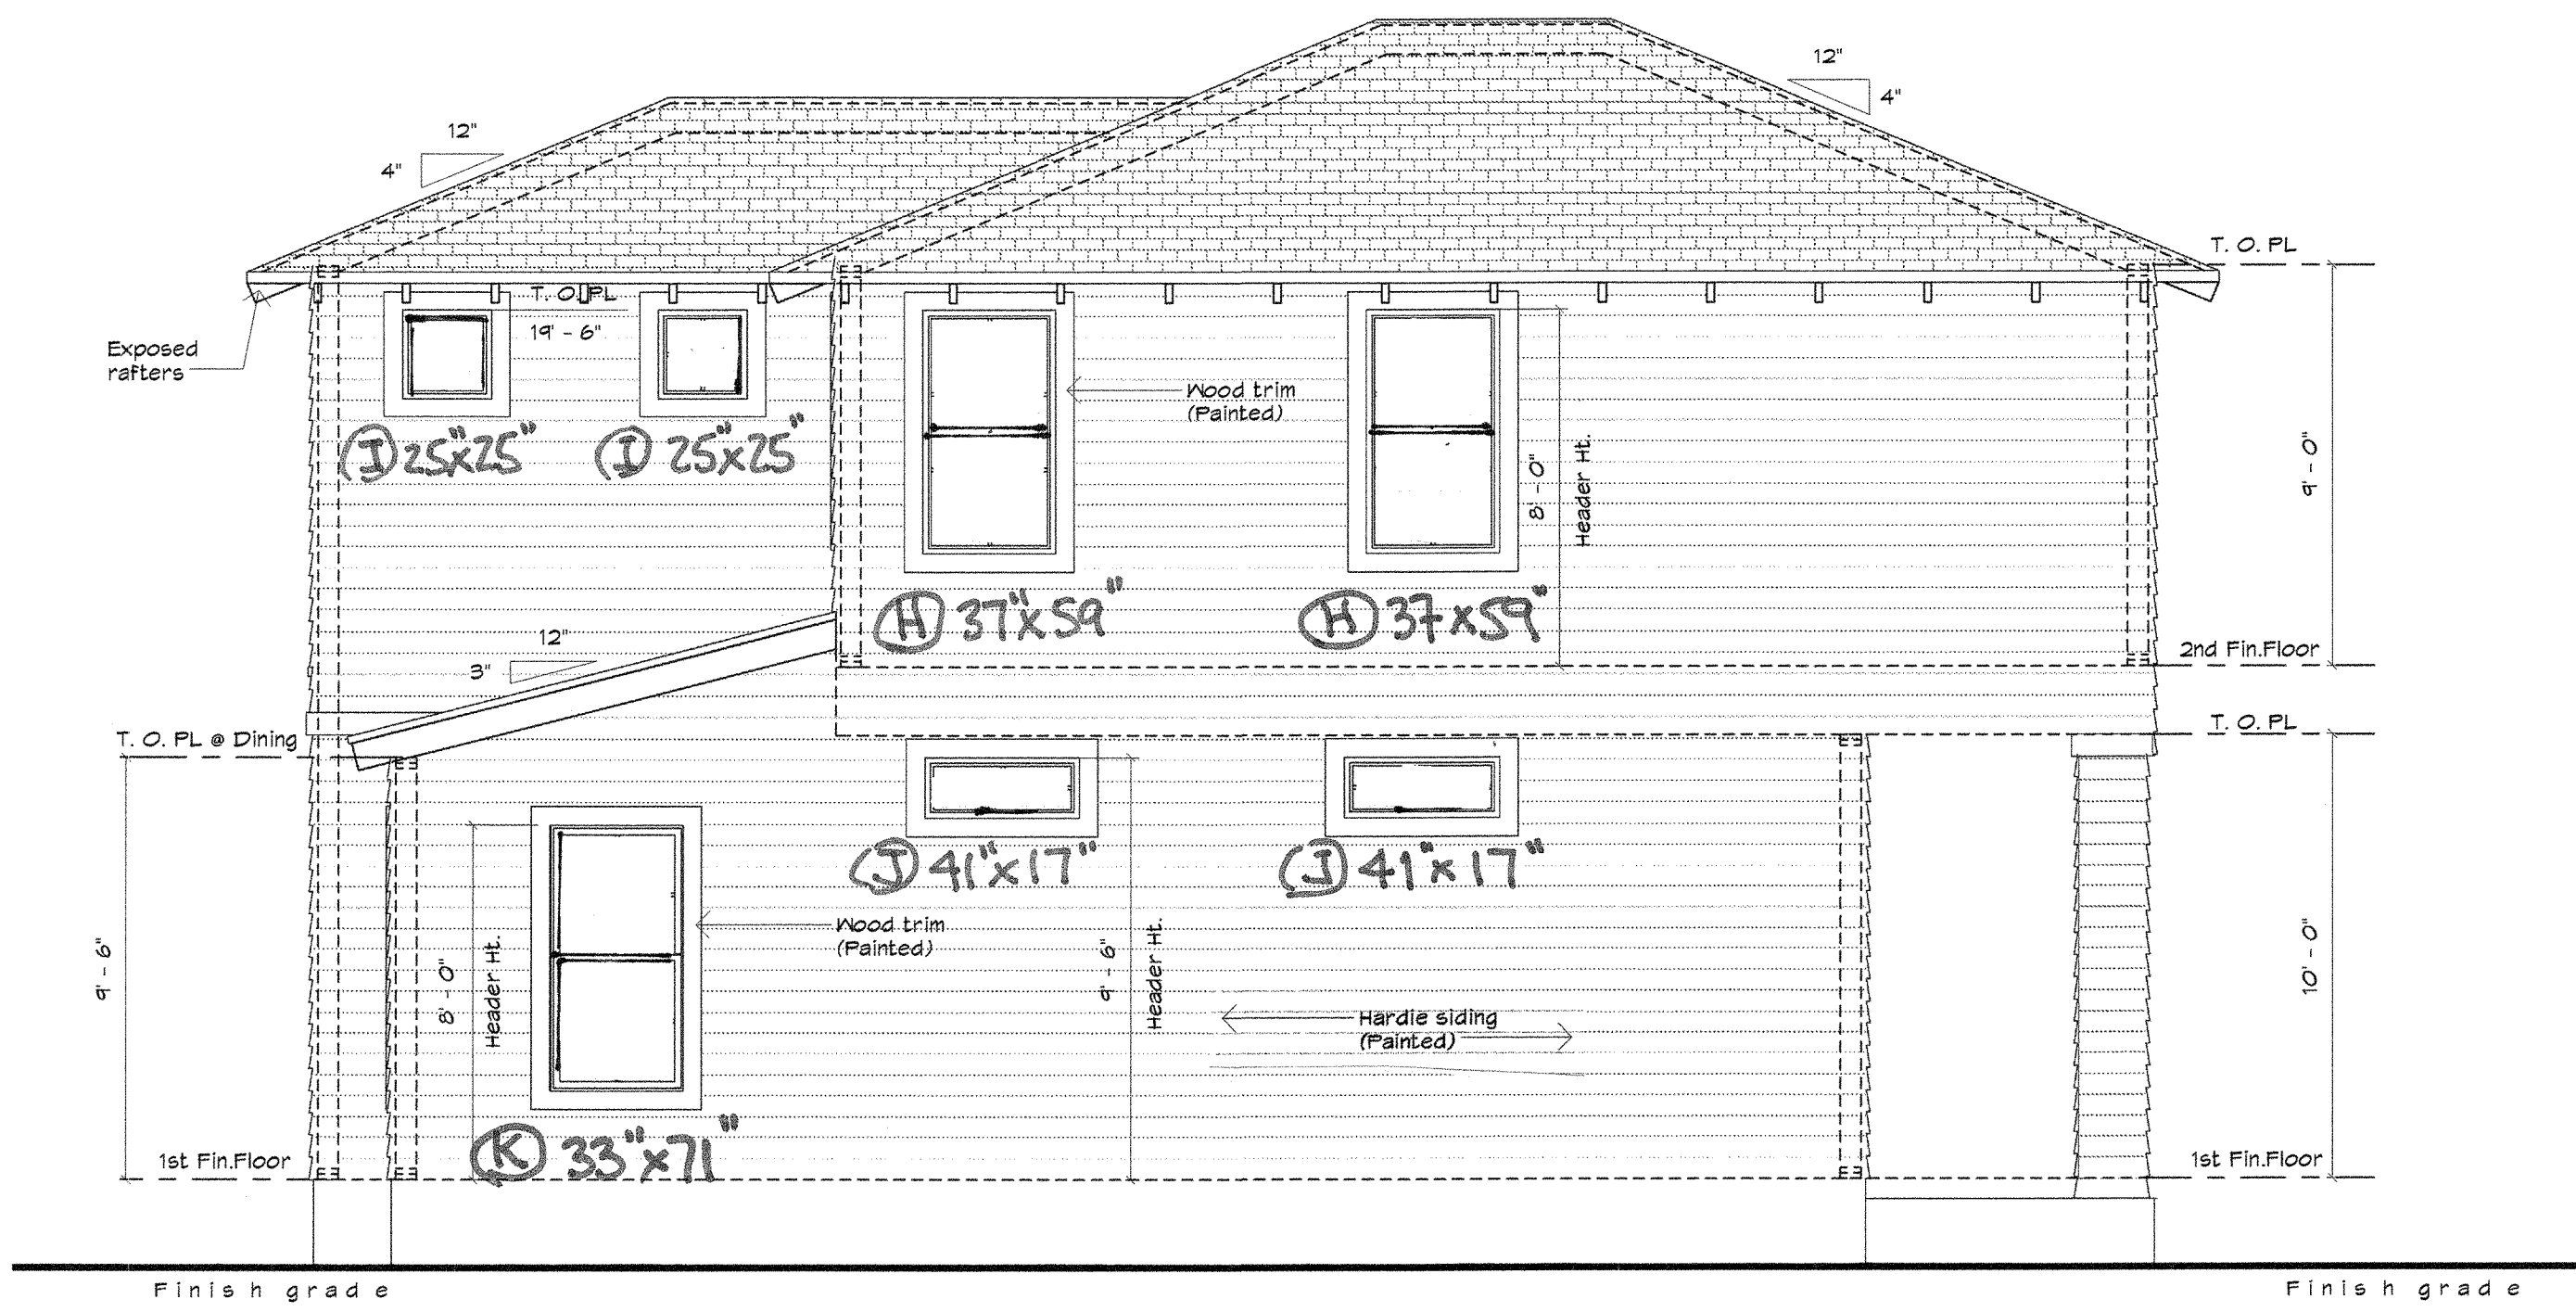


3 Rear Elevation  
1/4" = 1'-0"



# ELEVATIONS APPROVED BY HDRC / /16

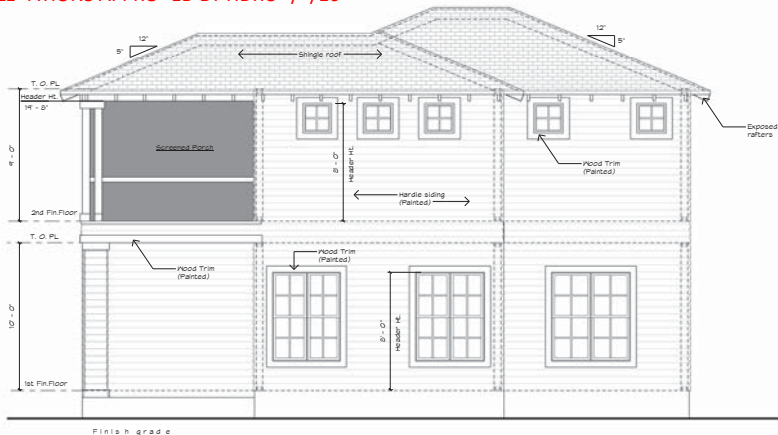



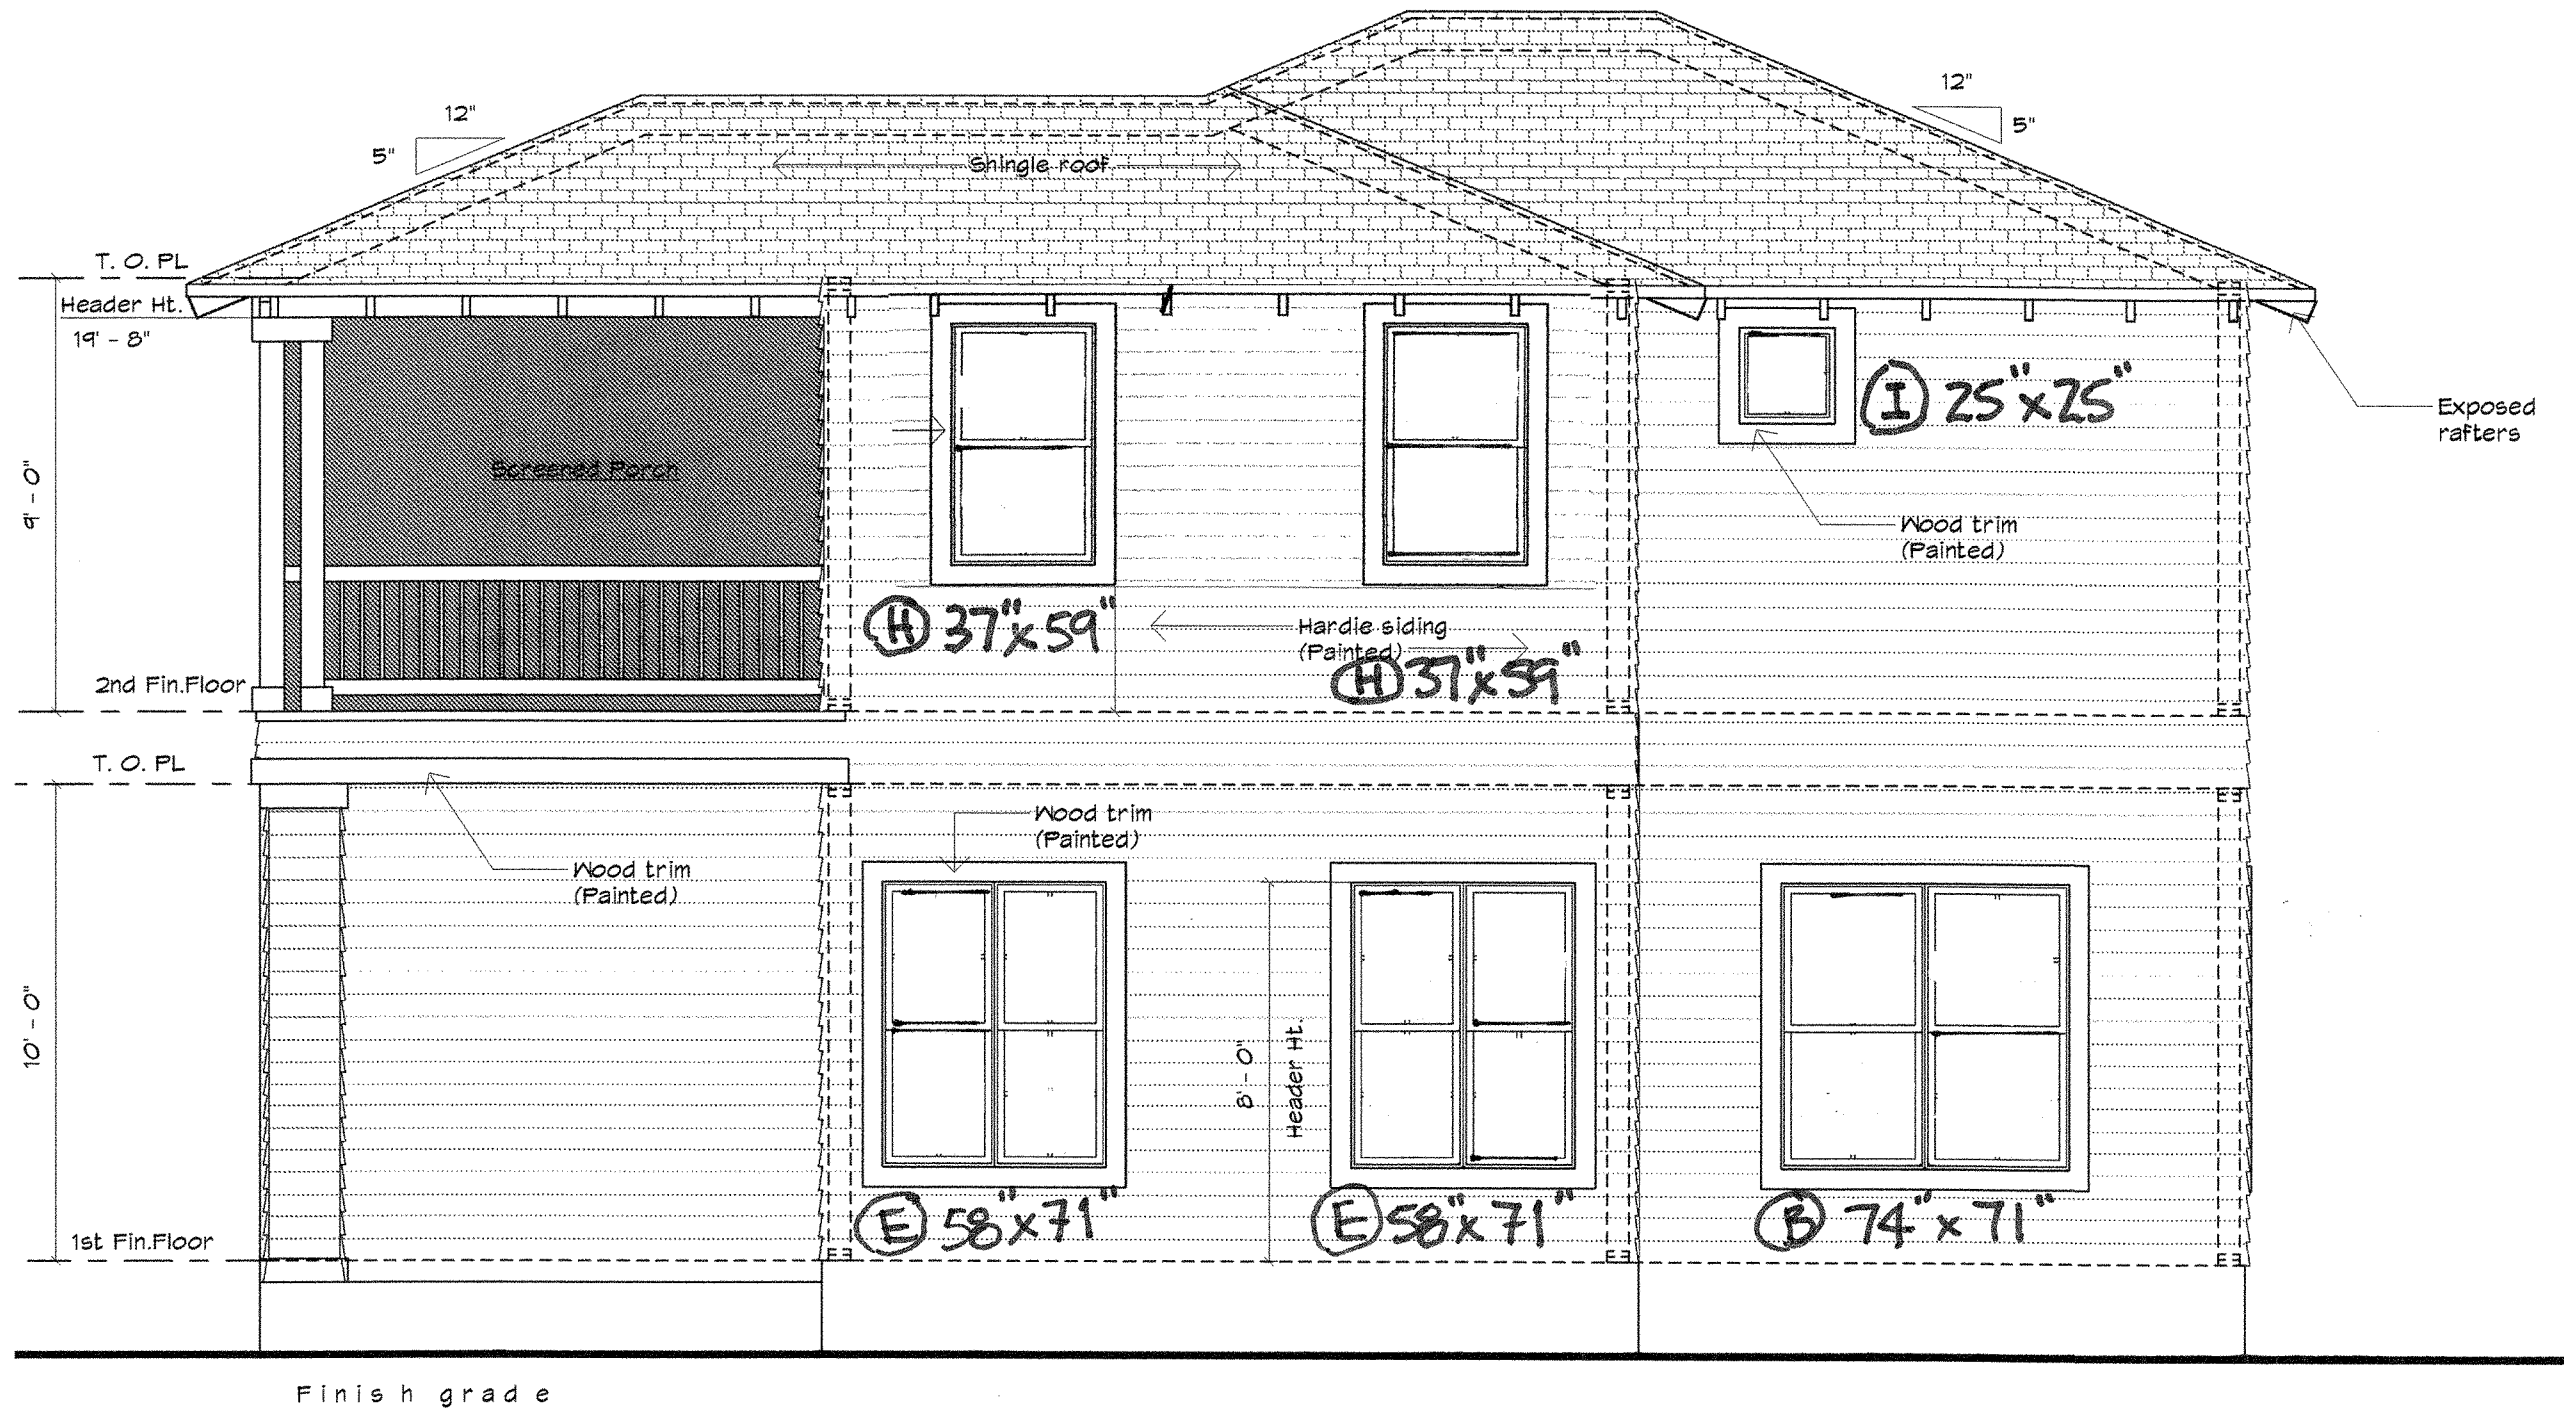

4 Right Elevation  
1/4" = 1'-0"

Photo#1  
North elevation/610



Photo #2  
West elevation/ 610

ELEVATIONS APPROVED BY HDRC / 1/16  
BUILDING 2 - 6 DAWSON



Legal Notice of Copyright:

1. THESE COPYRIGHTED PLANS AND RELATED DETAILS ARE DRAWN EXCLUSIVELY FOR THE USE OF VALDEZDESIGNS, INC.
2. THESE PLANS AND RELATED DETAILS ARE THE LEGAL PROPERTY OF VALDEZDESIGNS, INC. LOCATED IN SAN ANTONIO, TEXAS.
3. VALDEZDESIGNS, INC. HOLDS THE EXCLUSIVE RIGHT OF DISTRIBUTION.
4. THE DRAWINGS BEING REPRESENTED MAY NOT BE COPIED IN FULL OR IN PART WITHOUT PRIOR WRITTEN PERMISSION GRANTED BY VALDEZDESIGNS, INC.

VALDEZDESIGNS, INC.  
SAN ANTONIO, TEXAS  
VOICE (210) 810-1234

BRIGHTSTAR  
DEVELOPMENT LLC.  
210.882.2038

DIGNOWITY HILL  
610 DAWSON ST.  
SAN ANTONIO TX  
LOT: 3  
COUNTY BLOCK: 17

Plan Information:

Drawn By: JV RB

Project #: 1110

Copyright: 2016

Revisions:

1

2


Issue Date:

04-07-2016


Sheet Title & No.

EXTERIOR  
ELEVATIONS


A6

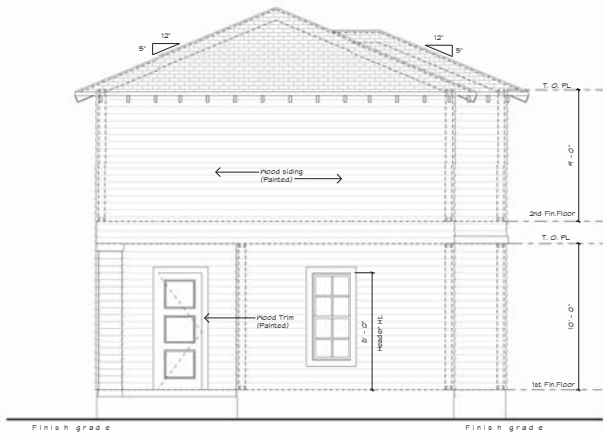


2 Building 2 Left Elevation  
1/4" = 1'-0"

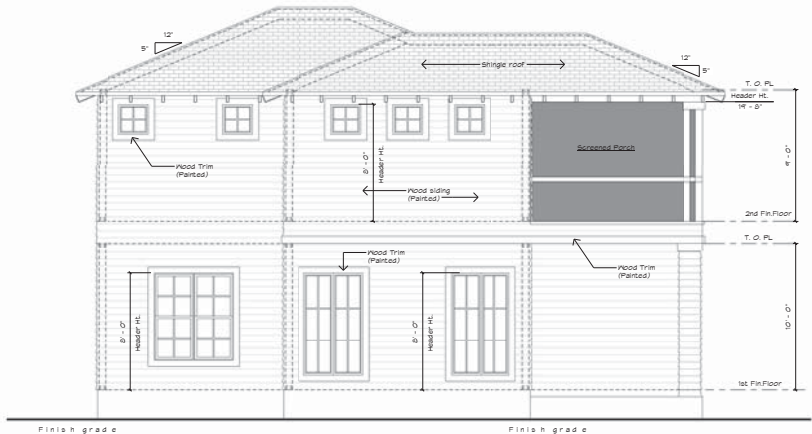

1 Building 2 Front Elevation  
1/4" = 1'-0"

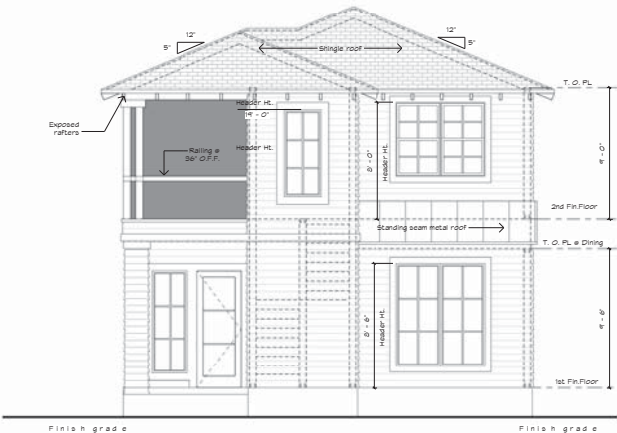

4 Building 2 Right Elevation  
1/4" = 1'-0"

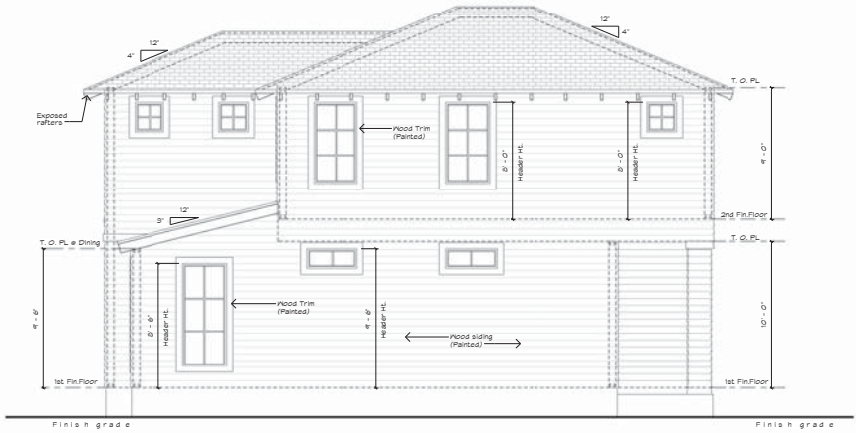

3 Building 2 Rear Elevation  
1/4" = 1'-0"





Legal Notice of Copyright:

1. THESE COPYRIGHTED PLANS AND RELATED DETAILS ARE DRAWN EXCLUSIVELY FOR THE USE OF VALDEZDESIGNS, INC.
  2. THESE PLANS AND RELATED DETAILS ARE THE LEGAL PROPERTY OF VALDEZDESIGNS, INC. LOCATED IN SAN ANTONIO, TEXAS.
  3. VALDEZDESIGNS, INC. HOLDS THE EXCLUSIVE RIGHT OF DISTRIBUTION.
  4. THE DRAWINGS BEING REPRESENTED MAY NOT BE COPIED IN FULL OR IN PART WITHOUT PRIOR WRITTEN PERMISSION GRANTED BY VALDEZDESIGNS, INC.
- VALDEZDESIGNS, INC.  
SAN ANTONIO, TEXAS  
VOICE (210) 810-1234

BRIGHTSTAR  
DEVELOPMENT LLC.  
210.882.2038


DIGNOWITY HILL  
610 DAWSON ST.  
SAN ANTONIO TX  
LOT: 3  
COUNTY BLOCK: 17

Plan Information:  
Drawn By: JV RB  
Project #: 1110  
Copyright: 2016


Revisions:  
1  
2

Issue Date:  
04-07-2016


Sheet Title & No.  
EXTERIOR  
ELEVATIONS  
A6

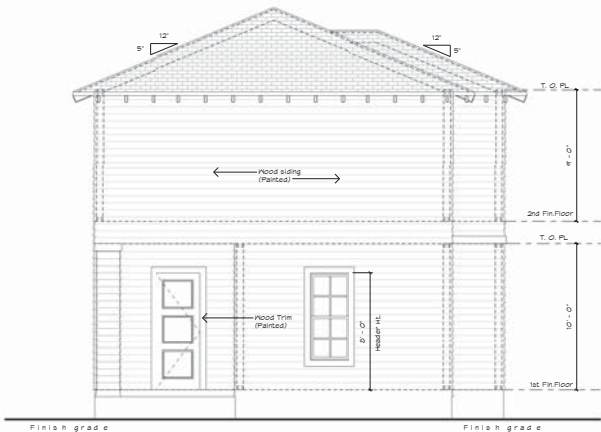


2 Building 2 Left Elevation  
1/4" = 1'-0"

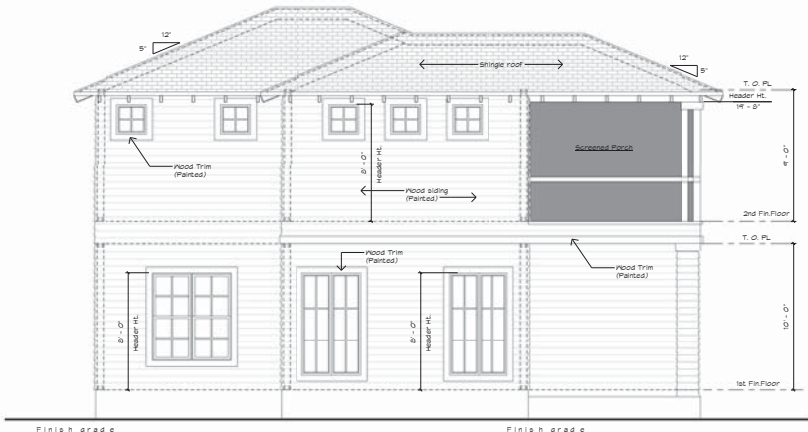


1 Building 2 Front Elevation  
1/4" = 1'-0"

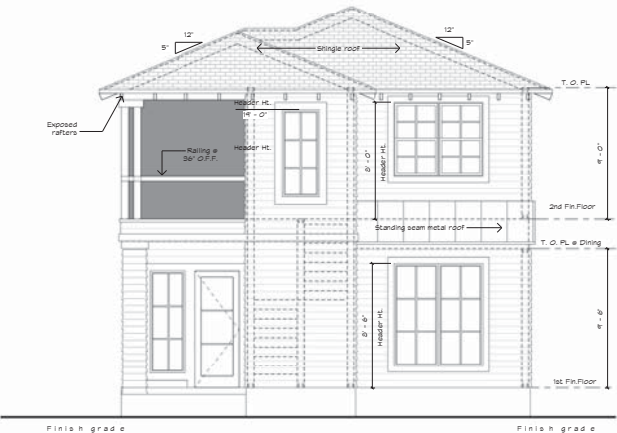

4 Building 2 Right Elevation  
1/4" = 1'-0"

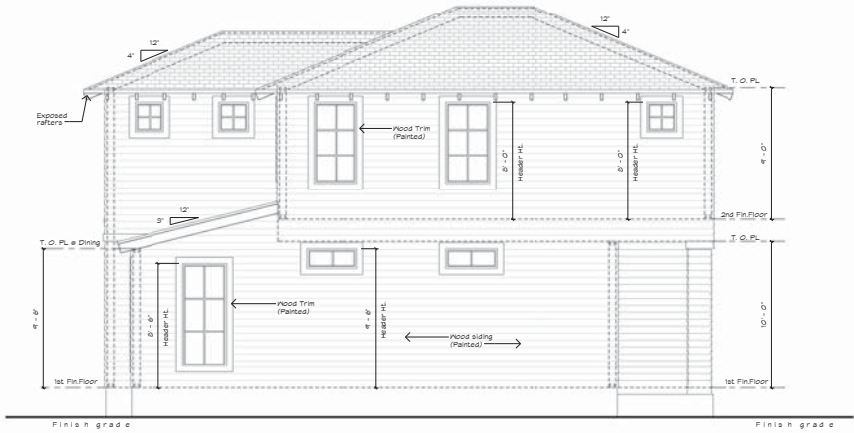


3 Building 2 Rear Elevation  
1/4" = 1'-0"

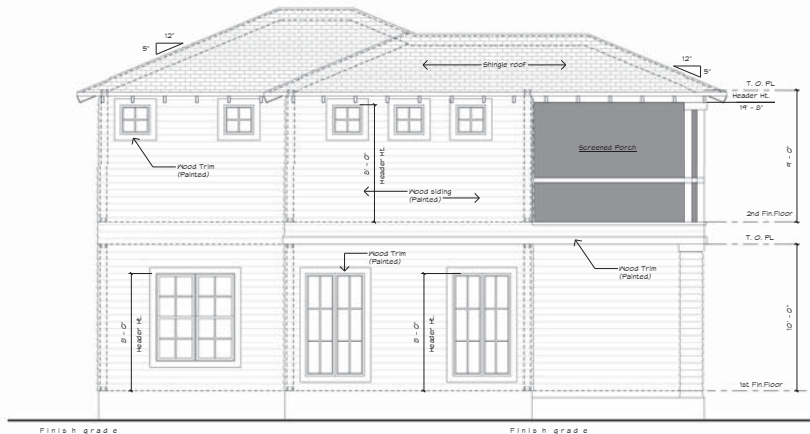

1 Building 2 Front Elevation

1/4" = 1'-0"

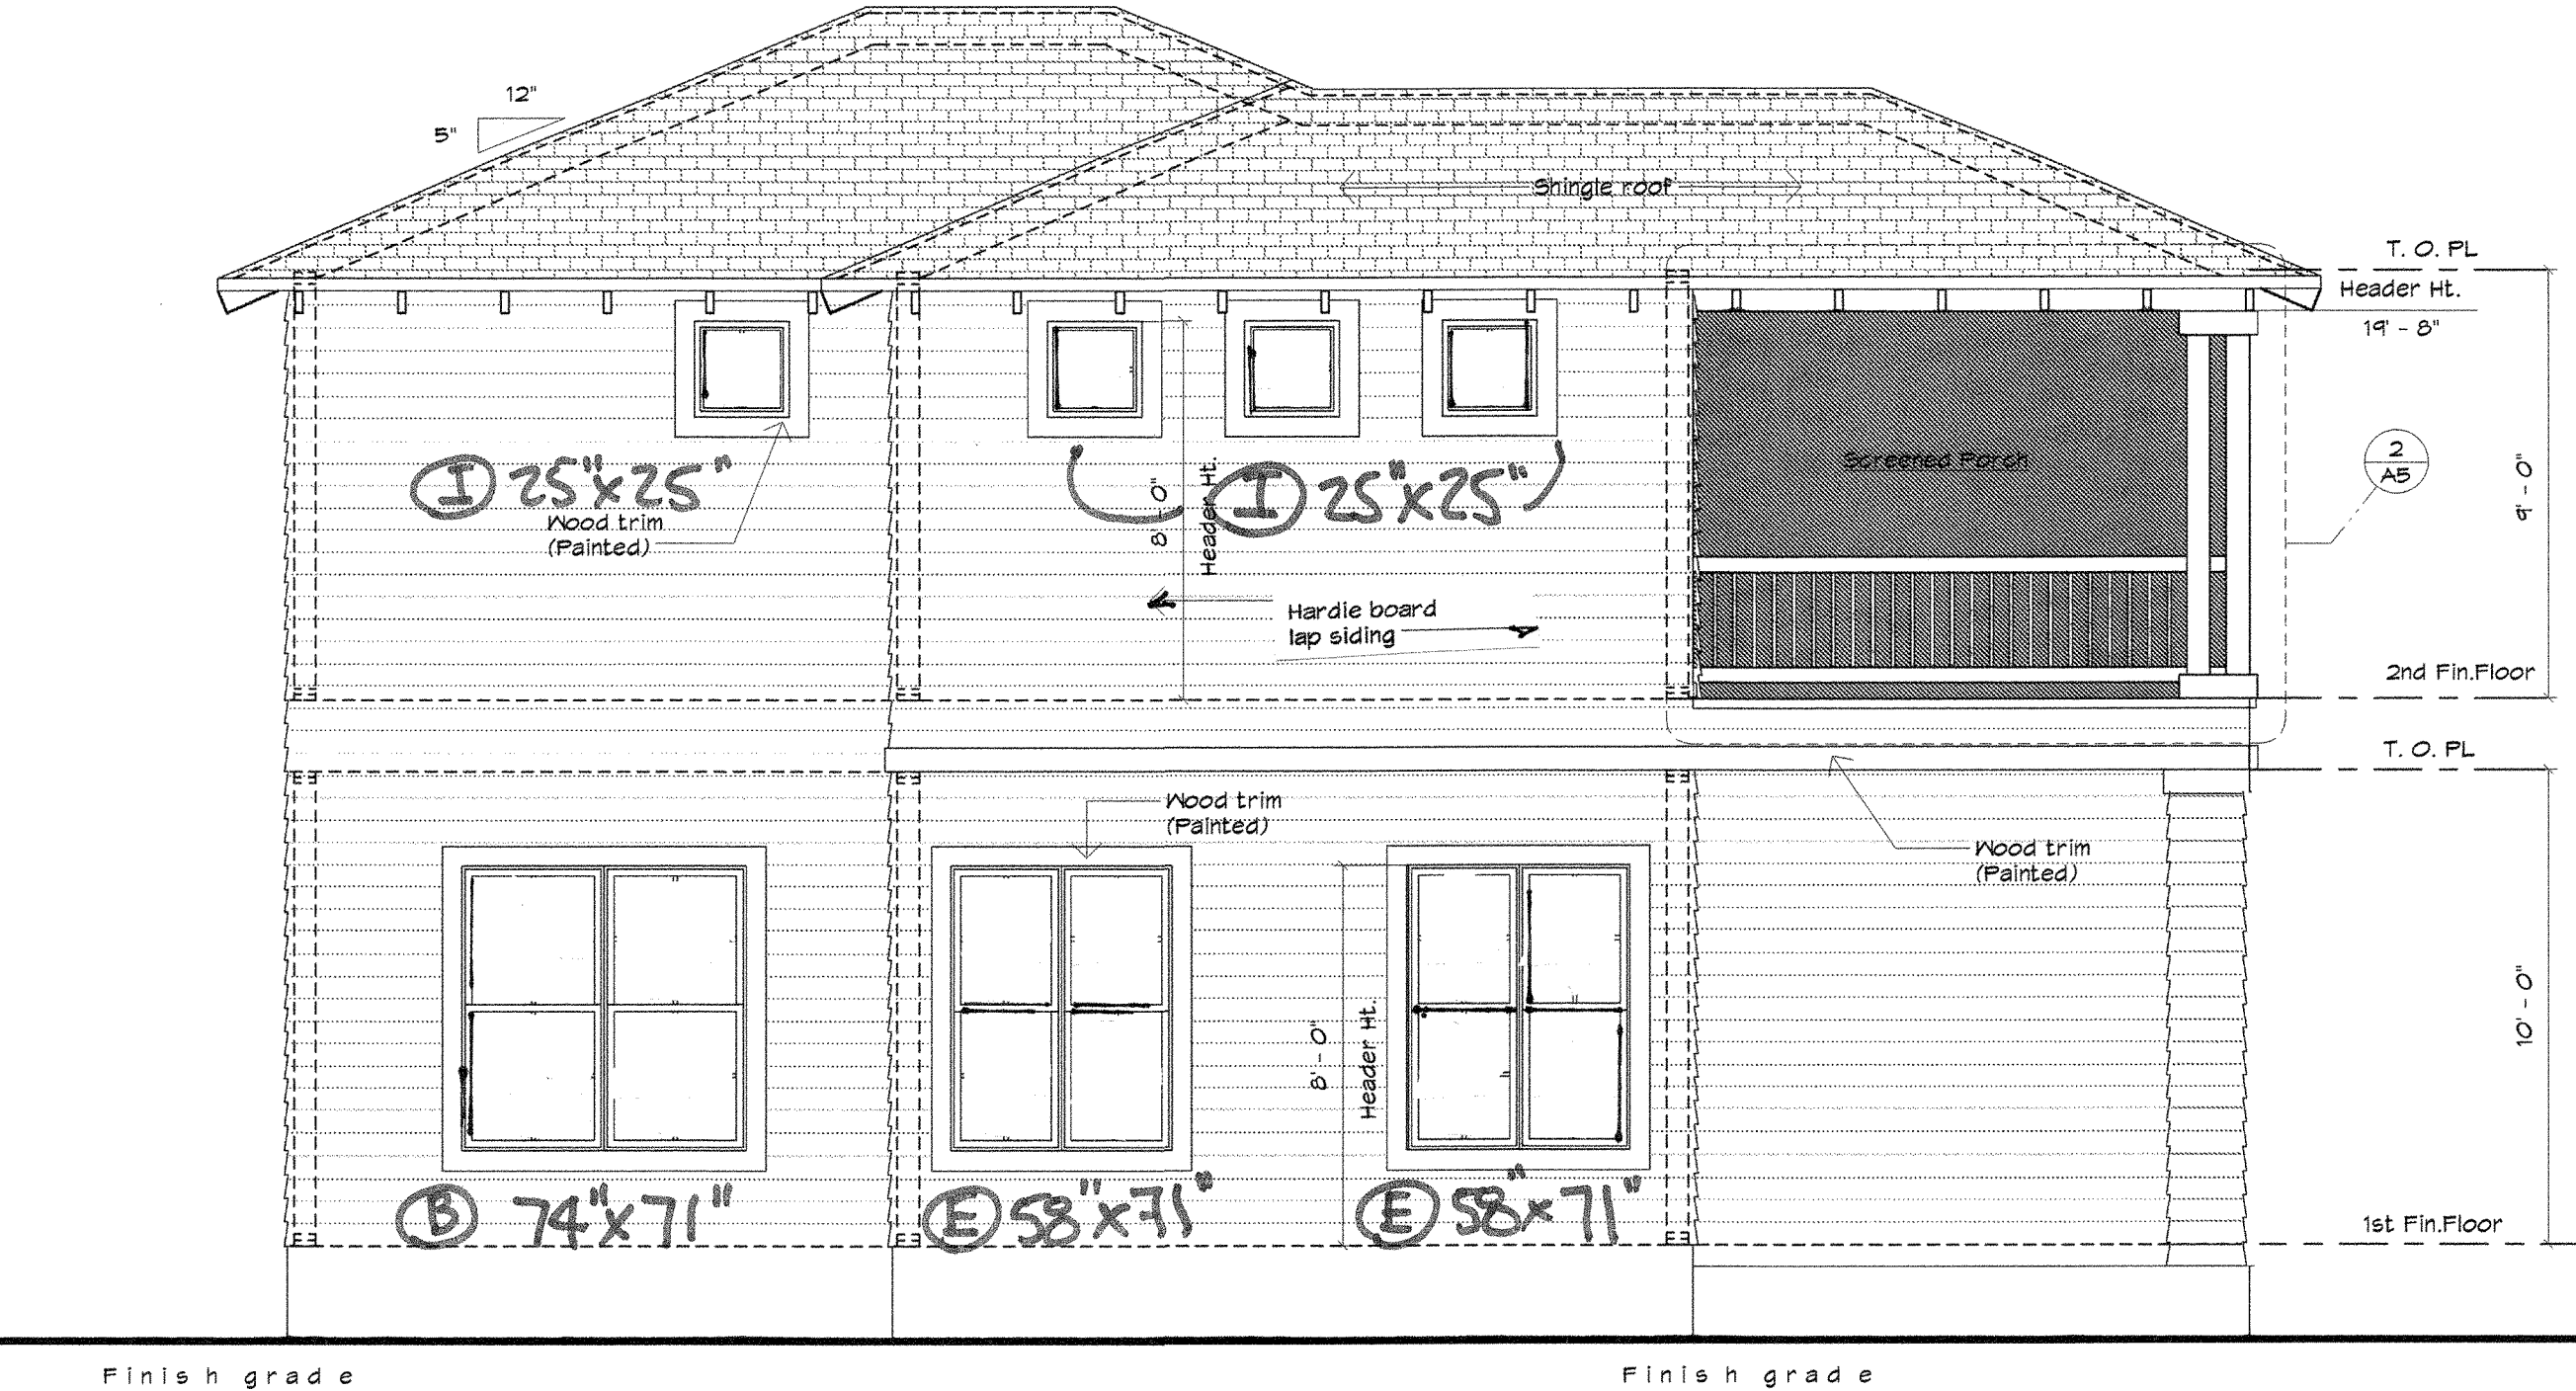

1 Front Elevation

1/4" = 1'-0"



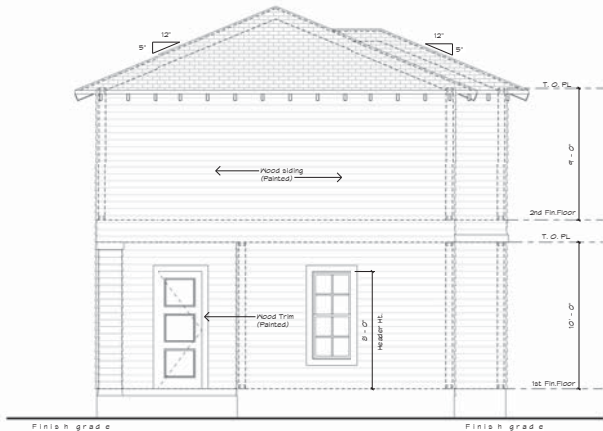


Photo #5  
North elevation/608

P

1/6/2 17






## 2 Building 2 Left Elevation




AS-BUILT/608

SUBMITTED BY APPLICANT 1/4/17

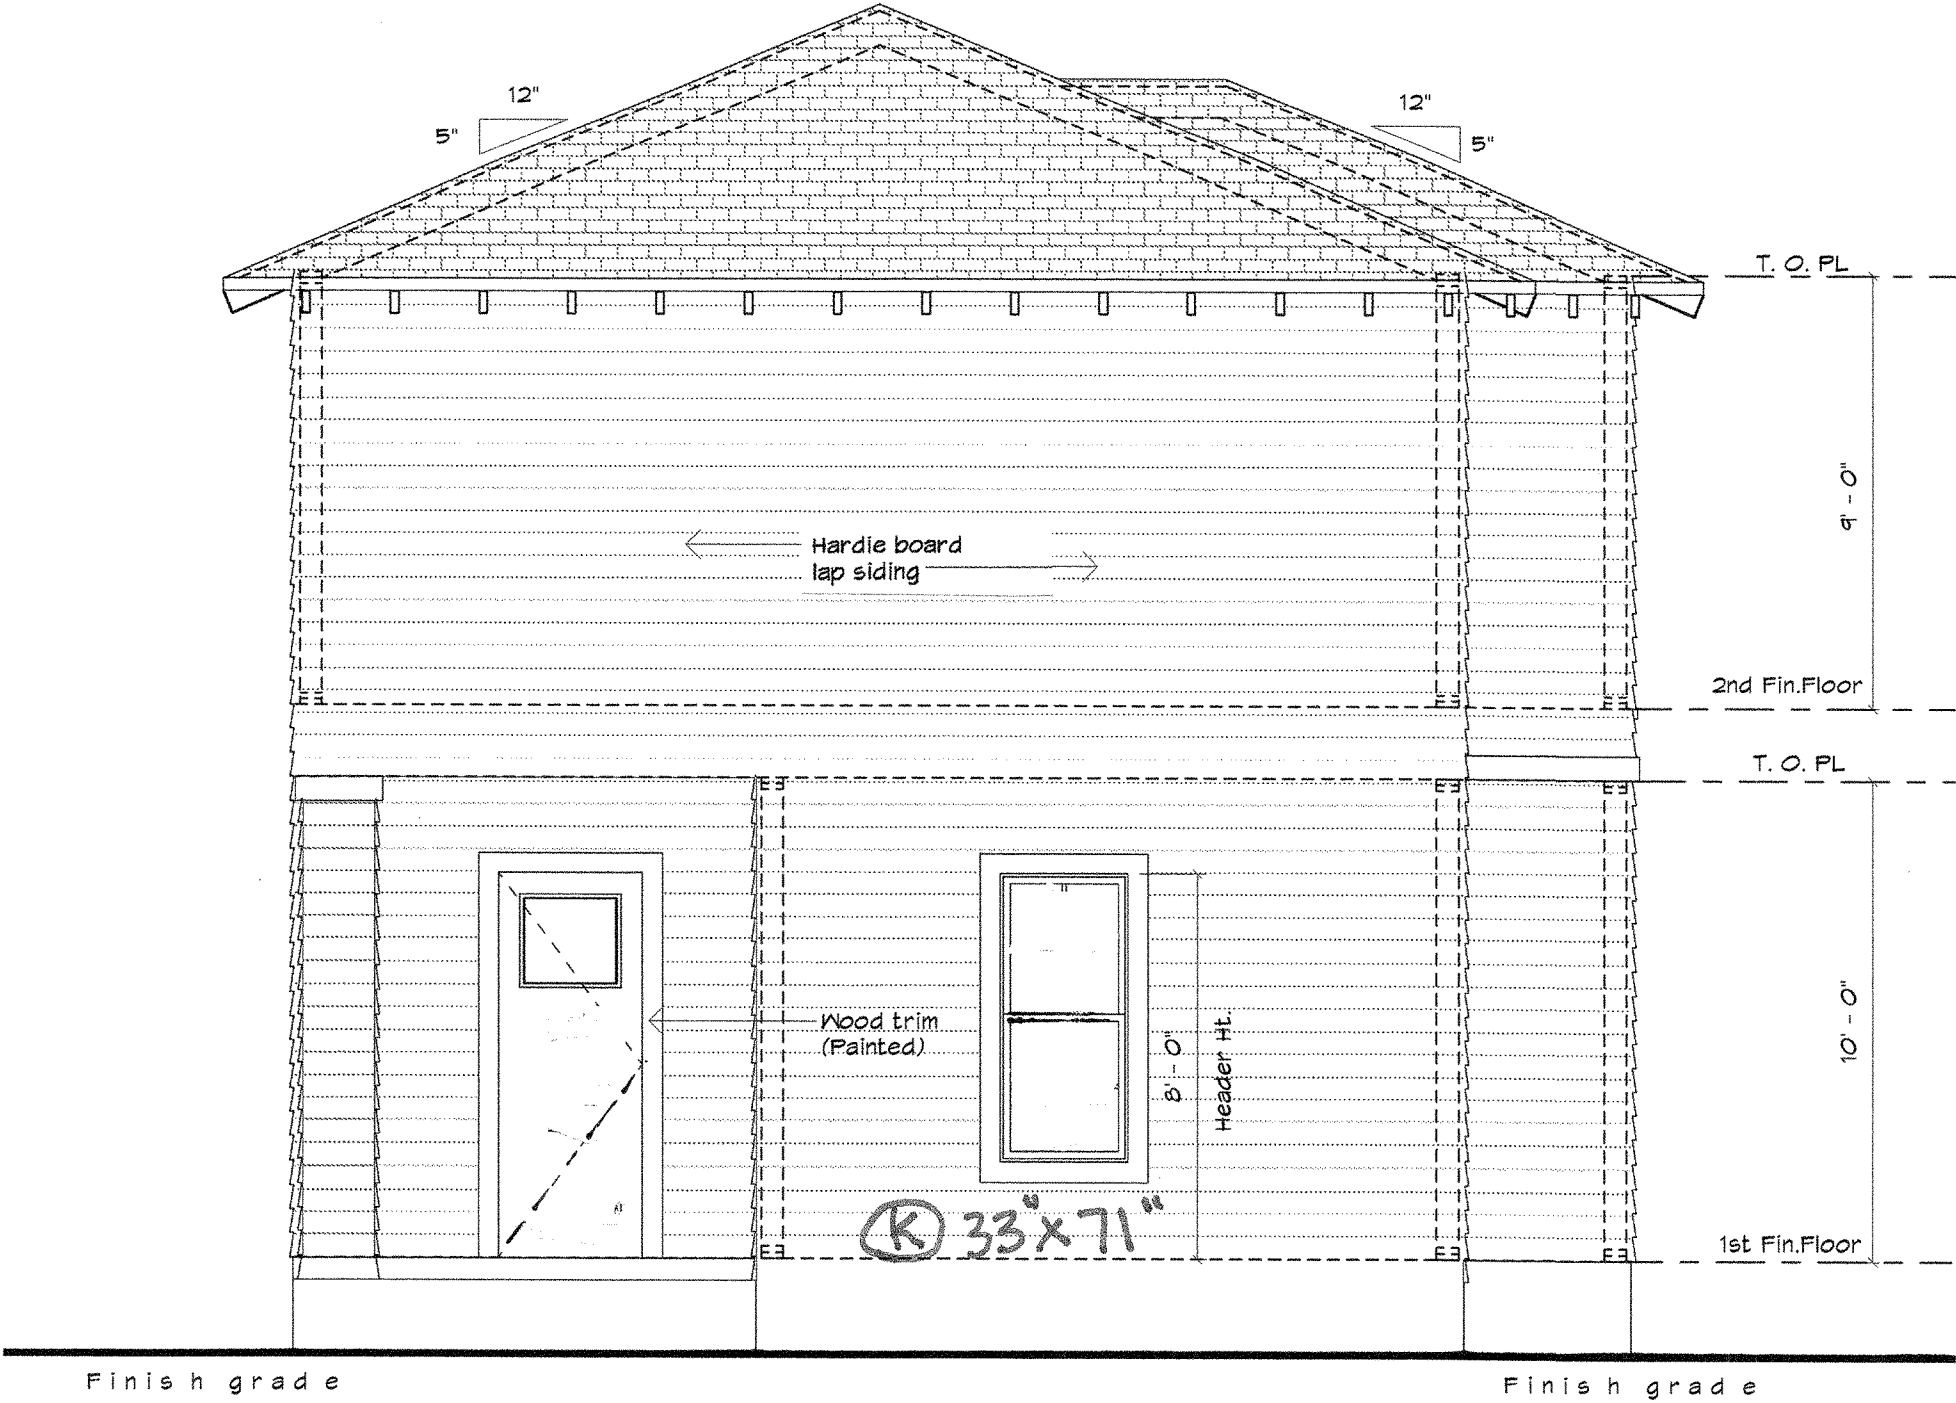

2 Left Elevation  
1/4" = 1'-0"

APPROVED BY HDRC / /16

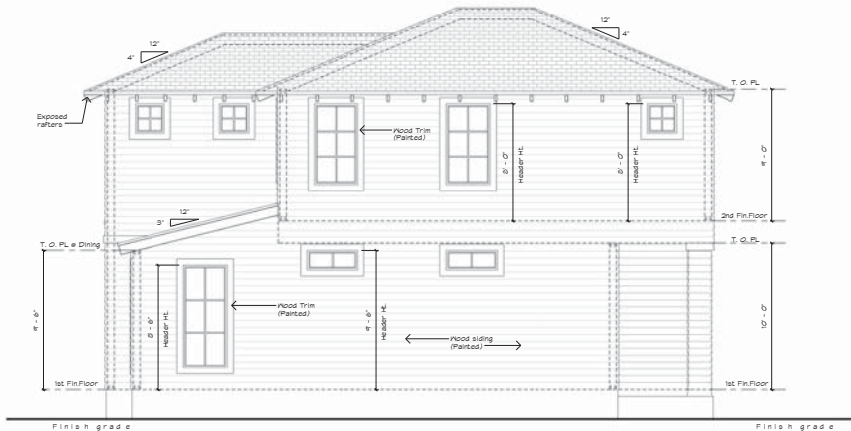

3 Building 2 Rear Elevation

1/4" = 1'-0"





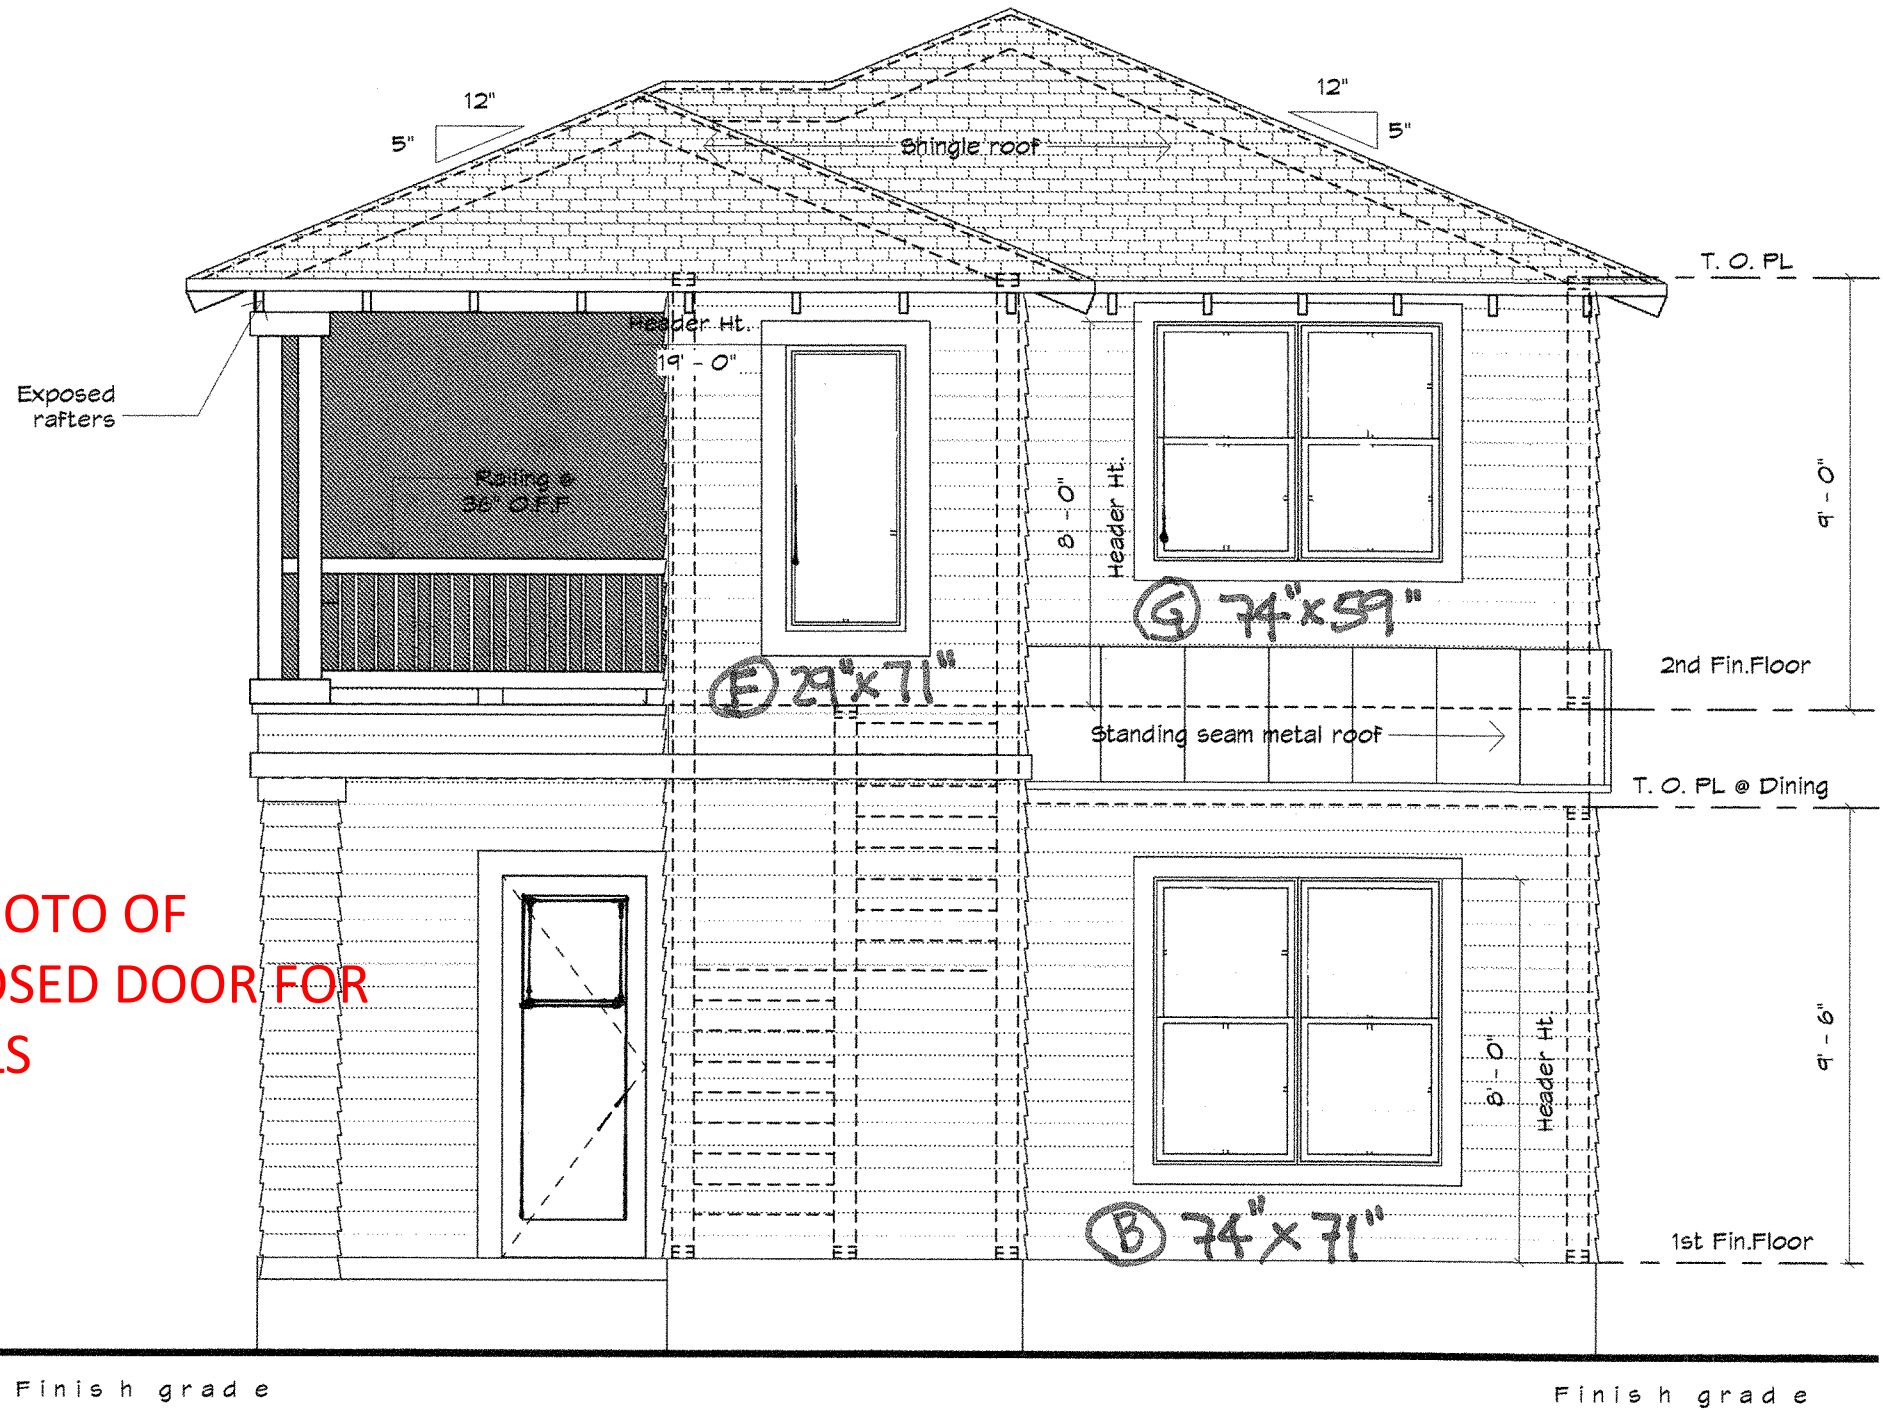


Photo #6  
South elevation/608

APPROVED BY HDRC / /16



4 Building 2 Right Elevation  
1/4" = 1'-0"



4 Right Elevation  
1/4" = 1'-0"





Photo#7  
West elevation/608



Photo #8

PROPOSED 1/6/17



PROPOSED 1/6/17





608/610 DAWSON

PROPOSED 1/6/17





PROPOSED 1/6/17



PROPOSED 1/6/17






PROPOSED 1/6/17



PROPOSED 1/6/17

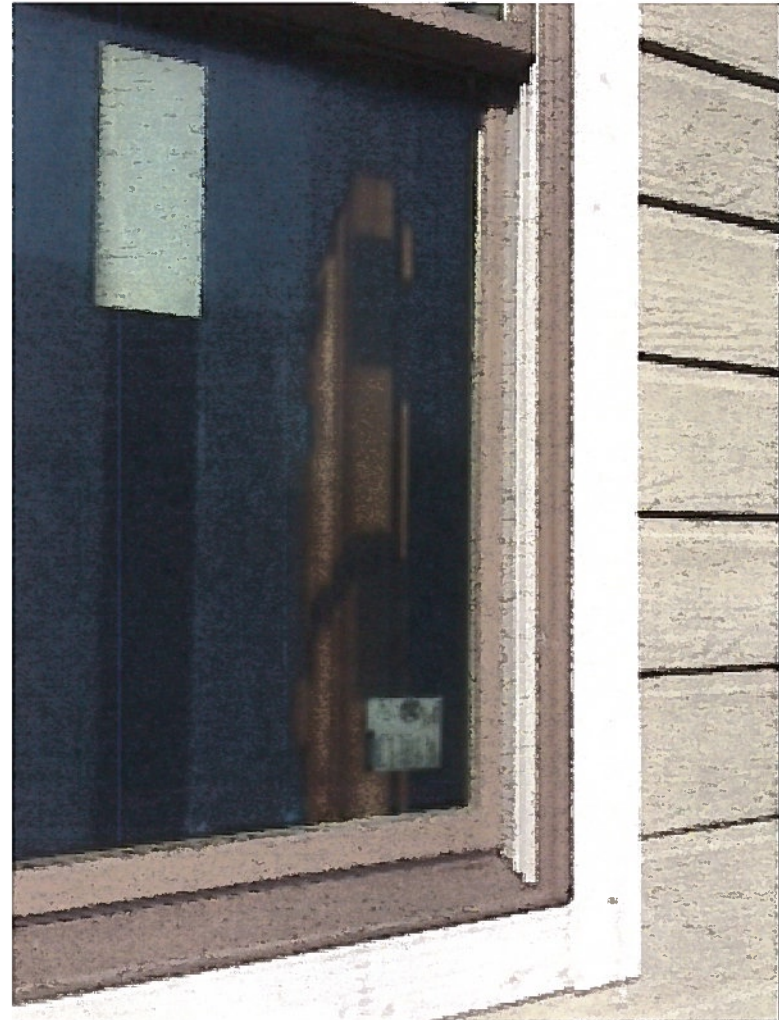



PROPOSED 1/6/17






PROPOSED 1/6/17




PROPOSED 1/6/17

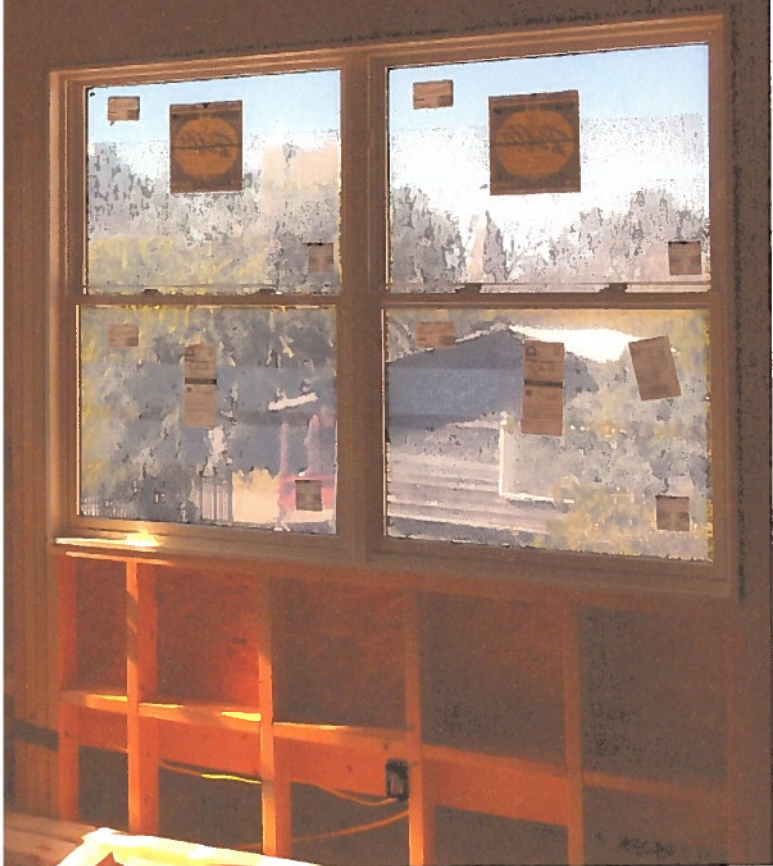

INTERIOR  
608/610 DAWSON

PROPOSED 1/6/17

interior  
608/610 DAWSON

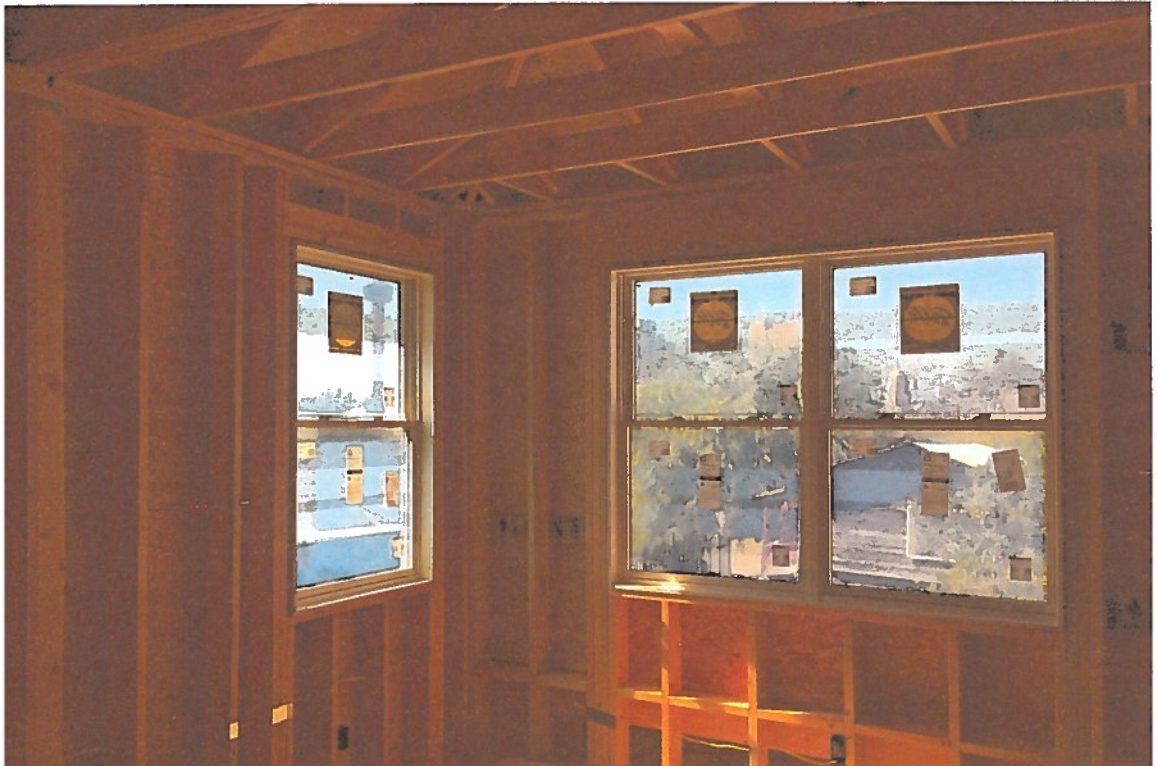









PROPOSED 1/6/17

# UNIT SECTIONS

## Aluminum-Clad Wood



HUNG

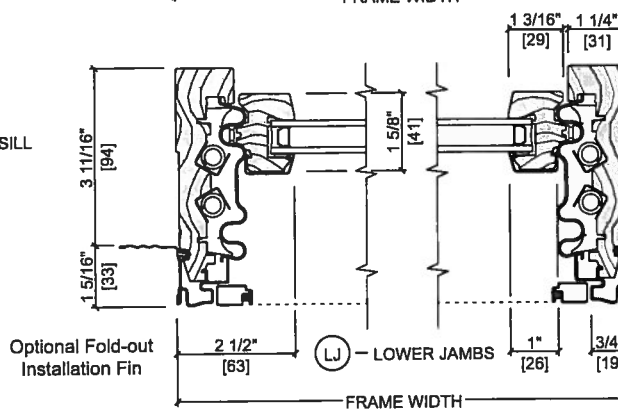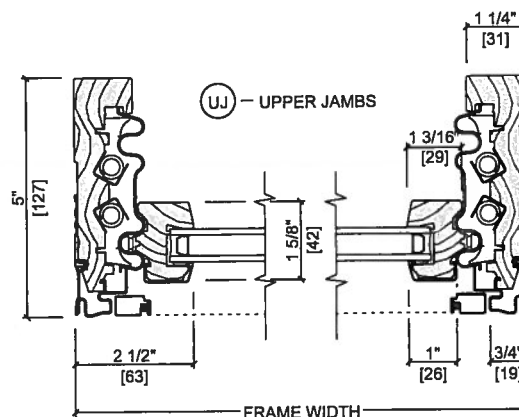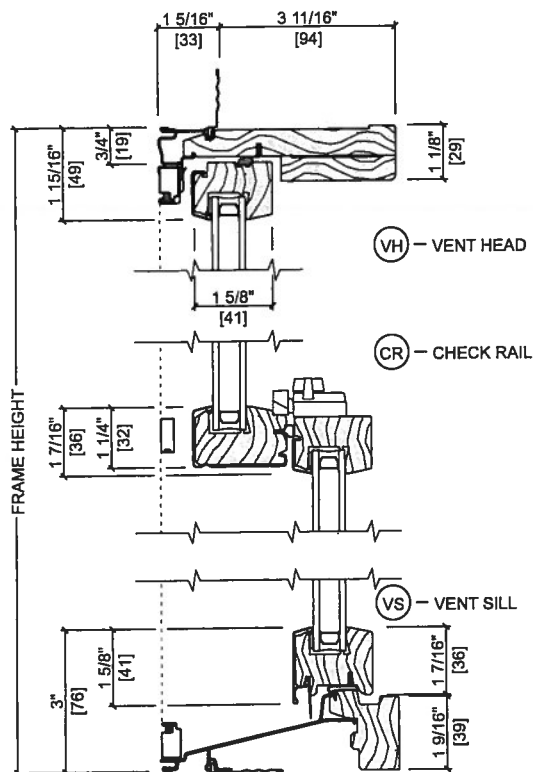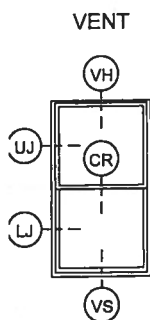

CROSS SECTION



608/610 Dawson

CLAD / WOOD

OVERVIEW

AWNING

BAY / BOW

CASEMENT

FIXED

HUNG

SPECIALTY PRODUCTS

SPECIAL SHAPES

IN-SWING DOOR

OUT-SWING DOOR

SLIDING DOOR

INSTALL

277

Scale 3" = 1' 0"

dimensions are approximate.



For additional product information, visit [PELLAADM.com](http://PELLAADM.com)

• Downloadable CAD files.

# Features and options.

PROPOSED 1/6/17

## HARDWARE FINISHES

Choose from today's most popular decorative finishes to coordinate with other finishes in your home.




## HARDWARE STYLES

Find beauty and function in Pella's innovative, easy-to-operate hardware styles.




## PREFINISHED PINE INTERIORS

The interiors of all Pella® Pine windows and patio doors can arrive prefinished in your choice of eight stain colors to complement your home. Three prefinished paint colors or primed, ready-to-paint interiors are also available.

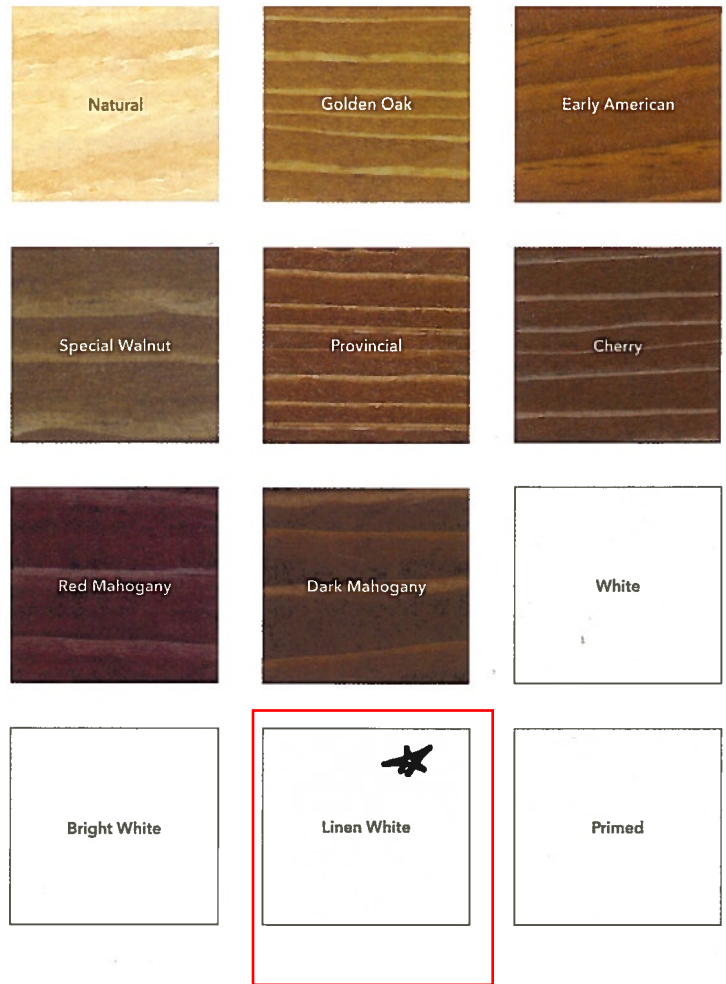

## ALUMINUM-CLAD EXTERIORS

Beautifully durable, Pella's low-maintenance EnduraClad® exterior finish resists fading and helps protect your windows and patio doors for years.

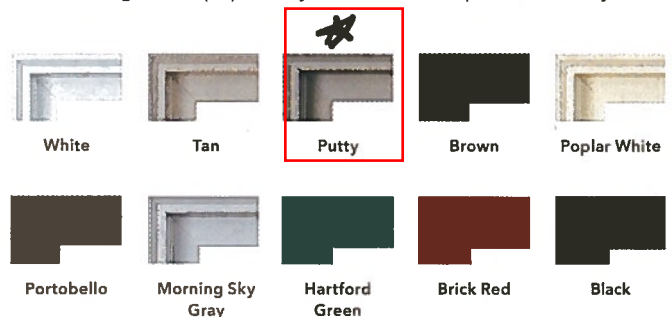



## Contract - Detailed

**PROPOSED 1/6/17**

Pella Window and Door Showroom of San Antonio  
6510 Blanco Road  
San Antonio, TX 78216  
**Phone:** (210) 735-2030 **Fax:** (210) 735-3837

**Sales Rep Name:** Sendejo, Sylvia  
**Sales Rep Phone:** (210) 735-2030  
**Sales Rep Fax:** (210) 735-2030  
**Sales Rep E-Mail:** ssendejo@pellasouthtexas.com

Customer Information	Project/Delivery Address	Order Information
<b>Brightstar Development, LLC.</b> 208 Argo Ave  SAN ANTONIO, TX 78209-5113 <b>Primary Phone:</b> (210) 882-2038 <b>Mobile Phone:</b> <b>Fax Number:</b> <b>E-Mail:</b> <b>Contact Name:</b>  <b>Great Plains #:</b> <b>Customer Number:</b> 1008112698 <b>Customer Account:</b> 1004021587	<b>610 Dawson</b> 610 Dawson St.  <b>Lot #</b> San Antonio, TX 78202 <b>County:</b> <b>Owner Name:</b> 610 Dawson St. <b>Owner Phone:</b>	<b>Quote Name:</b> 610 Dawson/Carlos Rodriguez -Proline Windows  <b>Order Number:</b> 370R10101 <b>Quote Number:</b> <b>8288986</b> <b>Order Type:</b> Non-Installed Sales <b>Wall Depth:</b> <b>Payment Terms:</b> Special <b>Tax Code:</b> SACC <b>Cust Delivery Date:</b> 10/21/2016 <b>Quoted Date:</b> 9/20/2016 <b>Contracted Date:</b> <b>Booked Date:</b> <b>Customer PO #:</b>


Customer Notes: PROLINE SERIES  
PUTTY EXTERIOR  
LINEN WHITE PRE-FINISHED INTERIOR  
SUN DEFENSE LOW E GLAZING W/ARGON GAS  
STANDARD CHAMPAGNE INTERIOR LOCK HARDWARE  
6-9/16" JAMB DEPTH  
NO SCREENS  
NAILING FIN  
PELLA INSTALLATION TAPE @ NO CHARGE  
DELIVERY TIME : 4 WEEKS





Line #	Location:	Attributes
--------	-----------	------------

24 E Living

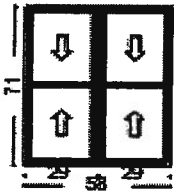

PK #  
819

Viewed From Exterior

## ProLine, 2-Wide Double Hung, 58 X 71, Putty

Item Price	Qty	Ext'd Price
\$813.44	2	\$1,626.88

### 1: 2971 Double Hung, Equal

Frame Size: 29 X 71

General Information: Clad, 5", 3 11/16"

Exterior Color / Finish: Standard Enduraclad, Putty

Interior Color / Finish: Linen White Interior

Glass: Insulated Low-E SunDefense™ Low-E Insulating Glass Argon Non High Altitude

Hardware Options: Cam-Action Lock, Champagne, No Limited Opening Hardware, Order Sash Lift

Screen: No Screen

Performance Information: U-Factor 0.30, SHGC 0.22, VLT 0.52, CPD PEL-N-35-00260-00001, Performance Class LC, PG 30, Calculated Positive DP Rating 30, Calculated Negative DP Rating 30, TDI WIN-694

Grille: No Grille,

Vertical Mull 1: FactoryMull, Standard Joining Mullion, Mull Design Pressure- 20

### 2: 2971 Double Hung, Equal

Frame Size: 29 X 71

General Information: Clad, 5", 3 11/16"

Exterior Color / Finish: Standard Enduraclad, Putty

Interior Color / Finish: Linen White Interior

Glass: Insulated Low-E SunDefense™ Low-E Insulating Glass Argon Non High Altitude

Hardware Options: Cam-Action Lock, Champagne, No Limited Opening Hardware, Order Sash Lift

Screen: No Screen

Performance Information: U-Factor 0.30, SHGC 0.22, VLT 0.52, CPD PEL-N-35-00260-00001, Performance Class LC, PG 30, Calculated Positive DP Rating 30, Calculated Negative DP Rating 30, TDI WIN-694

Grille: No Grille,

Vertical Mull 1: FactoryMull, Standard Joining Mullion, Mull Design Pressure- 20

Wrapping Information: Foldout Fins, Factory Applied, No Exterior Trim, No Interior Trim, 6 9/16", 7 7/8", Standard Four Sided Jamb Extension, Factory Applied, Pella Recommended Clearance, Perimeter Length = 258".

Rough Opening: 58 - 3/4" X 71 - 3/4"

Line #	Location:	Attributes
--------	-----------	------------

25 K Office/Diing

**ProLine, Double Hung, 33 X 71, Putty**

Item Price	Qty	Ext'd Price
\$411.86	2	\$823.72



PK #  
819

Viewed From Exterior

**1: 3371 Double Hung, Equal**  
**Frame Size:** 33 X 71  
**General Information:** Clad, 5", 3 11/16"  
**Exterior Color / Finish:** Standard Enduraclad, Putty  
**Interior Color / Finish:** Linen White Interior  
**Glass:** Insulated Low-E SunDefense™ Low-E Insulating Glass Argon Non High Altitude  
**Hardware Options:** Cam-Action Lock, Champagne, No Limited Opening Hardware, Order Sash Lift  
**Screen:** No Screen  
**Performance Information:** U-Factor 0.30, SHGC 0.22, VLT 0.52, CPD PEL-N-35-00260-00001, Performance Class LC, PG 30, Calculated Positive DP Rating 30, Calculated Negative DP Rating 30, TDI WIN-694  
**Grille:** No Grille,  
**Wrapping Information:** Foldout Fins, Factory Applied, No Exterior Trim, No Interior Trim, 6 9/16", 7 7/8", Standard Four Sided Jamb Extension, Factory Applied, Pella Recommended Clearance, Perimeter Length = 208".

**Rough Opening:** 33 - 3/4" X 71 - 3/4"




Line #	Location:	Attributes
--------	-----------	------------

30 G Bedroom #2

## ProLine, 2-Wide Double Hung, 74 X 59, Putty

Item Price	Qty	Ext'd Price
\$867.23	1	\$867.23

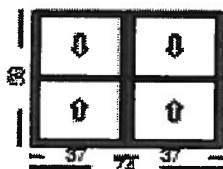

PK #  
819

Viewed From Exterior

### 1: 3759 Double Hung, Equal

Frame Size: 37 X 59

General Information: Clad, 5", 3 11/16"

Exterior Color / Finish: Standard Enduraclad, Putty

Interior Color / Finish: Linen White Interior

Glass: Insulated Low-E SunDefense™ Low-E Insulating Glass Argon Non High Altitude

Hardware Options: Cam-Action Lock, Champagne, Limited Opening Hardware, Order Sash Lift

Screen: No Screen

Performance Information: U-Factor 0.30, SHGC 0.22, VLT 0.52, CPD PEL-N-35-00260-00001, Performance Class LC, PG 35, Calculated Positive DP Rating 35, Calculated Negative DP Rating 35, TDI WIN-694

Grille: No Grille,

Vertical Mull 1: FactoryMull, Standard Joining Mullion, Mull Design Pressure- 20

### 2: 3759 Double Hung, Equal

Frame Size: 37 X 59

General Information: Clad, 5", 3 11/16"

Exterior Color / Finish: Standard Enduraclad, Putty

Interior Color / Finish: Linen White Interior

Glass: Insulated Low-E SunDefense™ Low-E Insulating Glass Argon Non High Altitude

Hardware Options: Cam-Action Lock, Champagne, Limited Opening Hardware, Order Sash Lift

Screen: No Screen

Performance Information: U-Factor 0.30, SHGC 0.22, VLT 0.52, CPD PEL-N-35-00260-00001, Performance Class LC, PG 35, Calculated Positive DP Rating 35, Calculated Negative DP Rating 35, TDI WIN-694


Grille: No Grille,

Vertical Mull 1: FactoryMull, Standard Joining Mullion, Mull Design Pressure- 20

Wrapping Information: Foldout Fins, Factory Applied, No Exterior Trim, No Interior Trim, 6 9/16", 7 7/8", Standard Four Sided Jamb Extension, Factory Applied, Pella Recommended Clearance, Perimeter Length = 266".


Rough Opening: 74 - 3/4" X 59 - 3/4"

Customer Notes: INCLUDES SAFETY LOCKS

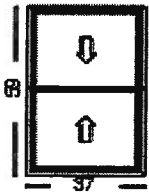
Line #	Location:	Attributes			
35	H Bdrm 2	<b>ProLine, Double Hung, 37 X 59, Putty</b>	<b>Item Price</b>	<b>Qty</b>	<b>Ext'd Price</b>
			\$421.97	2	\$843.94
	Viewed From Exterior	<p><b>1: 3759 Double Hung, Equal</b> <b>Frame Size:</b> 37 X 59 <b>General Information:</b> Clad, 5", 3 11/16" <b>Exterior Color / Finish:</b> Standard Enduraclad, Putty <b>Interior Color / Finish:</b> Linen White Interior <b>Glass:</b> Insulated Low-E SunDefense™ Low-E Insulating Glass Argon Non High Altitude <b>Hardware Options:</b> Cam-Action Lock, Champagne, Limited Opening Hardware, Order Sash Lift <b>Screen:</b> No Screen <b>Performance Information:</b> U-Factor 0.30, SHGC 0.22, VLT 0.52, CPD PEL-N-35-00260-00001, Performance Class LC, PG 35, Calculated Positive DP Rating 35, Calculated Negative DP Rating 35, TDI WIN-694 <b>Grille:</b> No Grille, <b>Wrapping Information:</b> Foldout Fins, Factory Applied, No Exterior Trim, No Interior Trim, 6 9/16", 7 7/8", Standard Four Sided Jamb Extension, Factory Applied, Pella Recommended Clearance, Perimeter Length = 192".</p>			
	PK # 819				

Rough Opening: 37 - 3/4" X 59 - 3/4"

Customer Notes: SAFETY LOCKS INCLUDED

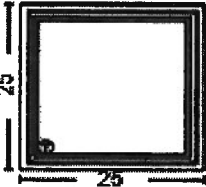Line #	Location:	Attributes			
40	I Stairs, Bdrm 2, Ba	<b>ProLine, Sash Set Fixed, 25 X 25, Putty</b>	<u>Item Price</u>	<u>Qty</u>	<u>Ext'd Price</u>
			\$240.97	6	\$1,445.82
		<b>1: 2525 Fixed Sash Set</b> <b>Frame Size:</b> 25 X 25 <b>General Information:</b> Clad, 5", 3 11/16" <b>Exterior Color / Finish:</b> Standard Enduraclad, Putty <b>Interior Color / Finish:</b> Linen White Interior <b>Glass:</b> Insulated Tempered Low-E SunDefense™ Low-E Insulating Glass Argon Non High Altitude <b>Performance Information:</b> U-Factor 0.27, SHGC 0.23, VLT 0.53, CPD PEL-N-22-00520-00001, Performance Class R, PG 50, Calculated Positive DP Rating 50, Calculated Negative DP Rating 50, TDI WIN-827 <b>Grille:</b> No Grille, <b>Wrapping Information:</b> Foldout Fins, Factory Applied, No Exterior Trim, No Interior Trim, 6 9/16", 7 7/8", Standard Four Sided Jamb Extension, Factory Applied, Pella Recommended Clearance, Perimeter Length = 100".			
	Viewed From Exterior	PK # 819			

Rough Opening: 25 - 3/4" X 25 - 3/4"

Line #	Location:	Attributes		
45	J Kitchen	<b>ProLine, Sash Set Fixed, 41 X 17, Putty</b>	<u>Item Price</u>	<u>Qty</u> <u>Ext'd Price</u>
			\$257.15	2 \$514.30
<div>  <div> <p>PK # 819</p> <p>Viewed From Exterior</p> </div> </div> <p> <b>1: 4117 Fixed Sash Set</b>  <b>Frame Size:</b> 41 X 17  <b>General Information:</b> Clad, 5", 3 11/16"  <b>Exterior Color / Finish:</b> Standard Enduraclad, Putty  <b>Interior Color / Finish:</b> Linen White Interior  <b>Glass:</b> Insulated Low-E SunDefense™ Low-E Insulating Glass Argon Non High Altitude  <b>Performance Information:</b> U-Factor 0.27, SHGC 0.23, VLT 0.53, CPD PEL-N-22-00520-00001, Performance Class R, PG 50, Calculated Positive DP Rating 50, Calculated Negative DP Rating 50, TDI WIN-827  <b>Grille:</b> No Grille,  <b>Wrapping Information:</b> Foldout Fins, Factory Applied, No Exterior Trim, No Interior Trim, 6 9/16", 7 7/8", Standard Four Sided Jamb Extension, Factory Applied, Pella Recommended Clearance, Perimeter Length = 116".         </p>				

Rough Opening: 41 - 3/4" X 17 - 3/4"

Line #	Location:	Attributes		
50		<b>PELLA INSTALLATION TAPE</b>	<u>Item Price</u>	<u>Qty</u> <u>Ext'd Price</u>
			\$0.00	5 \$0.00

Customer Notes: NO CHARGE PER SYLVIA



☐ Project Checklist has been reviewed

Customer Name (Please print)

  
Customer Signature

Date

Credit Card Approval Signature

Pella Sales Rep Name (Please print)

Pella Sales Rep Signature

Date

Order Totals	
Taxable Subtotal	\$8,417.86
Sales Tax @ 8.25%	\$694.47
Non-taxable Subtotal	\$0.00
<b>Total</b>	<b>\$9,112.33</b>
Deposit Received	\$0.00
<b>Amount Due</b>	<b>\$9,112.33</b>

608 DAWSON  
610 DAWSON  
total

18 WINDOWS  
18 WINDOWS  

---

36 WINDOWS

X 2  
-----  
\$ 18,244.<sup>66</sup>/<sub>100</sub>

PHOTOS SUBMITTED BY APPLICANT  
1/11/17 IN RESPONSE TO STAFF'S  
COMMENTS



PHOTOS SUBMITTED BY APPLICANT 1/11/17 IN RESPONSE TO STAFF'S COMMENTS  
- PAIRED WINDOWS WITH MIDDLE TRIM





PHOTOS SUBMITTED BY APPLICANT 1/11/17 IN RESPONSE TO STAFF'S COMMENTS  
- PAIRED WINDOWS WITH MIDDLE TRIM











612 DAWSON  
- PHOTOS SUBMITTED BY APPLICANT



612 DAWSON  
- PHOTOS SUBMITTED BY APPLICANT





PHOTOS SUBMITTED BY APPLICANT  
OF NEIGHBOR HOMES



PHOTOS SUBMITTED BY APPLICANT OF NEIGHBOR HOMES



PHOTOS SUBMITTED BY APPLICANT OF NEIGHBOR HOMES





PHOTOS SUBMITTED BY APPLICANT OF NEIGHBOR HOMES

