# HISTORIC AND DESIGN REVIEW COMMISSION May 16, 2018

**HDRC CASE NO:** 2018-218 **ADDRESS:** 901 N PINE ST

729 HAYS ST 725 HAYS ST

LEGAL DESCRIPTION:

**ZONING:** IDZ, H CITY COUNCIL DIST.: 2

**DISTRICT:** Dignowity Hill Historic District **APPLICANT:** Ricardo Turrubiates/Terramark TX

**OWNER:** K/T TX Holdings, LLC

**TYPE OF WORK:** New construction of three, two story residential structures

**APPLICATION RECEIVED:** April 30, 2018 **60-DAY REVIEW:** June 29, 2018

**REQUEST:** 

The applicant is requesting a Certificate of Appropriateness for approval to:

- 1. Construct a two story, single family residential structure at 725 Hays.
- 2. Construct a two story, single family residential structure at 729 Hays.
- 3. Construct a two story, single family residential structure at 901 N Pine.

### **APPLICABLE CITATIONS:**

Historic Design Guidelines, Chapter 4, Guidelines for New Construction

1. Building and Entrance Orientation

### A. FAÇADE ORIENTATION

- *i. Setbacks*—Align front facades of new buildings with front facades of adjacent buildings where a consistent setback has been established along the street frontage. Use the median setback of buildings along the street frontage where a variety of setbacks exist. Refer to UDC Article 3, Division 2. Base Zoning Districts for applicable setback requirements.
- *ii. Orientation*—Orient the front façade of new buildings to be consistent with the predominant orientation of historic buildings along the street frontage.

### **B. ENTRANCES**

*i. Orientation*—Orient primary building entrances, porches, and landings to be consistent with those historically found along the street frontage. Typically, historic building entrances are oriented towards the primary street.

### 2. Building Massing and Form

### A. SCALE AND MASS

- *i. Similar height and scale*—Design new construction so that its height and overall scale are consistent with nearby historic buildings. In residential districts, the height and scale of new construction should not exceed that of the majority of historic buildings by more than one-story. In commercial districts, building height shall conform to the established pattern. If there is no more than a 50% variation in the scale of buildings on the adjacent block faces, then the height of the new building shall not exceed the tallest building on the adjacent block face by more than 10%.
- *ii. Transitions*—Utilize step-downs in building height, wall-plane offsets, and other variations in building massing to provide a visual transition when the height of new construction exceeds that of adjacent historic buildings by more than one-half story.
- *iii. Foundation and floor heights*—Align foundation and floor-to-floor heights (including porches and balconies) within one foot of floor-to-floor heights on adjacent historic structures.

### B. ROOF FORM

i. Similar roof forms—Incorporate roof forms—pitch, overhangs, and orientation—that are consistent with those

predominantly found on the block. Roof forms on residential building types are typically sloped, while roof forms on nonresidential

building types are more typically flat and screened by an ornamental parapet wall.

*ii.* Façade configuration—The primary façade of new commercial buildings should be in keeping with established patterns. Maintaining horizontal elements within adjacent cap, middle, and base precedents will establish a consistent street wall through the alignment of horizontal parts. Avoid blank walls, particularly on elevations visible from the street. No new façade should exceed 40 linear feet without being penetrated by windows, entryways, or other defined bays.

### D. LOT COVERAGE

*i. Building to lot ratio*—New construction should be consistent with adjacent historic buildings in terms of the building to lot ratio. Limit the building footprint for new construction to no more than 50 percent of the total lot area, unless adjacent historic buildings establish a precedent with a greater building to lot ratio.

### 3. Materials and Textures

### A. NEW MATERIALS

- i. *Complementary materials*—Use materials that complement the type, color, and texture of materials traditionally found in the district. Materials should not be so dissimilar as to distract from the historic interpretation of the district. For example, corrugated metal siding would not be appropriate for a new structure in a district comprised of homes with wood siding.
- *ii.* Alternative use of traditional materials—Consider using traditional materials, such as wood siding, in a new way to provide visual interest in new construction while still ensuring compatibility.
- iii. Roof materials—Select roof materials that are similar in terms of form, color, and texture to traditionally used in the district.
- *iv. Metal roofs*—Construct new metal roofs in a similar fashion as historic metal roofs. Refer to the Guidelines for Alterations and Maintenance section for additional specifications regarding metal roofs.
- v. Imitation or synthetic materials—Do not use vinyl siding, plastic, or corrugated metal sheeting. Contemporary materials not traditionally used in the district, such as brick or simulated stone veneer and Hardie Board or other fiberboard siding, may be appropriate for new construction in some locations as long as new materials are visually similar to the traditional material in dimension, finish, and texture. EIFS is not recommended as a substitute for actual stucco.

### 4. Architectural Details

### A. GENERAL

- *i. Historic context*—Design new buildings to reflect their time while respecting the historic context. While new construction should not attempt to mirror or replicate historic features, new structures should not be so dissimilar as to distract from or diminish the historic interpretation of the district.
- ii. Architectural details—Incorporate architectural details that are in keeping with the predominant architectural style along the block face or within the district when one exists. Details should be simple in design and should complement, but not visually compete with, the character of the adjacent historic structures or other historic structures within the district. Architectural details that are more ornate or elaborate than those found within the district are inappropriate.
- *iii.* Contemporary interpretations—Consider integrating contemporary interpretations of traditional designs and details for new construction. Use of contemporary window moldings and door surroundings, for example, can provide visual interest while helping to convey the fact that the structure is new. Modern materials should be implemented in a way that does not distract from the historic structure.

### 6. Mechanical Equipment and Roof Appurtenances

### A. LOCATION AND SITING

- *i. Visibility*—Do not locate utility boxes, air conditioners, rooftop mechanical equipment, skylights, satellite dishes, and other roof appurtenances on primary facades, front-facing roof slopes, in front yards, or in other locations that are clearly visible from the public right-of-way.
- ii. Service Areas—Locate service areas towards the rear of the site to minimize visibility from the public right-of-way.

### **B. SCREENING**

- *i. Building-mounted equipment*—Paint devices mounted on secondary facades and other exposed hardware, frames, and piping to match the color scheme of the primary structure or screen them with landscaping.
- *ii. Freestanding equipment*—Screen service areas, air conditioning units, and other mechanical equipment from public view using a fence, hedge, or other enclosure.
- *iii. Roof-mounted equipment*—Screen and set back devices mounted on the roof to avoid view from public right-of-way. Historic Design Guidelines, Chapter 5, Guidelines for Site Elements

### **B. NEW FENCES AND WALLS**

- i. Design—New fences and walls should appear similar to those used historically within the district in terms of their scale, transparency, and character. Design of fence should respond to the design and materials of the house or main structure. ii. Location—Avoid installing a fence or wall in a location where one did not historically exist, particularly within the front yard. The appropriateness of a front yard fence or wall is dependent on conditions within a specific historic district. New front yard fences or wall should not be introduced within historic districts that have not historically had them. iii. Height—Limit the height of new fences and walls within the front yard to a maximum of four feet. The appropriateness of a front yard fence is dependent on conditions within a specific historic district. New front yard fences should not be introduced within historic districts that have not historically had them. If a taller fence or wall existed historically, additional height may be considered. The height of a new retaining wall should not exceed the height of the slope it retains.
- iv. Prohibited materials—Do not use exposed concrete masonry units (CMU), Keystone or similar interlocking retaining wall systems, concrete block, vinyl fencing, or chain link fencing.
- v. Appropriate materials—Construct new fences or walls of materials similar to fence materials historically used in the district. Select materials that are similar in scale, texture, color, and form as those historically used in the district, and that are compatible with the main structure. Screening incompatible uses—Review alternative fence heights and materials for appropriateness where residential properties are adjacent to commercial or other potentially incompatible uses.

### 3. Landscape Design

### A. PLANTINGS

- i. Historic Gardens— Maintain front yard gardens when appropriate within a specific historic district.
- *ii. Historic Lawns*—Do not fully remove and replace traditional lawn areas with impervious hardscape. Limit the removal of lawn areas to mulched planting beds or pervious hardscapes in locations where they would historically be found, such as along fences, walkways, or drives. Low-growing plantings should be used in historic lawn areas; invasive or large-scale species should be avoided. Historic lawn areas should never be reduced by more than 50%.
- *iii.* Native xeric plant materials—Select native and/or xeric plants that thrive in local conditions and reduce watering usage. See UDC Appendix E: San Antonio Recommended Plant List—All Suited to Xeriscape Planting Methods, for a list of appropriate materials and planting methods. Select plant materials with a similar character, growth habit, and light requirements as those being replaced.
- *iv. Plant palettes*—If a varied plant palette is used, incorporate species of taller heights, such informal elements should be restrained to small areas of the front yard or to the rear or side yard so as not to obstruct views of or otherwise distract from the historic structure.
- v. *Maintenance*—Maintain existing landscape features. Do not introduce landscape elements that will obscure the historic structure or are located as to retain moisture on walls or foundations (e.g., dense foundation plantings or vines) or as to cause damage.

### B. ROCKS OR HARDSCAPE

- *i. Impervious surfaces* —Do not introduce large pavers, asphalt, or other impervious surfaces where they were not historically located.
- *ii. Pervious and semi-pervious surfaces*—New pervious hardscapes should be limited to areas that are not highly visible, and should not be used as wholesale replacement for plantings. If used, small plantings should be incorporated into the design.
- *iii.* Rock mulch and gravel Do not use rock mulch or gravel as a wholesale replacement for lawn area. If used, plantings should be incorporated into the design.

### D. TREES

- *i. Preservation*—Preserve and protect from damage existing mature trees and heritage trees. See UDC Section 35-523 (Tree Preservation) for specific requirements.
- *ii.* New Trees Select new trees based on site conditions. Avoid planting new trees in locations that could potentially cause damage to a historic structure or other historic elements. Species selection and planting procedure should be done in accordance with guidance from the City Arborist.
- 5. Sidewalks, Walkways, Driveways, and Curbing

### A. SIDEWALKS AND WALKWAYS

- *i. Maintenance*—Repair minor cracking, settling, or jamming along sidewalks to prevent uneven surfaces. Retain and repair historic sidewalk and walkway paving materials—often brick or concrete—in place.
- *ii. Replacement materials*—Replace those portions of sidewalks or walkways that are deteriorated beyond repair. Every effort should be made to match existing sidewalk color and material.
- *iii.* Width and alignment—Follow the historic alignment, configuration, and width of sidewalks and walkways. Alter the historic width or alignment only where absolutely necessary to accommodate the preservation of a significant tree.
- *iv. Stamped concrete*—Preserve stamped street names, business insignias, or other historic elements of sidewalks and walkways when replacement is necessary.
- v. ADA compliance—Limit removal of historic sidewalk materials to the immediate intersection when ramps are added to address ADA requirements.

### **B. DRIVEWAYS**

- i. Driveway configuration—Retain and repair in place historic driveway configurations, such as ribbon drives. Incorporate a similar driveway configuration—materials, width, and design—to that historically found on the site. Historic driveways are typically no wider than 10 feet. Pervious paving surfaces may be considered where replacement is necessary to increase stormwater infiltration.
- *ii. Curb cuts and ramps*—Maintain the width and configuration of original curb cuts when replacing historic driveways. Avoid introducing new curb cuts where not historically found.

### 7. Off-Street Parking

### A. LOCATION

- i. Preferred location—Place parking areas for non-residential and mixed-use structures at the rear of the site, behind primary structures to hide them from the public right-of-way. On corner lots, place parking areas behind the primary structure and set them back as far as possible from the side streets. Parking areas to the side of the primary structure are acceptable when location behind the structure is not feasible. See UDC Section 35-310 for district-specific standards. ii. Front—Do not add off-street parking areas within the front yard setback as to not disrupt the continuity of the streetscape.
- *iii.* Access—Design off-street parking areas to be accessed from alleys or secondary streets rather than from principal streets whenever possible.

### **B. DESIGN**

- *i. Screening*—Screen off-street parking areas with a landscape buffer, wall, or ornamental fence two to four feet high—or a combination of these methods. Landscape buffers are preferred due to their ability to absorb carbon dioxide. See UDC Section 35-510 for buffer requirements.
- *ii. Materials*—Use permeable parking surfaces when possible to reduce run-off and flooding. See UDC Section 35-526(j) for specific standards.
- *iii. Parking structures*—Design new parking structures to be similar in scale, materials, and rhythm of the surrounding historic district when new parking structures are necessary.

### **FINDINGS:**

### General Findings:

a. DESIGN REVIEW COMMITTEE – This request was reviewed by the Design Review Committee on March 13, 2018. At that meeting, committee members noted a concern regarding lack of fenestration and the small windows on side elevations. This request was reviewed a second time by the DRC on May 8, 2018. At that meeting, the

- commissioners noted that a clad wood window was most appropriate for new construction. The commissioners were noted that the proposed setbacks were appropriate and were comfortable with the proposed modifications to the porch designs.
- b. CONTEXT This block of Hays Street is relatively intact featuring both Victorian and Craftsman style structures. Two, two story, four square structures exist on the north side of the street.

### Findings related to request item #1:

- 1a. The applicant is requesting a Certificate of Appropriateness for the construction of one, two story residential structure on the vacant lot at 725 Hays.
- 1b. SETBACKS & ORIENTATION According to the Guidelines for New Construction, the front facades of new buildings are to align with front facades of adjacent buildings where a consistent setback has been established along the street frontage. Additionally, the orientation of new construction should be consistent with the historic examples found on the block. The applicant has noted that setbacks on this block of Hays consist of 29, 31, 31.6, 36.5 and 36.7 feet. The applicant has proposed a setback of 31' 6", which per the application documents is matching or greater than three of the existing structures on the block. Generally, staff finds the proposed setbacks to be appropriate.
- 1c. ENTRANCES According to the Guidelines for New Construction 1.B.i., primary building entrances should be oriented towards the primary street. The proposed entrance is appropriate and consistent with the Guidelines.
- 1d. SCALE & MASS Per the Guidelines for New Construction 2.A.i., a height and massing similar to historic structures in the vicinity of the proposed new construction should be used. In residential districts, the height and scale of new construction should not exceed that of the majority of historic buildings by more than one-story. This block of Hays features two, two story historic structure on the north side of the block. Generally, the proposed scale and massing is appropriate.
- 1e. FOUNDATION & FLOOR HEIGHTS According to the Guidelines for New Construction 2.A.iii., foundation and floor height should be aligned within one (1) foot of neighboring structure's foundation and floor heights. The applicant has provided elevations that note a foundation height of approximately 14 inches. Neighboring structures feature foundation heights of approximately two to three feet. Generally, the proposed foundation height is consistent with the Guidelines.
- 1f. ROOF FORM The applicant has modified the previously proposed roof form to feature a hipped roof. The newly proposed roof form will not feature a rear profile that is larger in massing than that of the front roof profile. Staff finds the newly proposed roof form to be appropriate.
- 1g. WINDOW & DOOR OPENINGS Per the Guidelines for New Construction 2.C.i., window and door openings with similar proportions of wall to window space as typical with nearby historic facades should be incorporated into new construction. The applicant has modified previously proposed window openings to include a full sash windows on each façade rather than a combination of fixed and sash windows. Staff finds the proposed windows to be appropriate and consistent with the Guidelines. Staff finds that the applicant should explore the installation of a window to the right of the front door.
- 1h. LOT COVERAGE Per the Guidelines, the building footprint for new construction should be no more than fifty (50) percent of the size of the total lot area. Generally, staff finds the proposed lot coverage to be appropriate.
- 1i. MATERIALS The applicant has proposed materials that include horizontal composition siding and an asphalt shingle roof. The applicant has proposed siding profiles of both four and six inches. While staff finds a four inch exposure to be most appropriate, a six inch exposure may be appropriate. All composition should feature a smooth finish.
- 1j. WINDOW MATERIALS The applicant has proposed vinyl windows to feature a minimum of two inches in depth between the front face of the window trim and the front face of the top window sash. Staff finds the proposed window material to be inconsistent with the Guidelines. Per the Guidelines, an aluminum-clad wood window is most appropriate in terms of depth and appearance. Window trim must feature traditional dimensions and an architecturally appropriate sill detail. Window track components must be painted to match the window trim or concealed by a wood window screen set within the opening.
- 1k. WINDOW TRIM The applicant has noted the installation of window trim to include 2x4 and 2x6 dimensional lumber. This trim detail has been used by the applicant previously.
- 11. PORCH DESIGN The applicant has proposed a porch featuring a depth of approximately 8' 5" with wood columns feature brick bases. Wood columns featuring brick bases are found a multiple houses on this block of Hays. The proposed wood columns will feature eight inch square dimensions. The proposed brick bases and brick wall will feature heights of approximately 4 feet and 3 feet. Staff finds this to be appropriate. Additionally, the applicant has updated the proposed porch design to include a full width porch.

- 1m. ARCHITECTURAL DETAILS The applicant has addressed many of staff's previous concerns regarding architectural details. The applicant should ensure that all double windows are separated by a horizontal mullion of at least six inches in width.
- 1n. DRIVEWAY The applicant has proposed a ribbon strip driveway to the right of the proposed new construction, matching the historic driveway locations on the block. Staff finds the use of concrete appropriate. Driveway widths should not exceed ten (10) feet in width per the Guidelines for Site Elements.

### Findings related to request item #2:

- 2a. The applicant is requesting a Certificate of Appropriateness for the construction of one, two story residential structure on the vacant lot at 729 Hays.
- 2b. SETBACKS & ORIENTATION According to the Guidelines for New Construction, the front facades of new buildings are to align with front facades of adjacent buildings where a consistent setback has been established along the street frontage. Additionally, the orientation of new construction should be consistent with the historic examples found on the block. The applicant has noted that setbacks on this block of Hays consist of 29, 31, 31.6, 36.5 and 36.7 feet. The applicant has proposed a setback of 31' 6", which per the application documents is matching or greater than three of the existing structures on the block. Generally, staff finds the proposed setbacks to be appropriate.
- 2c. ENTRANCES According to the Guidelines for New Construction 1.B.i., primary building entrances should be oriented towards the primary street. The proposed entrance is appropriate and consistent with the Guidelines.
- 2d. SCALE & MASS Per the Guidelines for New Construction 2.A.i., a height and massing similar to historic structures in the vicinity of the proposed new construction should be used. In residential districts, the height and scale of new construction should not exceed that of the majority of historic buildings by more than one-story. This block of Hays features two, two story historic structure on the north side of the block. Generally, the proposed scale and massing is appropriate.
- 2e. FOUNDATION & FLOOR HEIGHTS According to the Guidelines for New Construction 2.A.iii., foundation and floor height should be aligned within one (1) foot of neighboring structure's foundation and floor heights. The applicant has provided elevations that note a foundation height of approximately one foot to 2.5 feet. Neighboring structures feature foundation heights of approximately two to three feet. Generally, the proposed foundation height is consistent with the Guidelines.
- 2f. ROOF FORM The applicant has modified the previously proposed roof form to feature a front facing gabled roof and hipped roof. The newly proposed roof form will not feature a rear profile that is larger in massing than that of the front roof profile. Staff finds the newly proposed roof form to be appropriate.
- 2g. WINDOW & DOOR OPENINGS Per the Guidelines for New Construction 2.C.i., window and door openings with similar proportions of wall to window space as typical with nearby historic facades should be incorporated into new construction. The applicant has modified previously proposed window openings to include a full sash windows on each façade rather than a combination of fixed and sash windows. Staff finds the proposed windows to be appropriate and consistent with the Guidelines. Staff finds that the applicant should explore the installation of a window to the right of the front door.
- 2h. LOT COVERAGE Per the Guidelines, the building footprint for new construction should be no more than fifty (50) percent of the size of the total lot area. Generally, staff finds the proposed lot coverage to be appropriate.
- 2i. MATERIALS The applicant has proposed materials that include an asphalt shingle roof, board and batten siding and horizontal composition siding to feature an exposure of six inches. The board and batten siding should feature boards that are twelve (12) inches wide with battens that are  $1 \frac{1}{2}$  wide. While staff finds a four inch exposure to be most appropriate, a six inch exposure may be appropriate. All composition should feature a smooth finish.
- 2j. WINDOW MATERIALS The applicant has proposed vinyl windows to feature a minimum of two inches in depth between the front face of the window trim and the front face of the top window sash. Staff finds the proposed window material to be inconsistent with the Guidelines. Per the Guidelines, an aluminum-clad wood window is most appropriate in terms of depth and appearance. Window trim must feature traditional dimensions and an architecturally appropriate sill detail. Window track components must be painted to match the window trim or concealed by a wood window screen set within the opening.WINDOW TRIM The applicant has noted the installation of window trim to include 2x4 and 2x6 dimensional lumber. This trim detail has been used by the applicant previously.
- 2k. PORCH DESIGN The applicant has proposed a front porch with a depth of approximately 8' 0". Staff finds the proposed depth and eight inch square columns appropriate. Additionally, the applicant has increased the width of the proposed front porch to span the entire front façade.

- 21. ARCHITECTURAL DETAILS The applicant has addressed many of staff's previous concerns regarding architectural details. The applicant should ensure that all double windows are separated by a horizontal mullion of at least six inches in width.
- 2m. DRIVEWAY The applicant has proposed a ribbon strip driveway to the right of the proposed new construction, matching the historic driveway locations on the block. Staff finds the use of concrete appropriate. Driveway widths should not exceed ten (10) feet in width per the Guidelines for Site Elements.

### Findings related to request item #3:

- 3a. The applicant is requesting a Certificate of Appropriateness for the construction of one, two story residential structure on the vacant lot at 901 N Pine.
- 3b. SETBACKS & ORIENTATION According to the Guidelines for New Construction, the front facades of new buildings are to align with front facades of adjacent buildings where a consistent setback has been established along the street frontage. Additionally, the orientation of new construction should be consistent with the historic examples found on the block. The proposed new construction is a corner lot. The applicant has proposed a setback of 34' 7", which is comparable to those found historically on this block of N Pine; however, the side setback proposed on Hays Street is only 25' 2". While this matches the side setback of the historic structure across N Pine, it is less than the front setback of both proposed and existing structures that front Hays. Staff finds this proposed side setback to be inappropriate.
- 3c. ENTRANCES According to the Guidelines for New Construction 1.B.i., primary building entrances should be oriented towards the primary street. The proposed entrance is appropriate and consistent with the Guidelines.
- 3d. SCALE & MASS Per the Guidelines for New Construction 2.A.i., a height and massing similar to historic structures in the vicinity of the proposed new construction should be used. In residential districts, the height and scale of new construction should not exceed that of the majority of historic buildings by more than one-story. This block of N Pine features all single story structure; however, two story structures exist in the immediate vicinity on the 800 block of N Pine as well as the 700 block of Hays. Staff finds the proposed height appropriate.
- 3e. FOUNDATION & FLOOR HEIGHTS According to the Guidelines for New Construction 2.A.iii., foundation and floor height should be aligned within one (1) foot of neighboring structure's foundation and floor heights. The applicant has provided elevations that note a foundation height of approximately one foot to 2.5 feet. Neighboring structures feature foundation heights of approximately two to three feet. Generally, the proposed foundation height is consistent with the Guidelines.
- 3f. ROOF FORM —The applicant has proposed a roof form to include a hipped roof with a a rear roof form that features a half hipped, half gabled roof. At the rear, the applicant has proposed a compound roof to feature both a dipped and gabled roof, resulting in an increased roof height from what is featured on the front of the structure. Staff finds that the rear roof form should either feature a hip or gable that has a height consistent with that found on the front of the structure. This would also match roof forms found historically on the block.
- 3g. WINDOW & DOOR OPENINGS Per the Guidelines for New Construction 2.C.i., window and door openings with similar proportions of wall to window space as typical with nearby historic facades should be incorporated into new construction. The applicant has modified previously proposed window openings to include a full sash windows on each façade rather than a combination of fixed and sash windows. Staff finds the proposed windows to be appropriate and consistent with the Guidelines. Staff finds that the applicant should explore the installation of a window to the right of the front door.
- 3h. LOT COVERAGE Per the Guidelines, the building footprint for new construction should be no more than fifty (50) percent of the size of the total lot area. Generally, staff finds the proposed lot coverage to be appropriate.
- 3i. MATERIALS The applicant has proposed materials that include horizontal composition siding and an asphalt shingle roof. The applicant has proposed siding profiles of both four and six inches. While staff finds a four inch exposure to be most appropriate, a six inch exposure may be appropriate. All composition should feature a smooth finish.
- 3j. WINDOW MATERIALS The applicant has proposed vinyl windows to feature a minimum of two inches in depth between the front face of the window trim and the front face of the top window sash. Staff finds the proposed window material to be inconsistent with the Guidelines. Per the Guidelines, an aluminum-clad wood window is most appropriate in terms of depth and appearance. Window trim must feature traditional dimensions and an architecturally appropriate sill detail. Window track components must be painted to match the window trim or concealed by a wood window screen set within the opening.
- 3k. WINDOW TRIM The applicant has noted the installation of window trim to include 2x4 and 2x6 dimensional lumber. This trim detail has been used by the applicant previously.
- 31. PORCH DESIGN The applicant has proposed a front porch with a depth of 8' 0". Additionally, the applicant

has proposed brick and wood columns. Generally staff finds the proposed porch depth and column design appropriate; however, staff finds that a full width porch would be most appropriate to relate to the historic, two story Craftsman houses in the immediate vicinity.

- 3m. ARCHITECTURAL DETAILS As noted in findings 3f, 3g and 3l, staff finds that the proposed roof form should be modified to not feature a compound roof at the rear, the additional fenestration should be added, that windows on the front façade should feature sashes and that the proposed front porch should span the width of the house. Additionally, staff finds that the applicant should ensure that all double windows are separated by a horizontal mullion of at least six inches in width.
- 3n. DRIVEWAY The applicant has modified the previously proposed double width driveway to now feature a width comparable to those found historically in the district. Staff finds the proposed concrete to the appropriate. Driveway widths should not exceed ten (10) feet in width per the Guidelines for Site Elements.

### **RECOMMENDATION:**


- 1. Staff recommends approval based on findings 1a through 1n with the following stipulations:
  - i. That the applicant explore the installation of a window to the right of the front door as noted in finding 1g.
  - ii. That all composition siding feature a smooth finish and that the applicant provide staff with historic examples of siding with six inch exposures in the immediate area to ensure that an appropriate profile and detail is proposed as noted in finding 1i.
  - iii. That the proposed windows be aluminum-clad wood windows and follow staff's specifications. White manufacturer's color is not allowed, and color selection must be presented to staff. There should be a minimum of two inches in depth between the front face of the window trim and the front face of the top window sash. This must be accomplished by recessing the window sufficiently within the opening or with the installation of additional window trim to add thickness. Window trim must feature traditional dimensions and an architecturally appropriate sill detail. Window track components must be painted to match the window trim or concealed by a wood window screen set within the opening.
  - iv. That all double windows are separated by wood mullions featuring at least six inches in width as noted in finding 1m.
  - v. That the proposed concrete driveway does not exceed ten (10) feet in width as noted in finding 1n.
- 2. Staff recommends approval of item #2 based on findings 2a through 2n with the following stipulations:
  - i. That the applicant explore the installation of a window to the right of the front door as noted in finding 2g.
  - ii. That all composition siding feature a smooth finish and that the applicant provide staff with historic examples of siding with six inch exposures in the immediate area to ensure that an appropriate profile and detail is proposed as noted in finding 2i.
  - iii. That the proposed windows be aluminum-clad wood windows and follow staff's specifications. White manufacturer's color is not allowed, and color selection must be presented to staff. There should be a minimum of two inches in depth between the front face of the window trim and the front face of the top window sash. This must be accomplished by recessing the window sufficiently within the opening or with the installation of additional window trim to add thickness. Window trim must feature traditional dimensions and an architecturally appropriate sill detail. Window track components must be painted to match the window trim or concealed by a wood window screen set within the opening.
  - iv. That all double windows are separated by mullions featuring at least six inches in width as noted in finding 2m.
  - v. That the proposed concrete driveway does not exceed ten (10) feet in width as noted in finding 2n.
- 3. Staff recommends approval of item #3 based on findings 3a through 3n with the following stipulations:
  - i. That the applicant explore the installation of a window to the right of the front door as noted in finding 2g.
  - ii. That all composition siding feature a smooth finish and that the applicant provide staff with historic examples of siding with six inch exposures in the immediate area to ensure that an appropriate profile and detail is proposed as noted in finding 2i.
  - iii. That the proposed windows be aluminum-clad wood windows and follow staff's specifications. White manufacturer's color is not allowed, and color selection must be presented to staff. There should be a

minimum of two inches in depth between the front face of the window trim and the front face of the top window sash. This must be accomplished by recessing the window sufficiently within the opening or with the installation of additional window trim to add thickness. Window trim must feature traditional dimensions and an architecturally appropriate sill detail. Window track components must be painted to match the window trim or concealed by a wood window screen set within the opening.

- iv. That all double windows are separated by mullions featuring at least six inches in width as noted in finding 2m.
- v. That the proposed concrete driveway does not exceed ten (10) feet in width as noted in finding 2n.
- vi. That the side setback on Hays Street be increased as noted in finding 3b.
- vii. That the current roof form be modified to more closely relate to the design updates found on the request items noted in #1 and #2 as noted in finding 3f.

### **CASE MANAGER:**

**Edward Hall** 

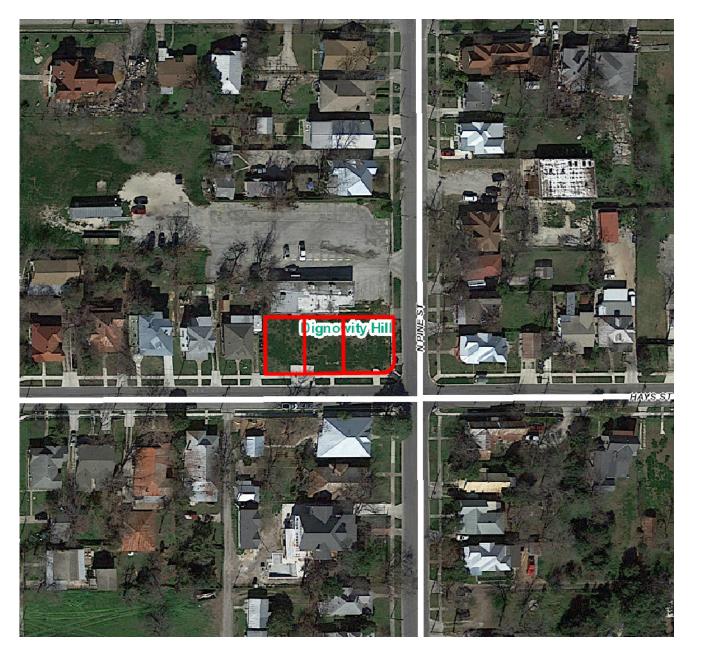



### Flex Viewer

Powered by ArcGIS Server

Printed:Mar 09, 2018

The City of San Antonio does not guarantee the accuracy, adequacy, completeness or usefulness of any information. The City does not warrant the completeness, timeliness, or positional, thematic, and attribute accuracy of the GIS data. The GIS data, cartographic products, and associated applications are not legal representations of the depicted data. Information shown on these maps is derived from public records that are constantly undergoing revision. Under no circumstances should GIS-derived products be used for final design purposes. The City provides this information on an "as is" basis without warranty of any kind, express or implied, including but not limited to warranties of merchantability or fitness for a particular purpose, and assumes no responsibility for anyone's use of the information.







## **OHP SUBMISSION**

725 HAYS, 729 HAYS, 901 PINE San Antonio, TX

MAY. 01, 2018



Hays Corner Street View



Building Communities
Not Just Homes
905 N. Pine

San Antonio, TX 78202 - 210.588.9212

PROJECT DATA	
OURRENT ZONING	15.7
CURRENT ZONING:	IDZ
LAND AREA:	0.22 Ac.
TOTAL LOTS:	3
TOTAL UNITS PER LOT:	1
TOTAL UNITS:	3
UNITS PER ACRE:	13.6
PARKING PER UNIT:	2
TOTAL PARKING:	6

TABLE OF CONTENTS		
SHEET#	DESCRIPTION	
0 1 2 3 4 5 6 -14 15- 23 24- 32 33	COVERSHEET AERIAL MAP RECORDED PLAT CONTEXT & BUILDING SETBACKS MASTER SITE PLAN LANDSCAPING & FENCING PLAN 725 HAYS 729 HAYS 901 PINE TYPICAL WINDOW DETAILS	






DATE CHANGE	BY
04/06/18 HDRC FINAL SUBMITTAL	LB
05/01/18 OHP REDLINES	LB
	-

# TERRAMARK URBAN HOMES

725 HAYS 729 HAYS 901 PINE

**AERIAL MAP** 

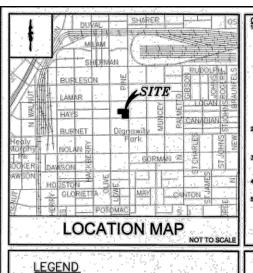

C.P.S. NOTES

1. THE CITY OF SAN ANTONIO AS A PART OF ITS ELECTRIC AND GAS SYSTEM
(CITY PUBLIC SERVICE BOARD) IS HEREBY DEDICATED THE EASEMBITE AND
RIGHTS-OF-WAY FOR ELECTRIC AND GAS DISTRIBUTION AND SERVICE
FACILITIES IN THE AREAD DESIGNATED ON THIS PLAT AS "ELECTRIC
EASEMENT," OAS EASEMENT, "NOTION EASEMENT," SERVICE EASEMENT,












SURVEY NOTE:

1. BASS OF BERRINGS IS THE TEXAS STATE PLANE COORDINATE SYSTEM, IND. 1983, SOUTH CENTRAL ZONE (4204). ALL DISTANCES SHOWN HEREON ARE GROUND

NISHED FLOOR NOTE:
RESIDENTIAL FINISHED FLOOR ELEVATIONS MUST BE A MINIMUM OF 8 INCHES
ABOVE FINISHED ADJACENT GRADE.

C. NOTES: LOT OWNER(S) SHALL PROVIDE SHARED COMMON CROSS ACCESS IN ACCIRDANCE WITH UDC 35-508(7)(3).

STATE OF TEXAS COUNTY OF BEXAR

AINTENANCE NOTE:
THE MAINTENANCE OF ALL PRIVATE STREETS, OPEN SPACE, GREENBELTS,
PARKS, DRAINAGE EASEMENTS AND EASEMENTS OF ANY NATURE WITHIN PINE

BEFORE ME, THE UNDERSIGNED AUTHORITY ON THIS DAY PERSONNAL T PAPEARS.

CHAPLES H. TURNER.

KNOWN TO ME TO BE THE PERSONN

WICE MAKE IS SUBSPICIED TO THE POPEROON DISTRIBUTION AND

ADMINISTRATIONS THEREIN EXPRESSED AND IN THE CAPACITY THEREIN STATED.

GIVEN UNDER MY HAND AND SEAL OF OFFICE THIS

DAY OF NOVEM DET.

AD 2017


NOTARY FUELIC BEXAR COUNTY (TEXAS)

### PLAT NUMBER 170543

### SUBDIVISION PLAT **ESTABLISHING**

PINE AT HAYS (IDZ)

BEING A TOTAL OF 0.8316 ACRES OF LAND, INCLUSIVE OF A 0.0011
ACRE RIGHT OF WAY DEDICATION TO THE CITY OF SAN ANTONIO,
ESTABLISHING LOTS 20-28 AND LOT 901, BLOCK 13, N.C.B. 531, SAID
0.8316 ACRES BEING A PORTION OF A 0.97 ACRE TRACT, DEED OF
TRUST RECORDED IN VOLUME 3306, PAGE 1530, OFFICIAL PUBLIC
RECORDS OF BEXAR COUNTY, TEXAS

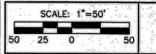






STATE OF TEXAS

BEFORE IS, THE UNDERSIGNED AUTHORITY ON THIS DAY PERSONALLY APPEARED CHAPLES IF TURNER NORTH TO BE THE PERSON WIGGE NAME IS DESCRIBED TO THE FOREGOING INSTRUMENT, AND ACKNOWLEDGE 




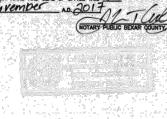

13 DAY OF DECEMBER 10 2017

LEVELA RICEDO COUNTY CLERK OF SAID COUNTY, DO HEREBY LEVELAND THAT THIS PLAT WAS FILED FOR RECORD IN MY OFFICE ON THE 242 DAY OF JANUARY AD. 2016 AT 9:28 AM. AND DULY RECORDED THE 242 DAY OF JANUARY AD. 2016 AT 9:28 AM. IN THE 252 DAY OF SAID COUNTY, IN BOOK / VOLUME 9722 ON PAGE WITH THE SAID COUNTY WHEREOF, WITHESS MY HAND AND OFFICIAL SEAL OF OFFICE, THIS 7/11 DAY OF JANUARY

BY: () (SSIE) NOVEMBER 2017 SHEET 1 OF 1

Ш Σ I Z  $\triangleleft$ m C

DATE CHANGE

05/01/18 OHP REDLINES

04/06/18 HDRC FINAL SUBMITTAL

LB

**725 HAYS 729 HAYS 901 PINE** 

PLAT # 170543 SUBDIVISION PLAT

PINE AT HAYS (IDZ)

SHEET 2

= PROPOSED BOUNDARY - EXISTING BOUNDARY

= CENTERLINE

= FOUND 1/2" IRON PIN CONTROLLING
 MONUMENTATION
 (UNLESS NOTED OTHERWISE)
 = IRON PIN SET WITH CAP
 STAMPED "TGD SURVEYING"

E.G.T.C. = ELECTRIC, GAS, TELE, & CABLE TV E.T.C. = ELECTRIC, TELE & CABLE TV

O.P.R.B.C.T. = OFFICIAL PUBLIC RECORDS OF BEXAR COUNTY TEXAS D.P.R. = DEED AND PLAT RECORDS OF BEXAR COUNTY TEXAS

N.C.B. = NEW CITY BLOCK ROW = RIGHT OF WAY

E = CENTERLINE - - 1760 - EXISTING CONTOUR ---- = PROPOSED EASEMENT ----- = EXISTING EASEMENT

UNPLATED ARBITRATY
4, 4 1/2, AND A PORTION O
ARBITRARY LOT 12,
K/T TX HOLDINGS, LLC
17808/473 O.P.R.B.O.T. WHILATED PORTION OF ARBITRARY LUT AB, K/T DI HOLDINGS, LLC 17809/473 O.P.R.B.C.T. HAYS STREET


SUBJECT AREA'
BEING 0.8327 ACRES
OF A PORTION OF ARBITRARY LOTS 4, 4-1/2 & 12, BLOCK 13, NCB
531, SAN ANTONIO, TEXAS AS DESCRIBED IN VOL. 17809, PG. 473; A
PORTION OF ARBITRARY LOTS AB AND 12, BLOCK 13 NCB 531, SAN
ANTONIO, TEXAS AS DESCRIBED IN VOL. 18202, FG 525; A PORTION
OF ARBITRARY LOT AB, BLOCK 13 NCB 531, SAN ANTONIO, TEXAS AS
DESCRIBED IN VOL. 17609, PG. 473, ALL OF THE DEED RECORDS OF
BEXAR COUNTY, TEXAS.

P12-20180014790-7

TASHA F. UHLRICI

89502

STATE OF TEXAS COUNTY OF BEXAR

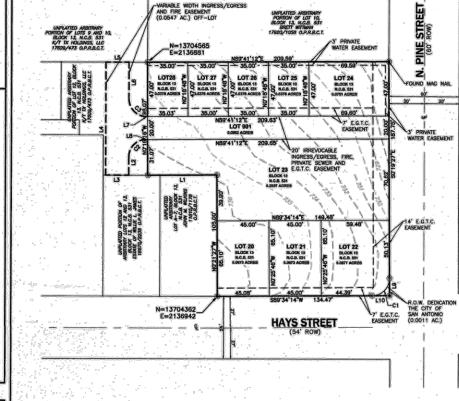

40		LINE T	ABLE
	LINE	LENGTH	BEARING
	L1	60.17	S89*38'33"W
00	L2	16.17	S00'00'00"E
	L3	20.00'	S89'38'33"W
,	L4	98.10	N00'00'00"E
0	L5	20.00	N89'41'12"E
6.	L6	31.91	N00'00'00"E
	L7	1.26'	N89'59'29"W
	LB	1.36	N90'00'00"W
	L9	14.97	S00'19'27"E
åi	L10	14.97	S89'34'14"W


CURVE TABLE					
CURVE	RADIUS	LENGTH	DELTA	CHORD	CHORD BEARING
C1	15.00"	23.53"	89'53'41"	21.19'	N44'37'24"E
C2	15.00	23.56'	90,00,00,	21.21	\$45'00'00"W
C3	15.00'	23.56'	90,00,00	21.21	S45'00'00"E










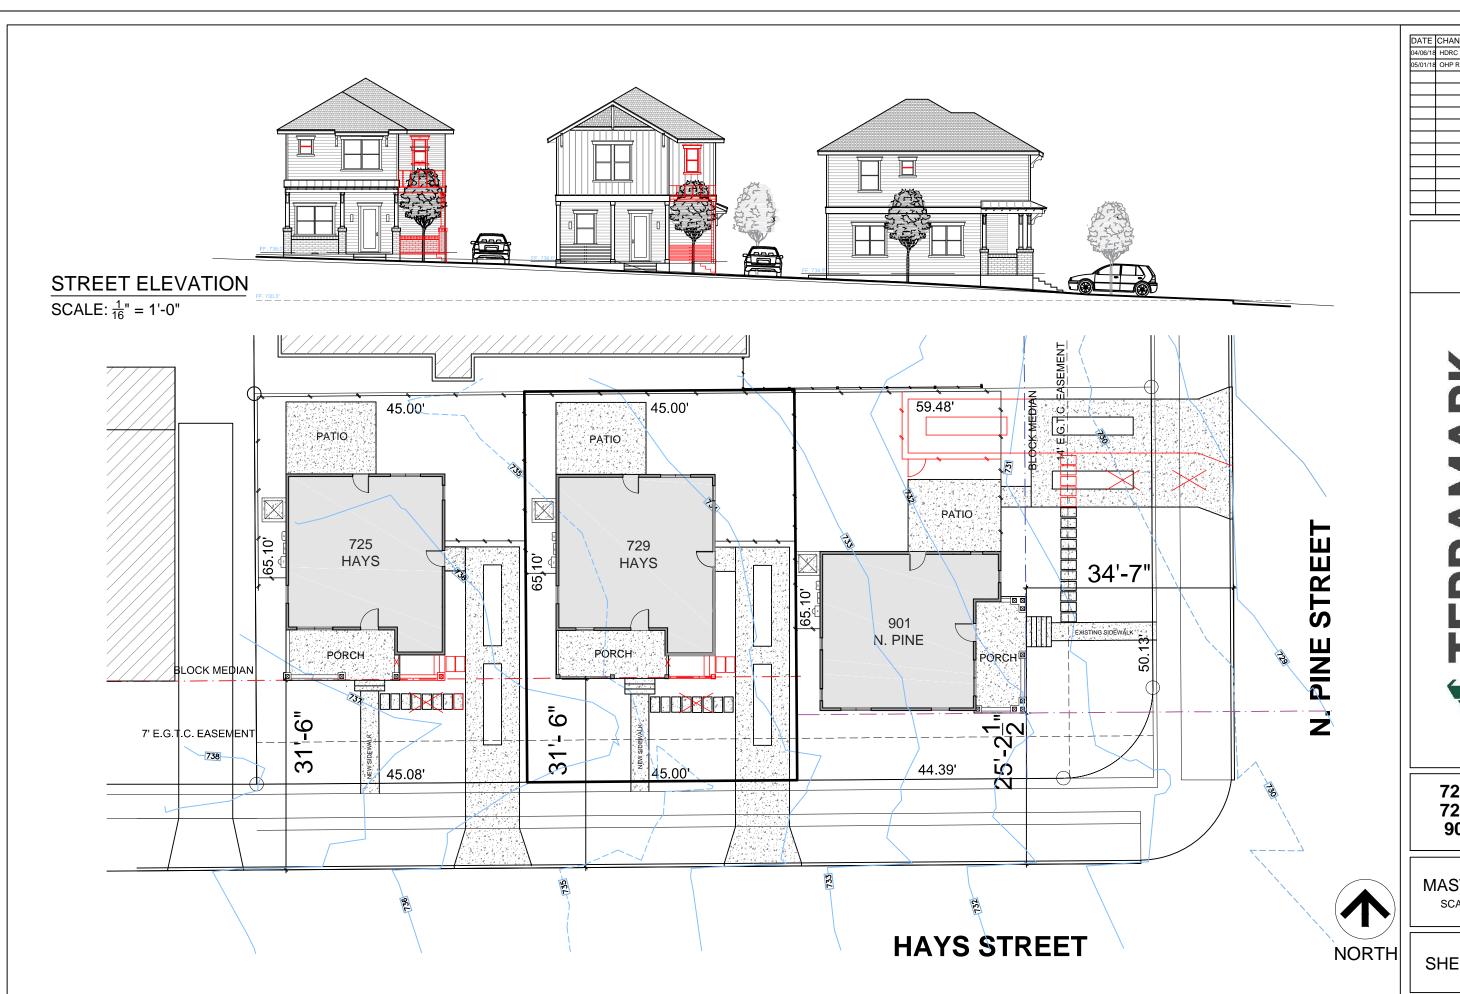

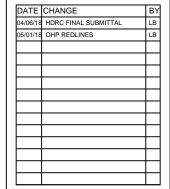



**725 HAYS 729 HAYS 901 PINE** 

MASTER PLAN SCALE:  $\frac{1}{16}$ " = 1'-0"





725 HAYS 729 HAYS **901 PINE** 

LANDSCAPE PLAN SCALE:  $\frac{1}{16}$ " = 1'-0"

NORTH

# 725 HAYS STREET PLAT No: 170543



SQUARE FOOTAGE CALCULATION		
AREA	SQUARE FEET	
1ST FLOOR LIVING	724	
2ND FLOOR LIVING	802	
TOTAL LIVING	1526	
PORCH	155	
SLAB	879	
TOTAL STRUCTURE	1681	


TABLE OF CONTENTS			
SHEET#	DESCRIPTION		
6	COVERSHEET		
7	SITE PLAN		
8	FLOOR 01		
9	FLOOR 02		
10	ROOF PLAN		
11	FRONT ELEV.		
12	REAR ELEV.		
13	LEFT ELEV.		
14	RIGHT ELEV.		

DATE	CHANGE	BY
04/06/18	HDRC FINAL SUBMITTAL	LB
05/01/18	OHP REDLINES	LB



**725 HAYS** 

COVERPAGE

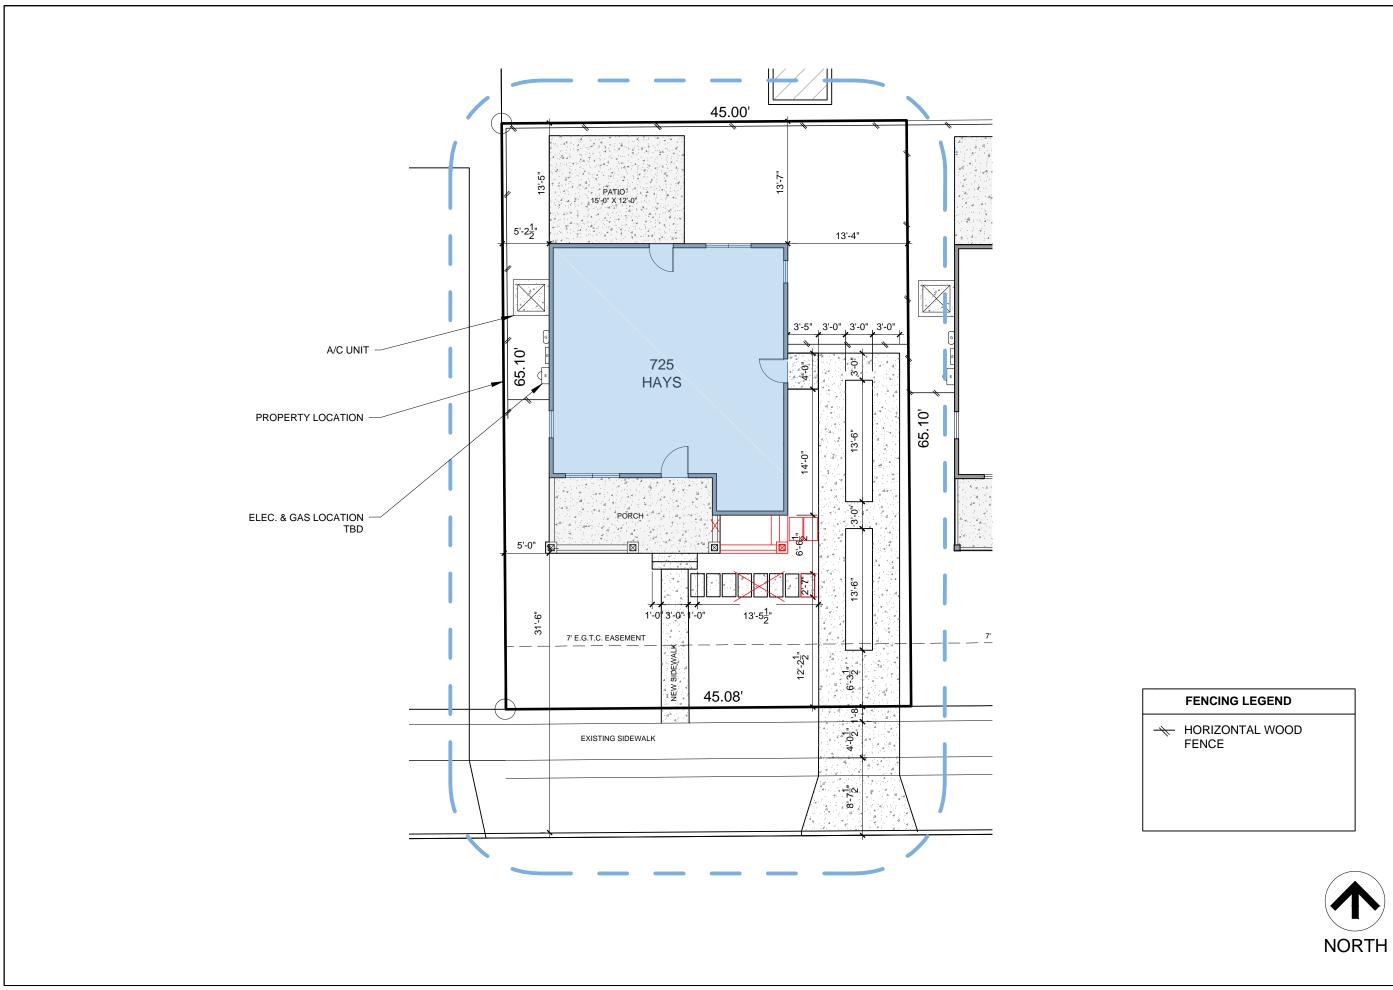

 DATE
 CHANGE
 BY

 03/28/18
 20% REVIEW SET CREATED
 LB

 04/16/18
 20% REVIEW SET CREATED
 LB

 04/17/18
 HDRC REDLINES
 LB

 04/27/18
 20% REVIEW SET
 LB

 05/01/18
 OHP REDLINES
 LB



**725 HAYS** 

SITE PLAN


SCALE:  $\frac{3}{32}$ " = 1'-0"



	50%		HEDULE	
Size	Туре	Level	Int/Ext	Location
2080	Single	1	Interior	Ptry.
2080	Single	1	Interior	Storage
2480	Single	1	Interior	Pwdr.
2880	Single	1	Exterior	Entry/ Right
2880	Single	1	Exterior	Entry/ Rear
3080	Single	1	Exterior	Entry/ Front
1668	Single	2	Interior	Linen
2068	Single	2	Interior	WIC
2468	Single	2	Interior	Mastr. Bath
2468	Single	2	Interior	Bath2 / Hall
2468	Single	2	Interior	Bath2/ Bdrm. 3
2868	Single	2	Interior	Mastr. Bdrm.
2868	Single	2	Interior	Bdrm.3
2868	Single	2	Interior	Bdrm.2
4068	Dbl Door	2	Interior	Bdrm.2/Clos.
4068	Dbl Door	2	Interior	Bdrm.2/Clos.
5068	Dbl Bi-Fold	2	Interior	Utility

### WINDOW SCHEDULE

Size	Туре	Level	Height	Location
2650	SH	1	8' Hdr. Ht.	Living Room
2650	SH	1	8' Hdr. Ht.	Living Room
2650	SH	1	8' Hdr. Ht.	Living Room
3050	SH	1	8' Hdr. Ht.	Dining
3050	SH	1	8' Hdr. Ht.	Dining
3050	SH	1	8' Hdr. Ht.	Dining
2026	FX	2	7'- 4" Hdr. Ht.	Bdrm.2
2026	FX	2	7'- 4" Hdr. Ht.	Bdrm.2
2026	FX	2	7'- 4" Hdr. Ht.	Bdrm.3
2026	FX	2	7'- 4" Hdr. Ht.	Bdrm.3
2026	FX - Temp - OBS	2	7'- 4" Hdr. Ht.	Bath 2
2026	FX - Temp - OBS	2	7'- 4" Hdr. Ht.	M. Bath
2026	FX - Temp	2	7'- 4" Hdr. Ht.	M. Bath
2040	SH	2	17' Hdr. Ht.	Stairs
2040	SH	2	17' Hdr. Ht.	Stairs
3050	SH - Egress	2	7'- 4" Hdr. Ht.	Master Bdrm.
3050	SH - Egress	2	7'- 4" Hdr. Ht.	Master Bdrm.
3050	SH - Egress	2	7'- 4" Hdr. Ht.	Bdrm.2
3050	SH - Egress	2	7'- 4" Hdr. Ht.	Bdrm.3

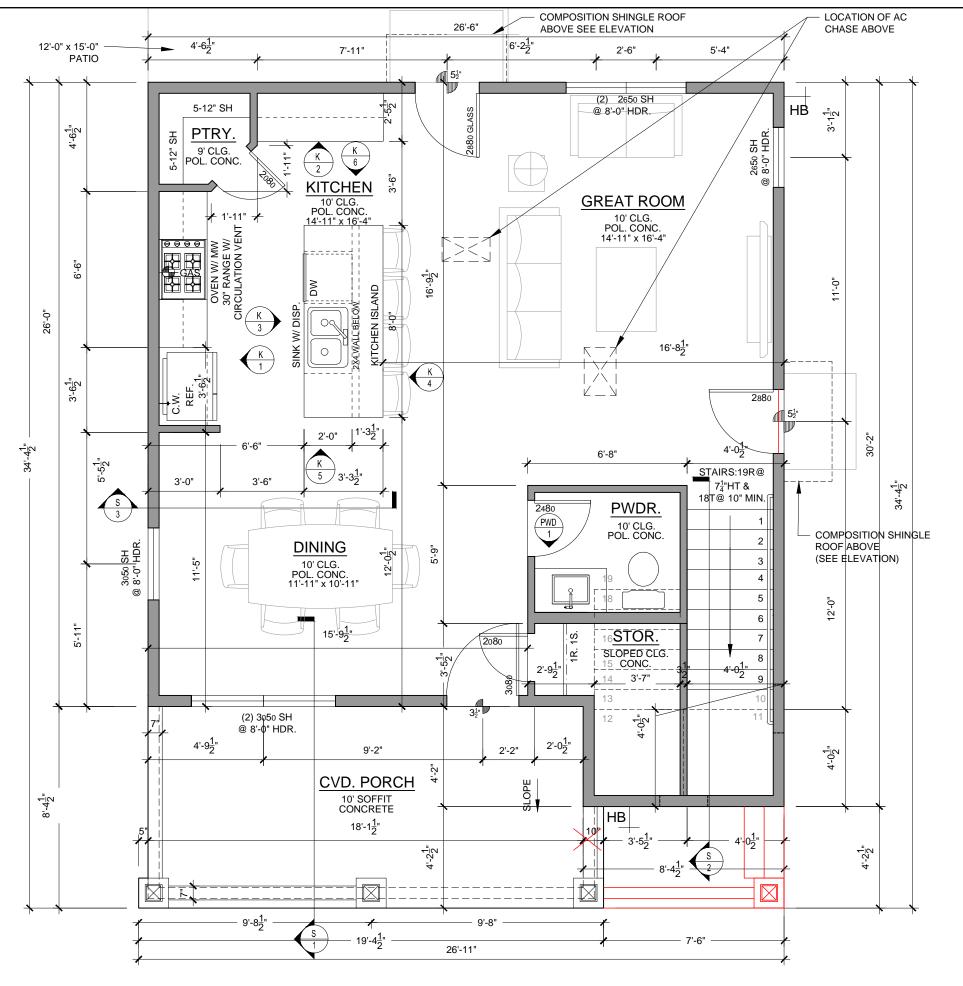



DATE CHANGE BY
03/28/18 20% REVIEW SET CREATED LB
04/16/18 20% REVIEW SET CREATED LB
04/17/19 HDRC REDLINES LB
04/27/18 20% REVIEW SET LB
05/01/18 OHP REDLINES LB




**725 HAYS** 

FLOOR PLAN LEVEL 1 SCALE: <sup>1</sup>/<sub>4</sub>" = 1'-0"

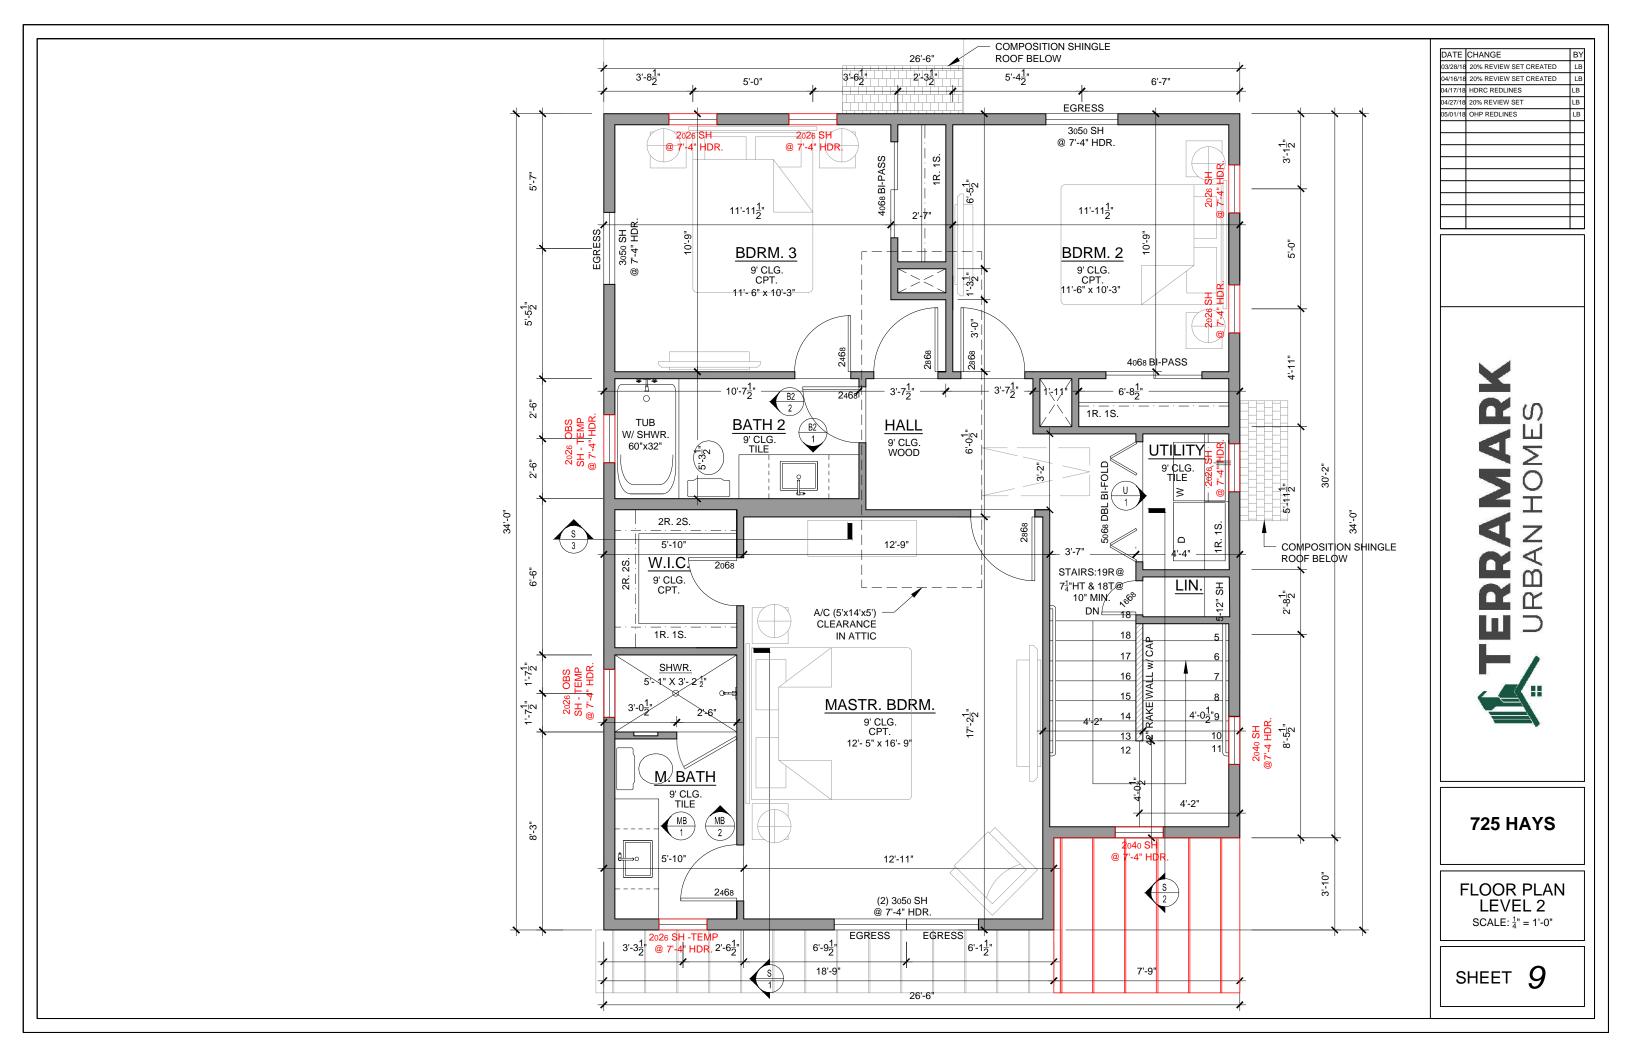

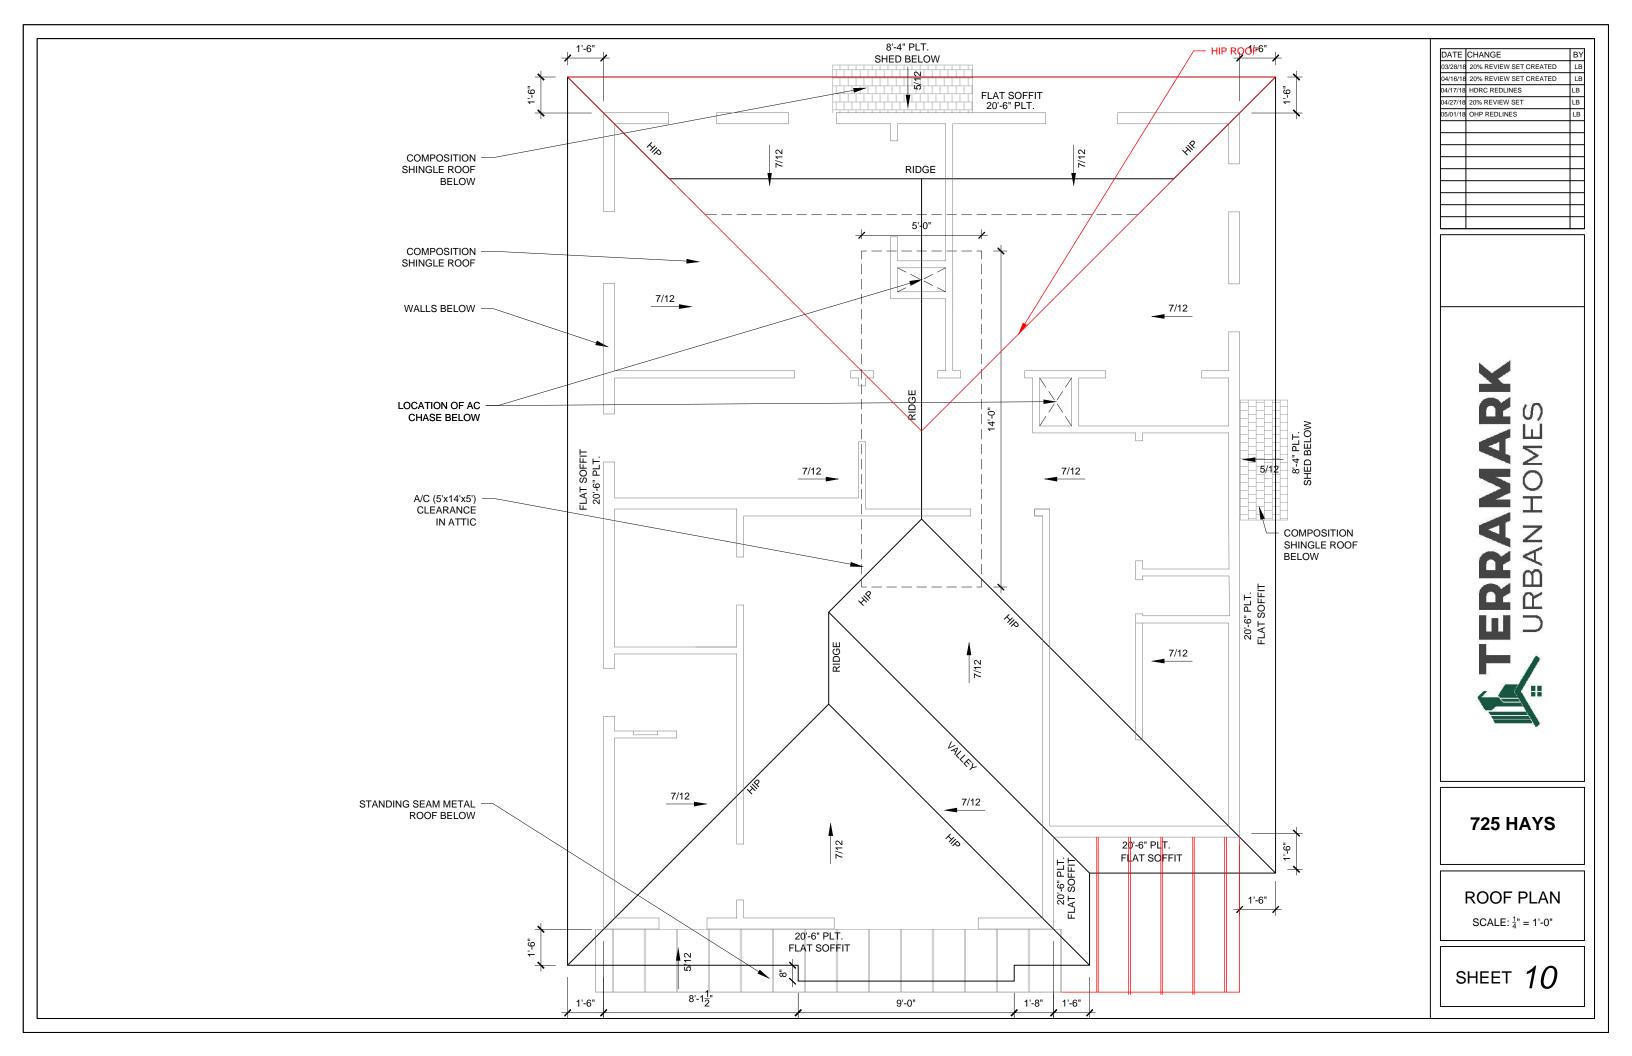


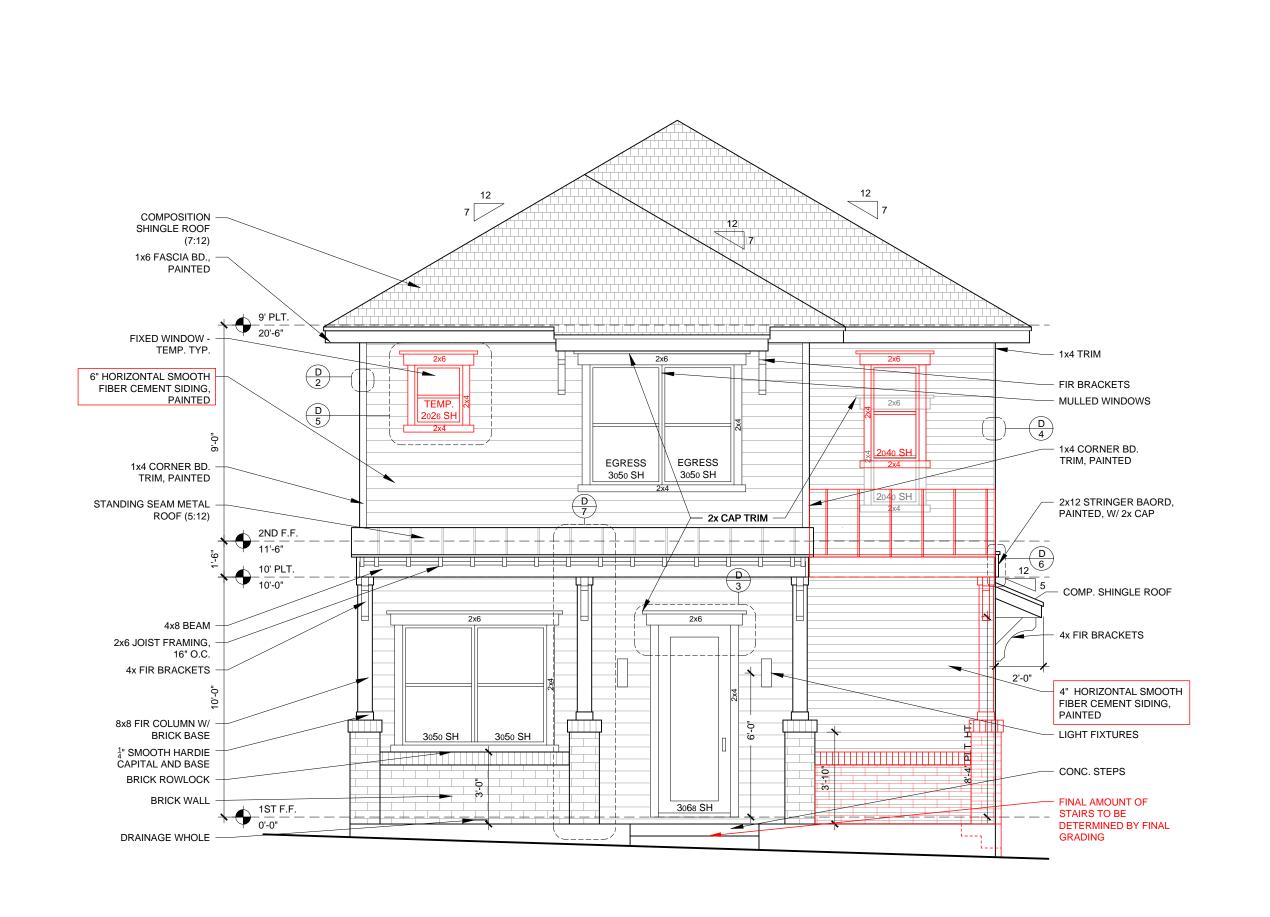



**725 HAYS** 

FRONT ELEVATION SCALE: <sup>1</sup>/<sub>4</sub>" = 1'-0"

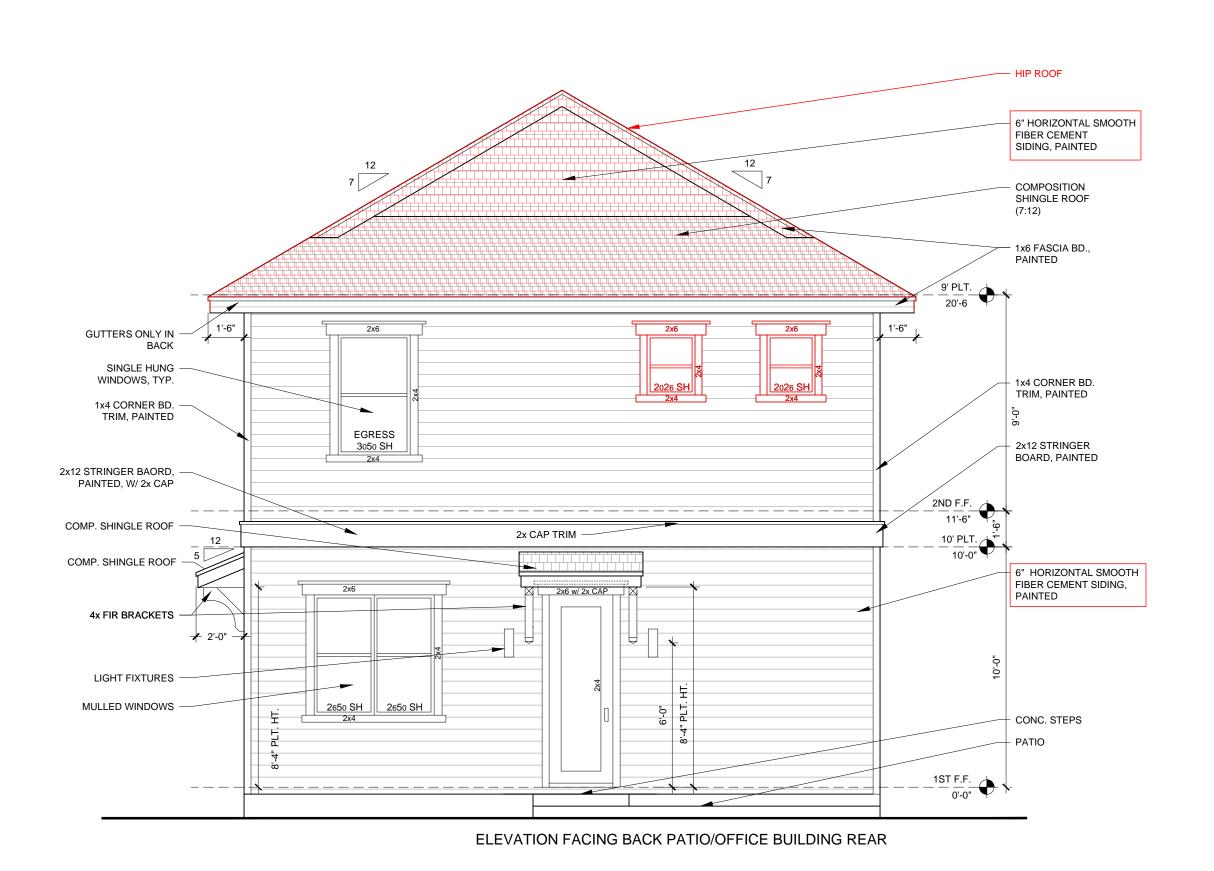


DATE CHANGE BY
03/28/18 20% REVIEW SET CREATED LB
04/16/18 20% REVIEW SET CREATED LB
04/17/18 HDRC REDLINES LB
04/27/18 20% REVIEW SET LB
05/01/18 OHP REDLINES LB



**725 HAYS** 

REAR ELEVATION SCALE: \frac{1}{4}" = 1'-0"

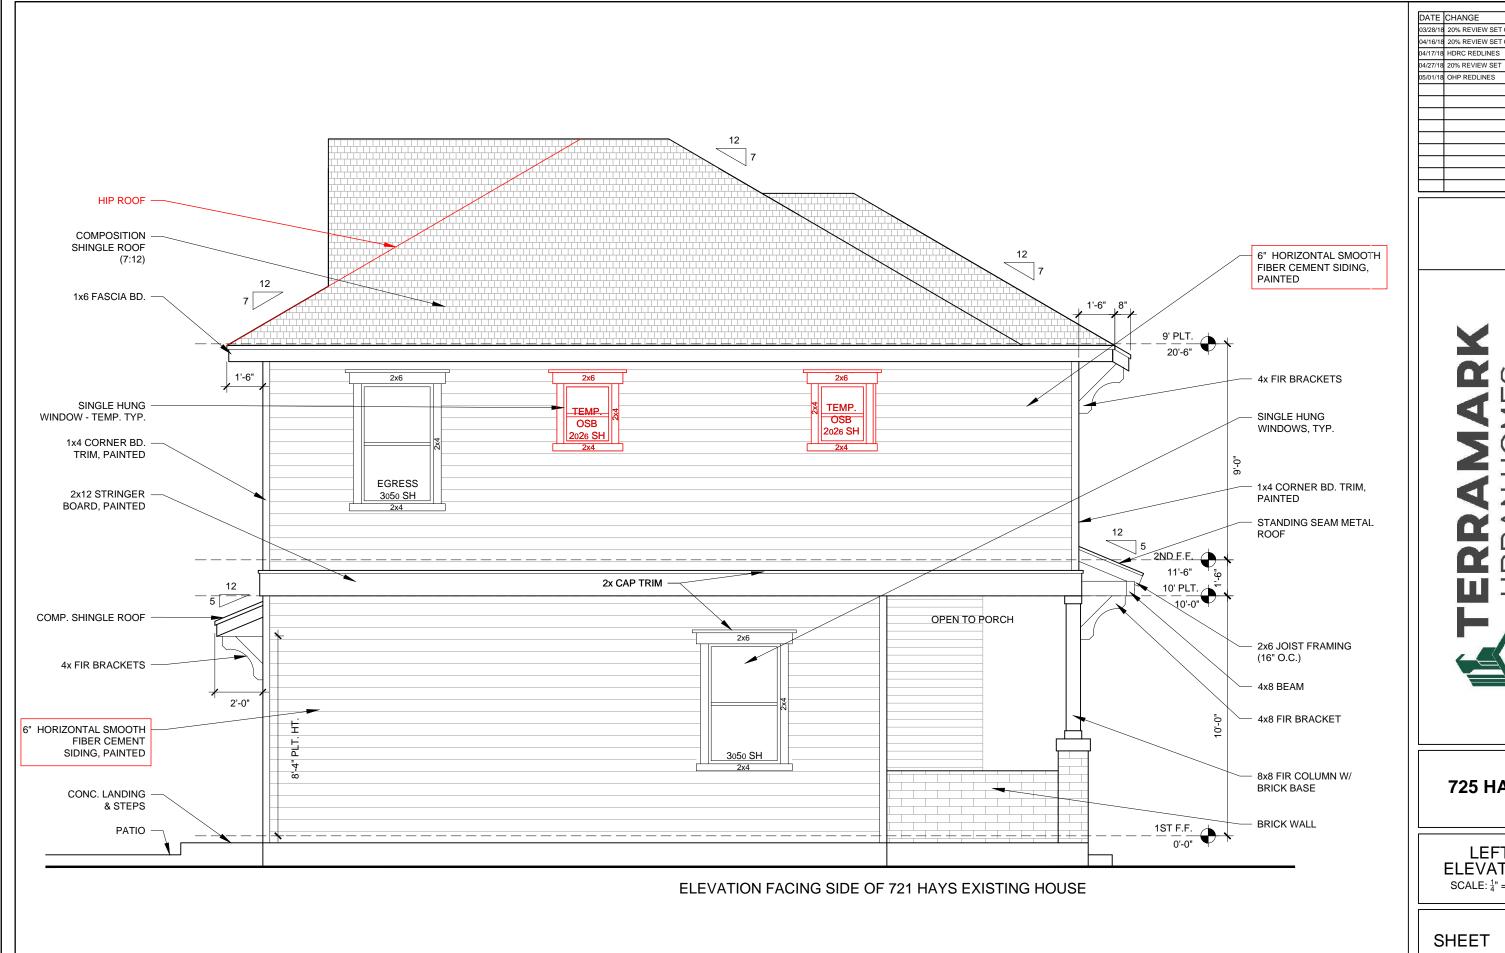


DATE CHANGE BY 03/28/18 20% REVIEW SET CREATED LB 04/16/18 20% REVIEW SET CREATED LB



**725 HAYS** 

LEFT **ELEVATION** SCALE:  $\frac{1}{4}$ " = 1'-0"

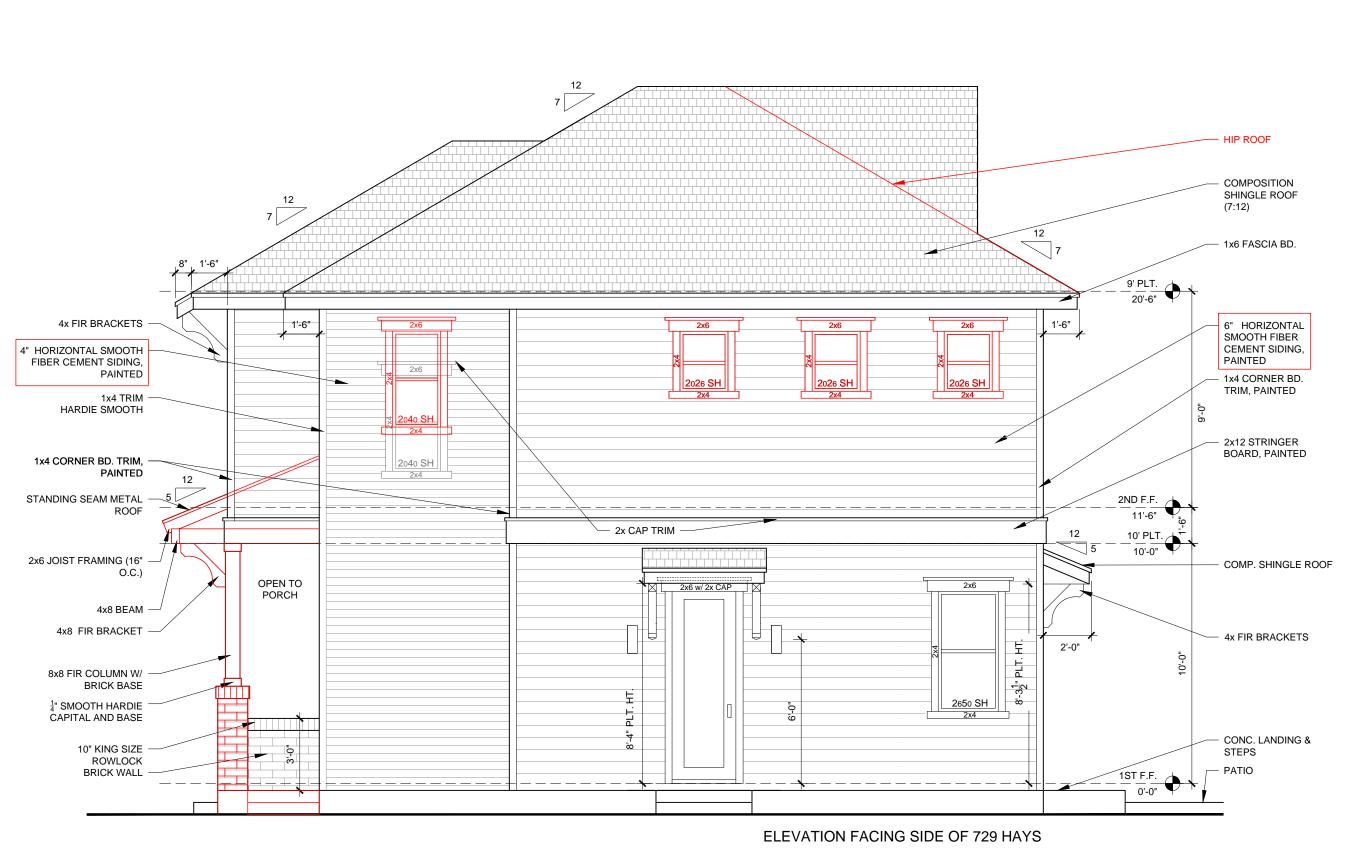



**725 HAYS** 

RIGHT ELEVATION SCALE: \(\frac{1}{4}\)" = 1'-0"

# **729 HAYS STREET**

PLAT No: 170543



SQUARE FOOTAGE CALCULATION		
AREA	SQUARE FEET	
1ST FLOOR LIVING	724	
2ND FLOOR LIVING	800	
TOTAL LIVING	1526	
PORCH	147	
SLAB	871	
TOTAL STRUCTURE	1671	


	TABLE OF CONTENTS
SHEET#	DESCRIPTION
15	COVERSHEET
16	SITE PLAN
17	FLOOR 01
18	FLOOR 02
19	ROOF PLAN
20	FRONT ELEV.
21	REAR ELEV.
22	LEFT ELEV.
23	RIGHT ELEV.

DATE	CHANGE	BY
04/06/18	HDRC FINAL SUBMITTAL	LB
05/01/18	OHP REDLINES	LB
		_
		_
		_
		_
		_
		_
		_



**729 HAYS** 

COVERPAGE

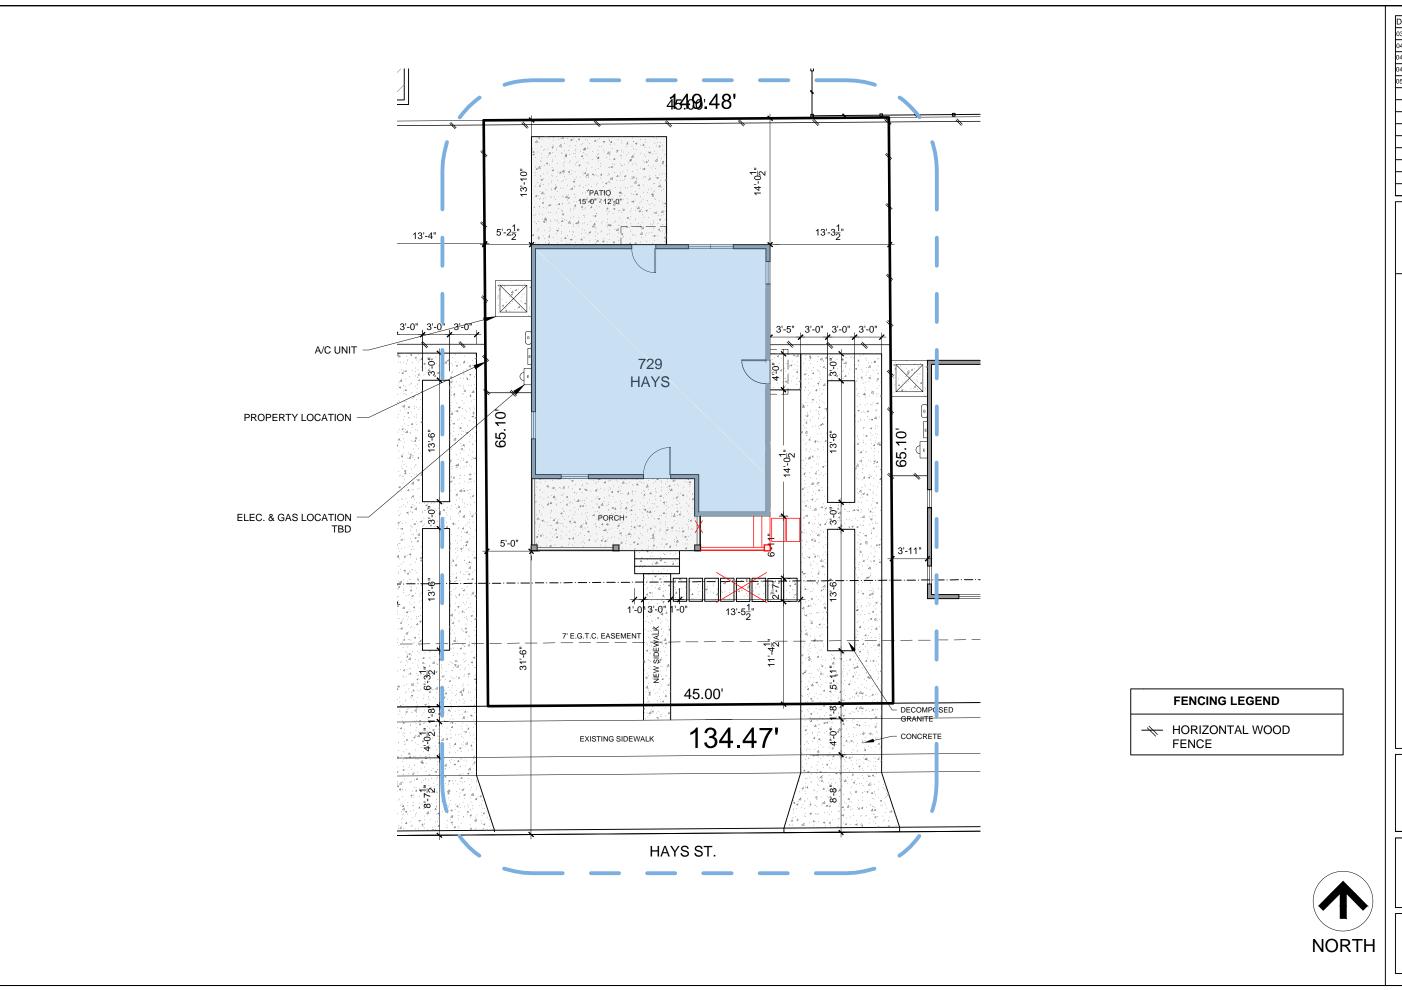



**729 HAYS** 

SITE PLAN


SCALE:  $\frac{3}{32}$ " = 1'-0"



Size	Туре	Level	Int/Ext	Location
2080	Single	1	Interior	Ptry.
2080	Single	1	Interior	Storage
2480	Single	1	Interior	Pwdr.
2880	Single	1	Exterior	Entry/ Right
2880	Single	1	Exterior	Entry/ Rear
3080	Single	1	Exterior	Entry/ Front
1668	Single	2	Interior	Linen
2068	Single	2	Interior	WIC
2468	Single	2	Interior	Mastr. Bath
2468	Single	2	Interior	Bath2 / Hall
2468	Single	2	Interior	Bath2/ Bdrm. 3
2868	Single	2	Interior	Mastr. Bdrm.
2868	Single	2	Interior	Bdrm.3
2868	Single	2	Interior	Bdrm.2
4068	Dbl Door	2	Interior	Bdrm.2/Clos.
4068	Dbl Door	2	Interior	Bdrm.2/Clos.
5068	Dbl Bi-Fold	2	Interior	Utility

### WINDOW SCHEDULE

Size	Туре	Level	Height	Location
2650	SH	1	8' Hdr. Ht.	Living Room
2650	SH	1	8' Hdr. Ht.	Living Room
2650	SH	1	8' Hdr. Ht.	Living Room
3050	SH	1	8' Hdr. Ht.	Dining
3050	SH	1	8' Hdr. Ht.	Dining
2026	FX	2	7'- 4" Hdr. Ht.	Bdrm.2
2026	FX	2	7'- 4" Hdr. Ht.	Bdrm.2
2026	FX	2	7'- 4" Hdr. Ht.	Bdrm.3
2026	FX	2	7'- 4" Hdr. Ht.	Bdrm.3
2026	FX - Temp - OBS	2	7'- 4" Hdr. Ht.	Bath 2
2026	FX - Temp - OBS	2	7'- 4" Hdr. Ht.	M. Bath
2040	SH	2	18'- 10"Hdr. Ht.	Stairs
2040	SH	2	18'- 10"Hdr. Ht.	Stairs
2860	SH - Egress	2	8' Hdr. Ht.	Master Bdrm.
2860	SH - Egress	2	8' Hdr. Ht.	Master Bdrm.
3050	SH - Egress	2	7'- 4" Hdr. Ht.	Bdrm.2
3050	SH - Egress	2	7'- 4" Hdr. Ht.	Bdrm.3

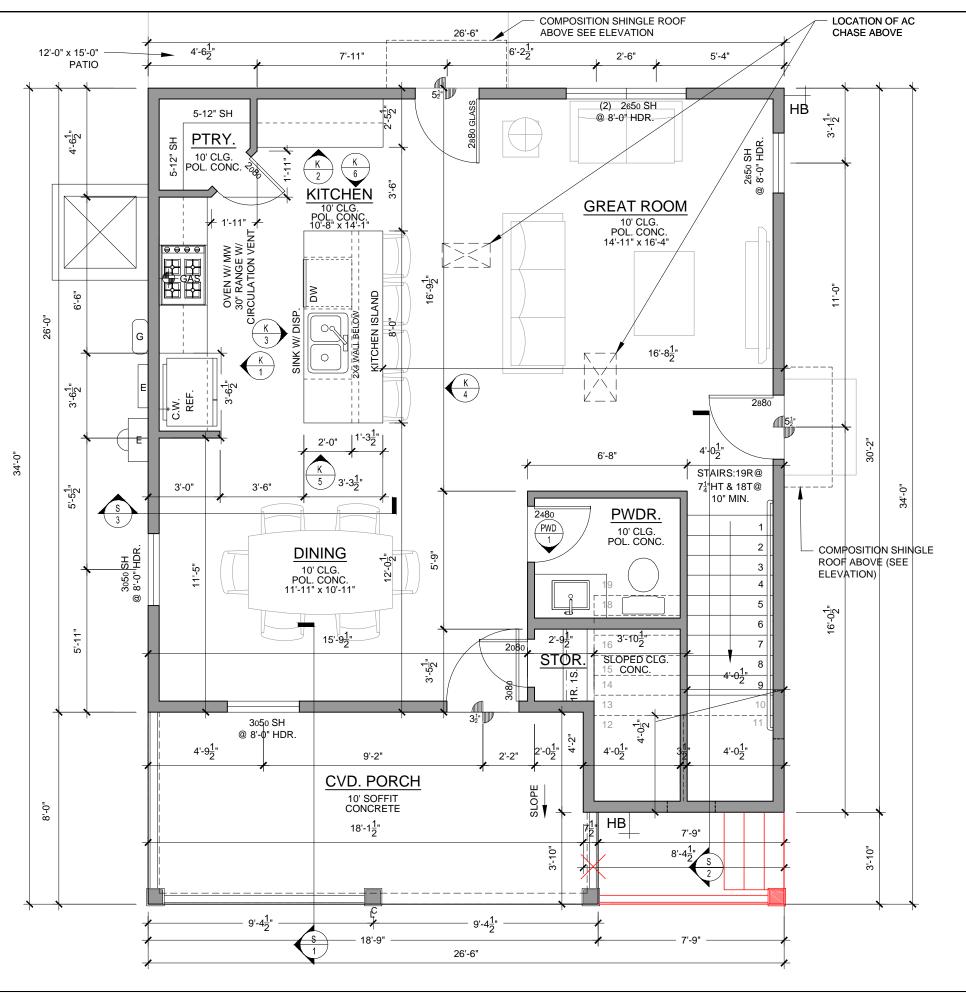



DATE CHANGE BY
03/28/18 20% REVIEW SET CREATED LB
04/13/18 20% REVIEW SET PRINTED LB
04/17/18 HDRC REDLINES LB
04/27/18 20% REVIEW SET LB
05/01/18 OHP REDLINES LB




**729 HAYS** 

FLOOR PLAN LEVEL 1 SCALE: \(\frac{1}{4}\)" = 1'-0"

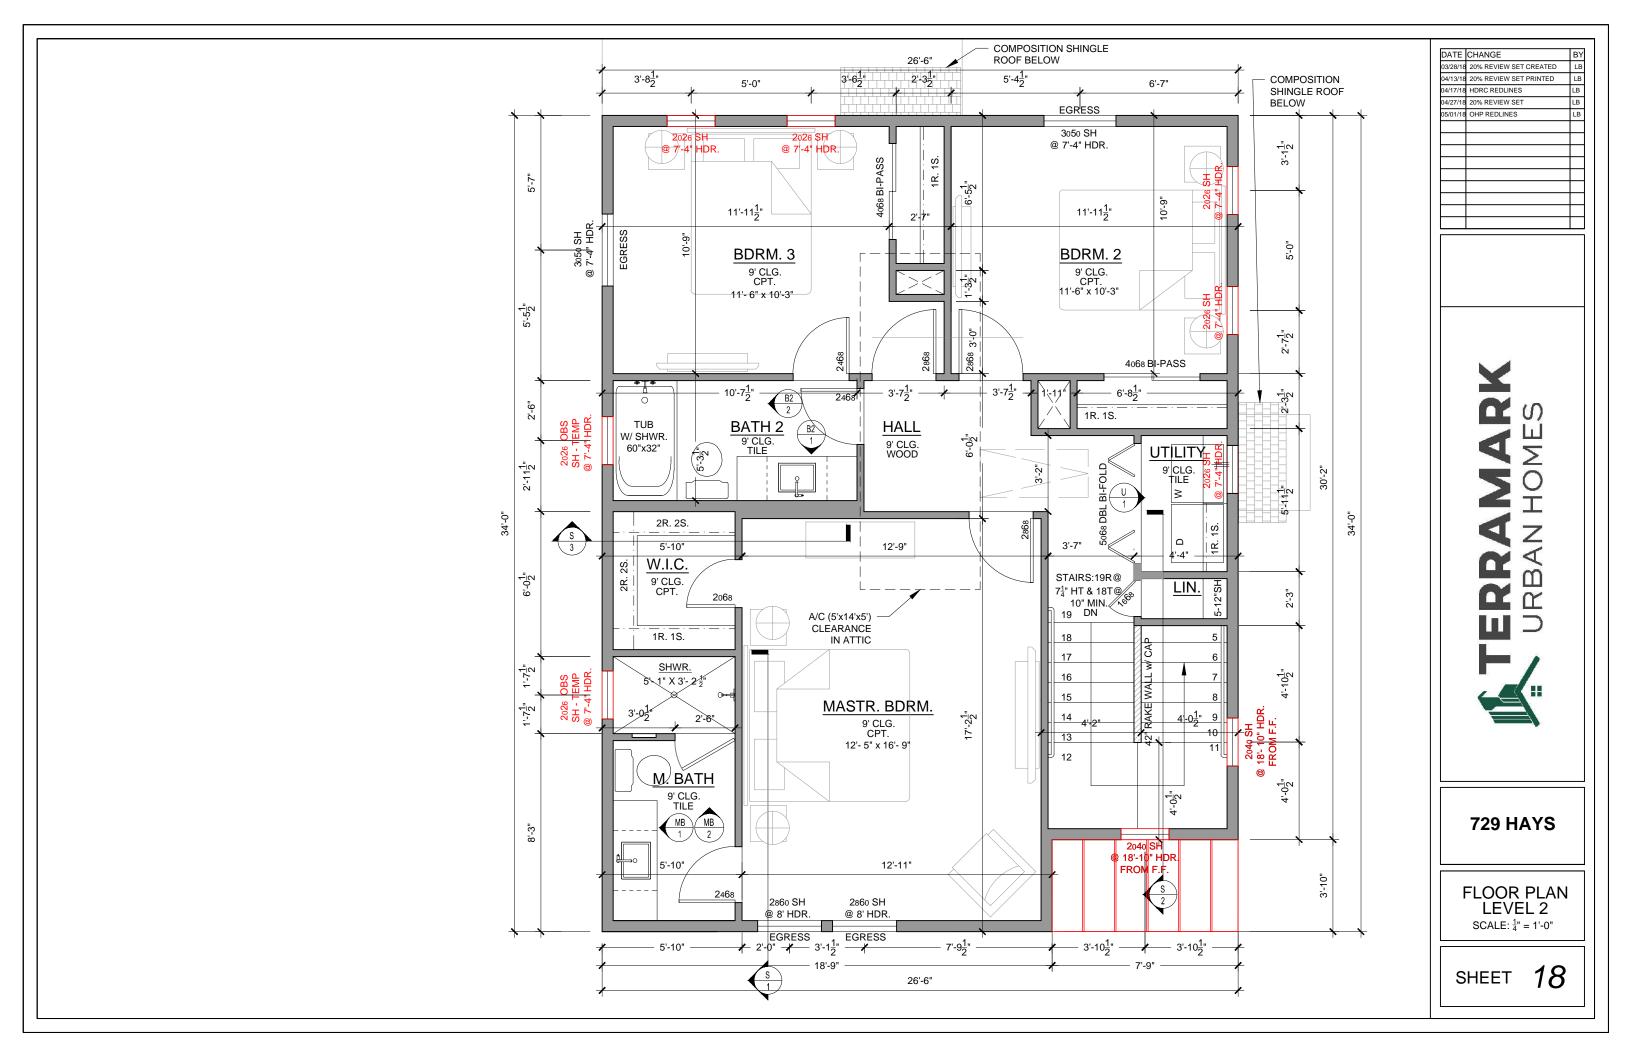

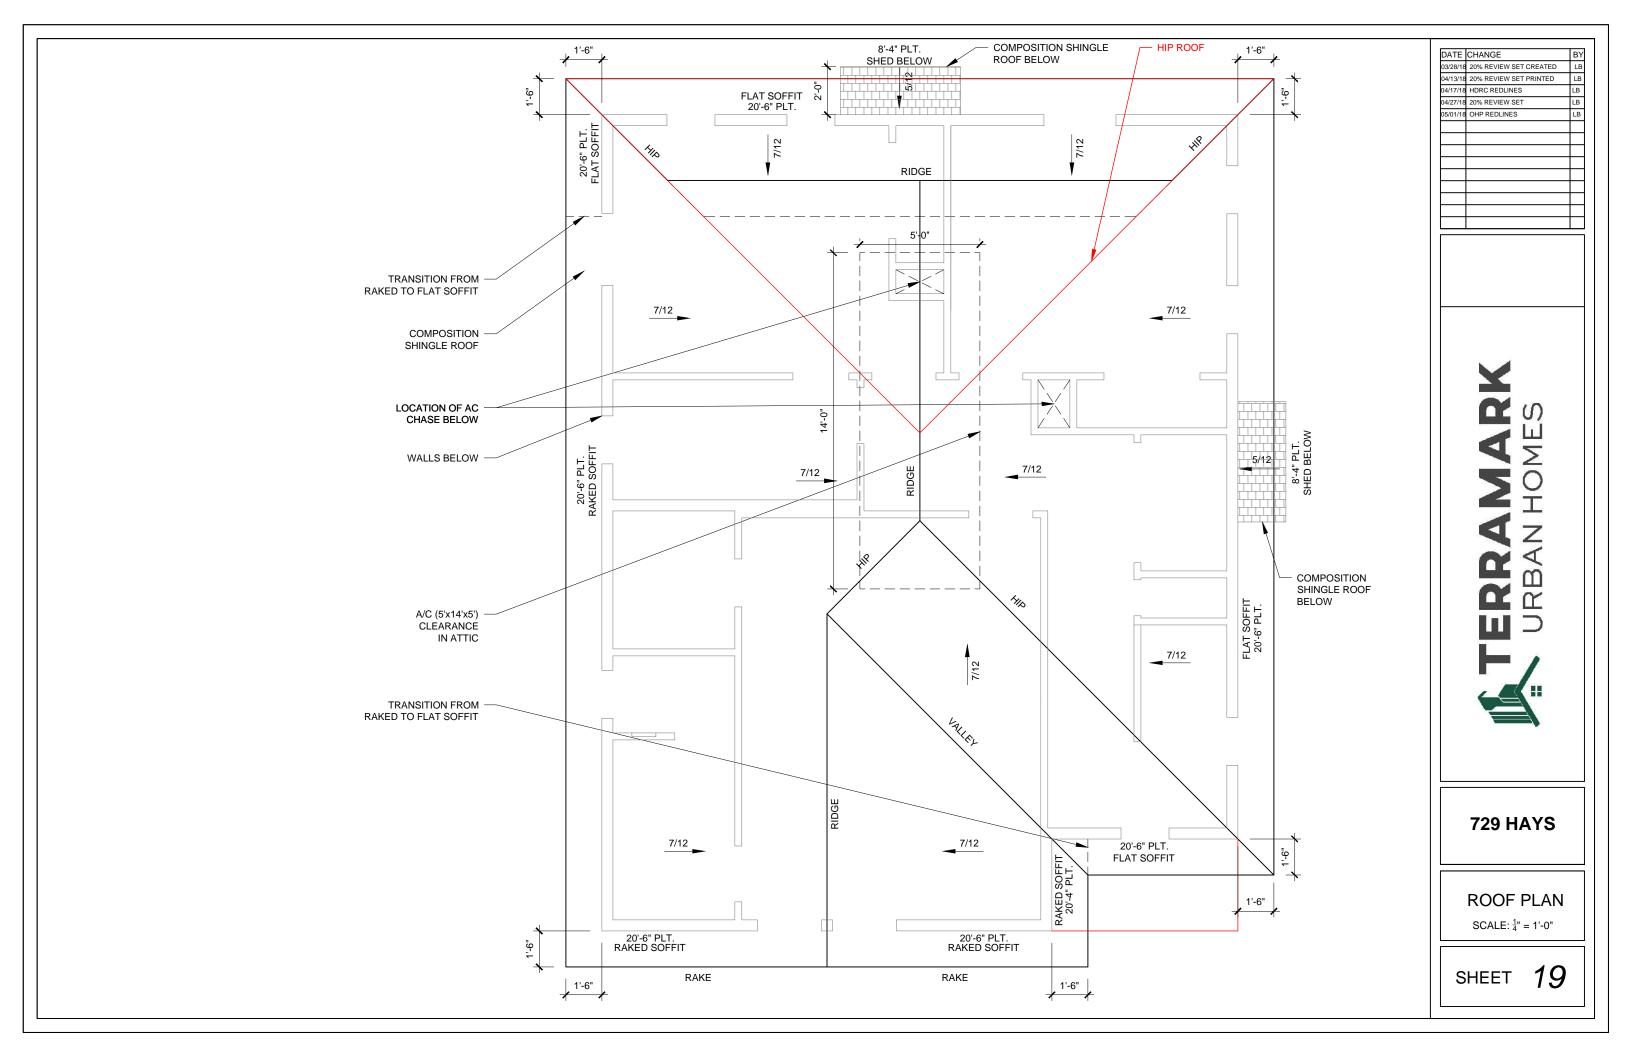

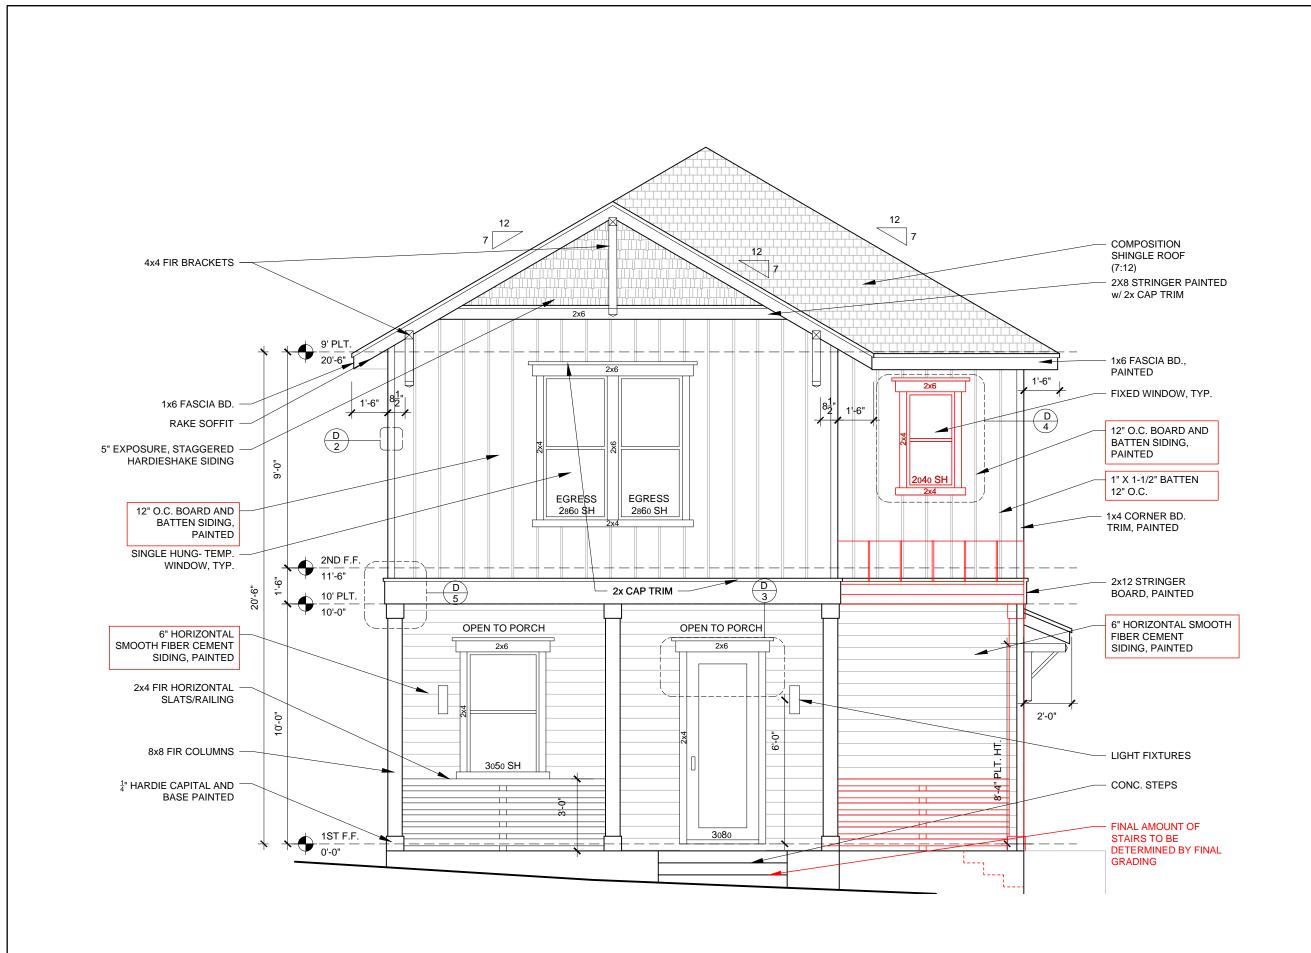


DATE	CHANGE	BY
03/28/18	20% REVIEW SET CREATED	LB
04/13/18	20% REVIEW SET PRINTED	LB
04/17/18	HDRC REDLINES	LB
04/27/18	20% REVIEW SET	LB
05/01/18	OHP REDLINES	LB



**729 HAYS** 

FRONT ELEVATION SCALE: <sup>1</sup>/<sub>4</sub>" = 1'-0"

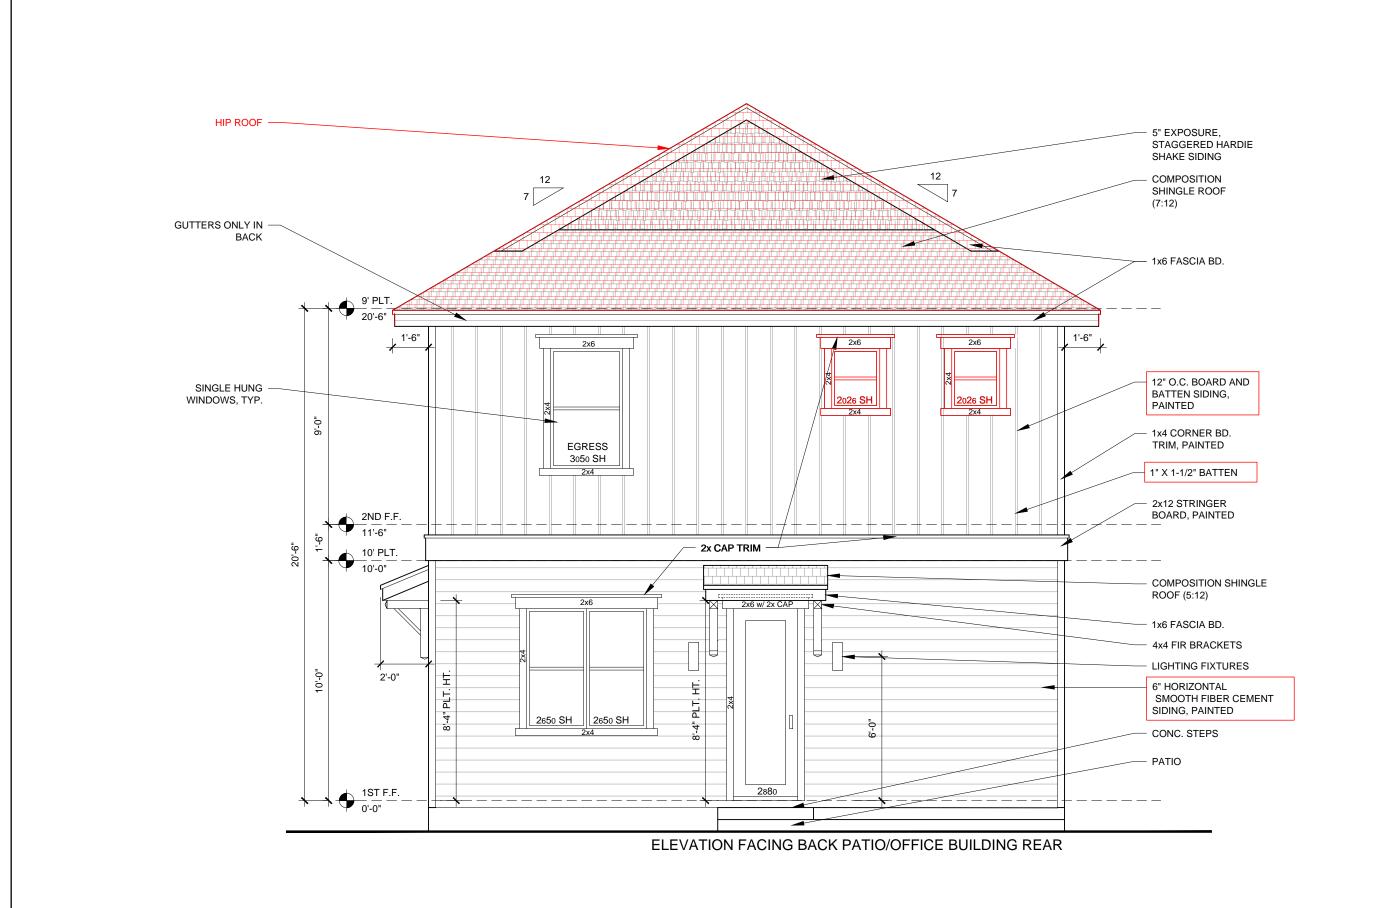


DATE	CHANGE	BY
03/28/18	20% REVIEW SET CREATED	LB
04/13/18	20% REVIEW SET PRINTED	LB
04/17/18	HDRC REDLINES	LB
04/27/18	20% REVIEW SET	LB
05/01/18	OHP REDLINES	LB



**729 HAYS** 


REAR ELEVATION SCALE: \( \frac{1}{4} \)" = 1'-0"

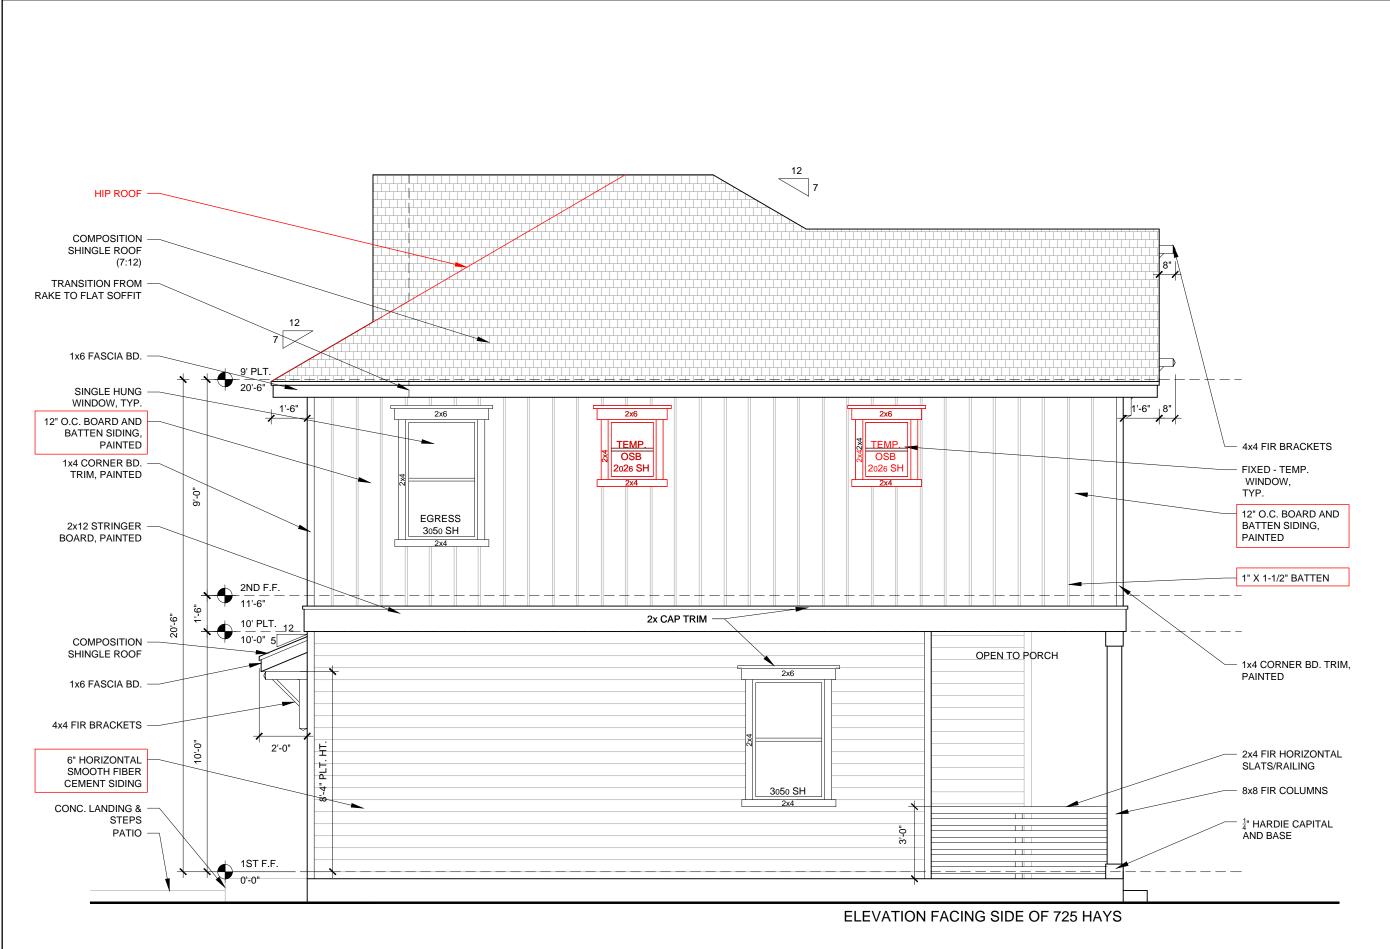



**729 HAYS** 

LEFT ELEVATION SCALE: <sup>1</sup>/<sub>4</sub>" = 1'-0"

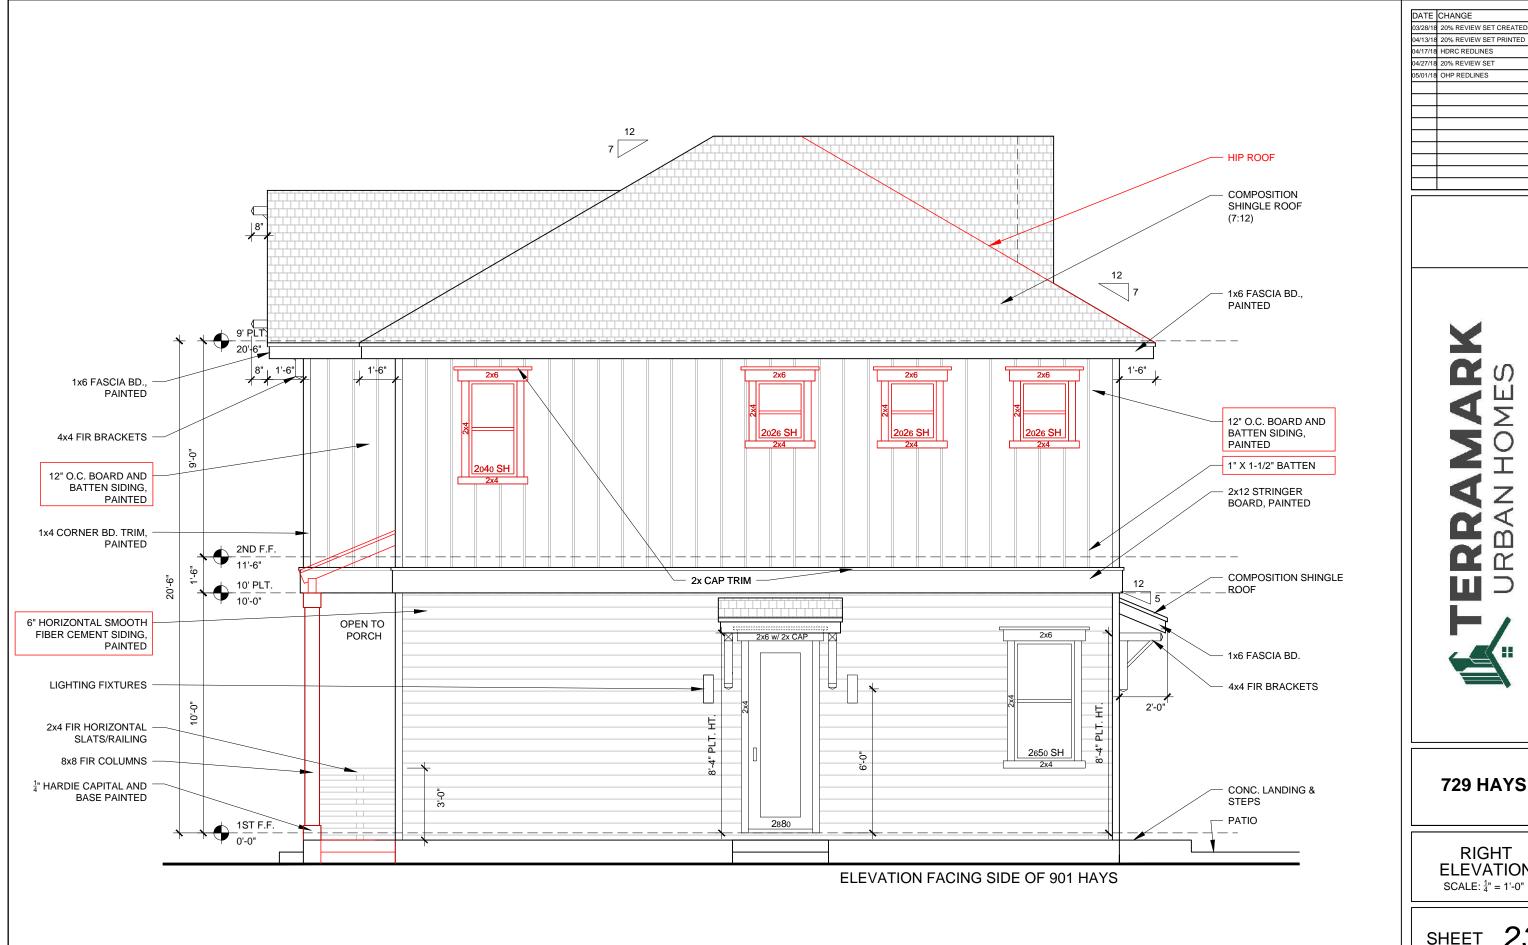

DATE CHANGE BY 03/28/18 20% REVIEW SET CREATED LB 04/13/18 20% REVIEW SET PRINTED



**729 HAYS** 

RIGHT **ELEVATION** 

## 901 HAYS STREET

PLAT No: 170543



SQUARE FOOTAGE CALCULATION			
AREA	SQUARE FEET		
1ST FLOOR LIVING 2ND FLOOR LIVING	724 802		
TOTAL LIVING	1526		
PORCH	155		
SLAB	879		
TOTAL STRUCTURE	1681		


	TABLE OF CONTENTS
SHEET#	DESCRIPTION
15	COVERSHEET
16	SITE PLAN
17	FLOOR 01
18	FLOOR 02
19	ROOF PLAN
20	FRONT ELEV.
21	REAR ELEV.
22	LEFT ELEV.
23	RIGHT ELEV.

	CHANGE	BY	
04/06/18	HDRC FINAL SUBMITTAL	LB	
05/01/18	OHP REDLINES	LB	
		$\equiv$	



**729 HAYS** 

COVERPAGE

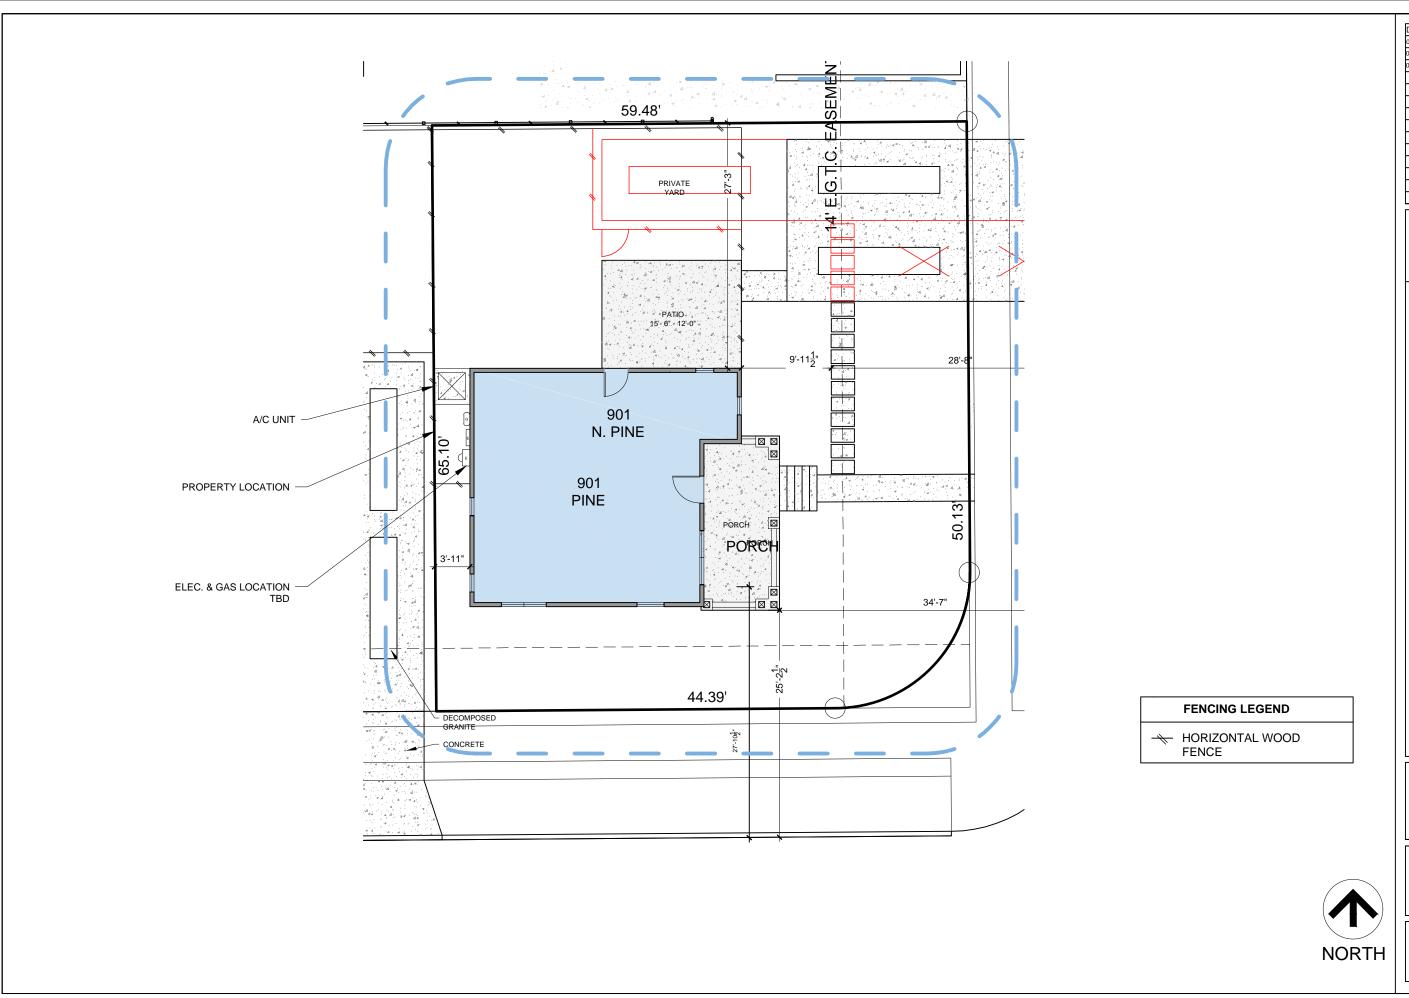




**901 PINE** 

SITE PLAN

SCALE:  $\frac{3}{32}$ " = 1'-0"

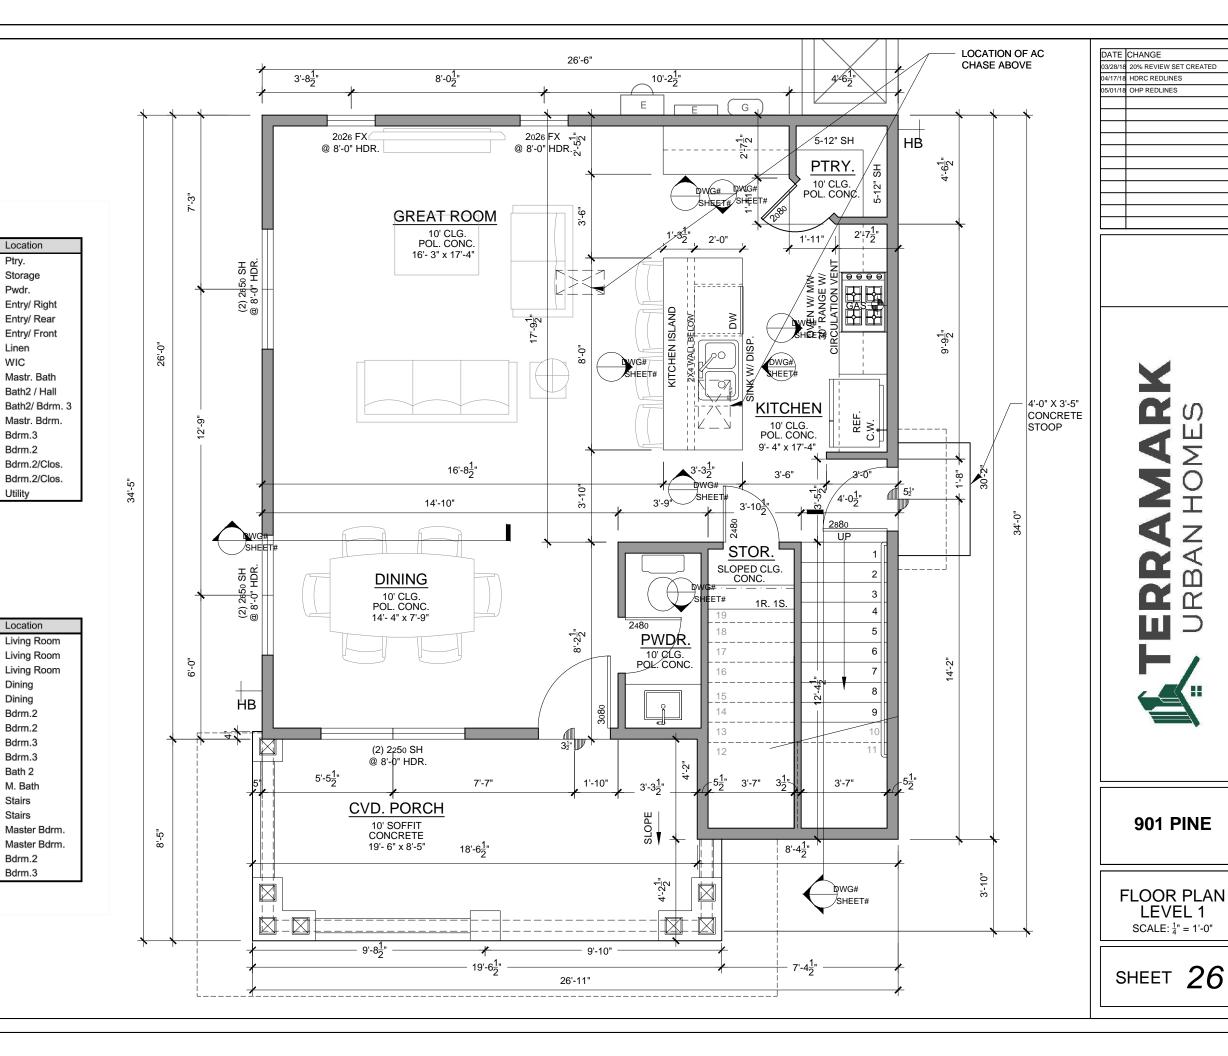

DOOR SCHEDULE

2

2

2

2

2

2

2

2

2

2

WINDOW SCHEDULE

2

2

2

2

2

2

2

2

2

Level Height

8' Hdr. Ht.

7'- 4" Hdr. Ht.

18'- 10"Hdr. Ht.

18'- 10"Hdr. Ht.

8' Hdr. Ht.

8' Hdr. Ht.

7'- 4" Hdr. Ht.

7'- 4" Hdr. Ht.

Level Int/Ext

Interior

Interior

Interior

Exterior

Exterior

Exterior

Interior

Location

Storage

Ptry.

Pwdr.

Linen

WIC

Bdrm.3

Bdrm.2

Utility

Location

Dining

Dining

Bdrm.2

Bdrm.2

Bdrm.3

Bdrm.3

Bath 2

M. Bath

Stairs

Stairs

Bdrm.2

Bdrm.3

Size

2080

2080

2480

2880

2880

3080

1668

2068

2468

2468

2468

2868

2868

2868

4068

4068

5068

Size

2650

2650

2650

3050

3050

2026

2026

2026

2026

2026

2026

2040

2040

2860

2860

3050

3050

Type

Single

Dbl Door

Dbl Door

Type

SH

SH

SH

SH

FX

FX

FΧ

FX

SH

SH

FX - Temp - OBS

FX - Temp - OBS

SH - Egress

SH - Egress

SH - Egress

SH - Egress

Dbl Bi-Fold

LB


Σ

<del>O</del>H


Z


m

~

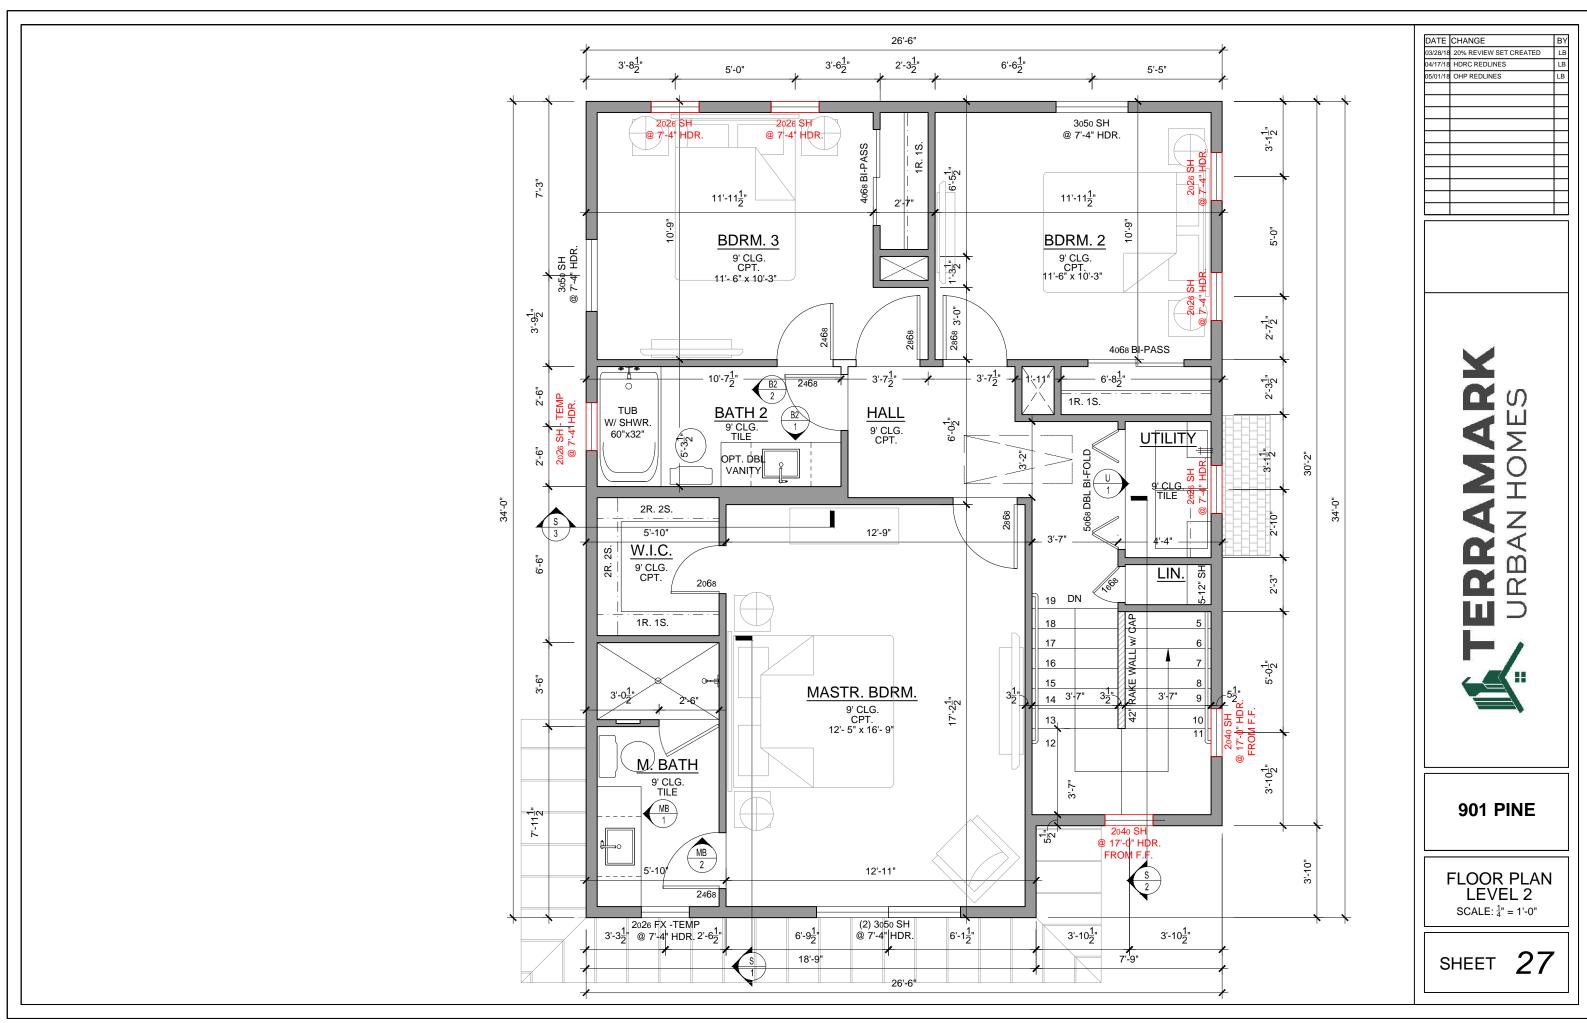

DATE	CHANGE	BY
03/28/18	20% REVIEW SET CREATED	LB
04/17/18	HDRC REDLINES	LB
05/01/18	OHP REDLINES	LB
		$\neg \neg$

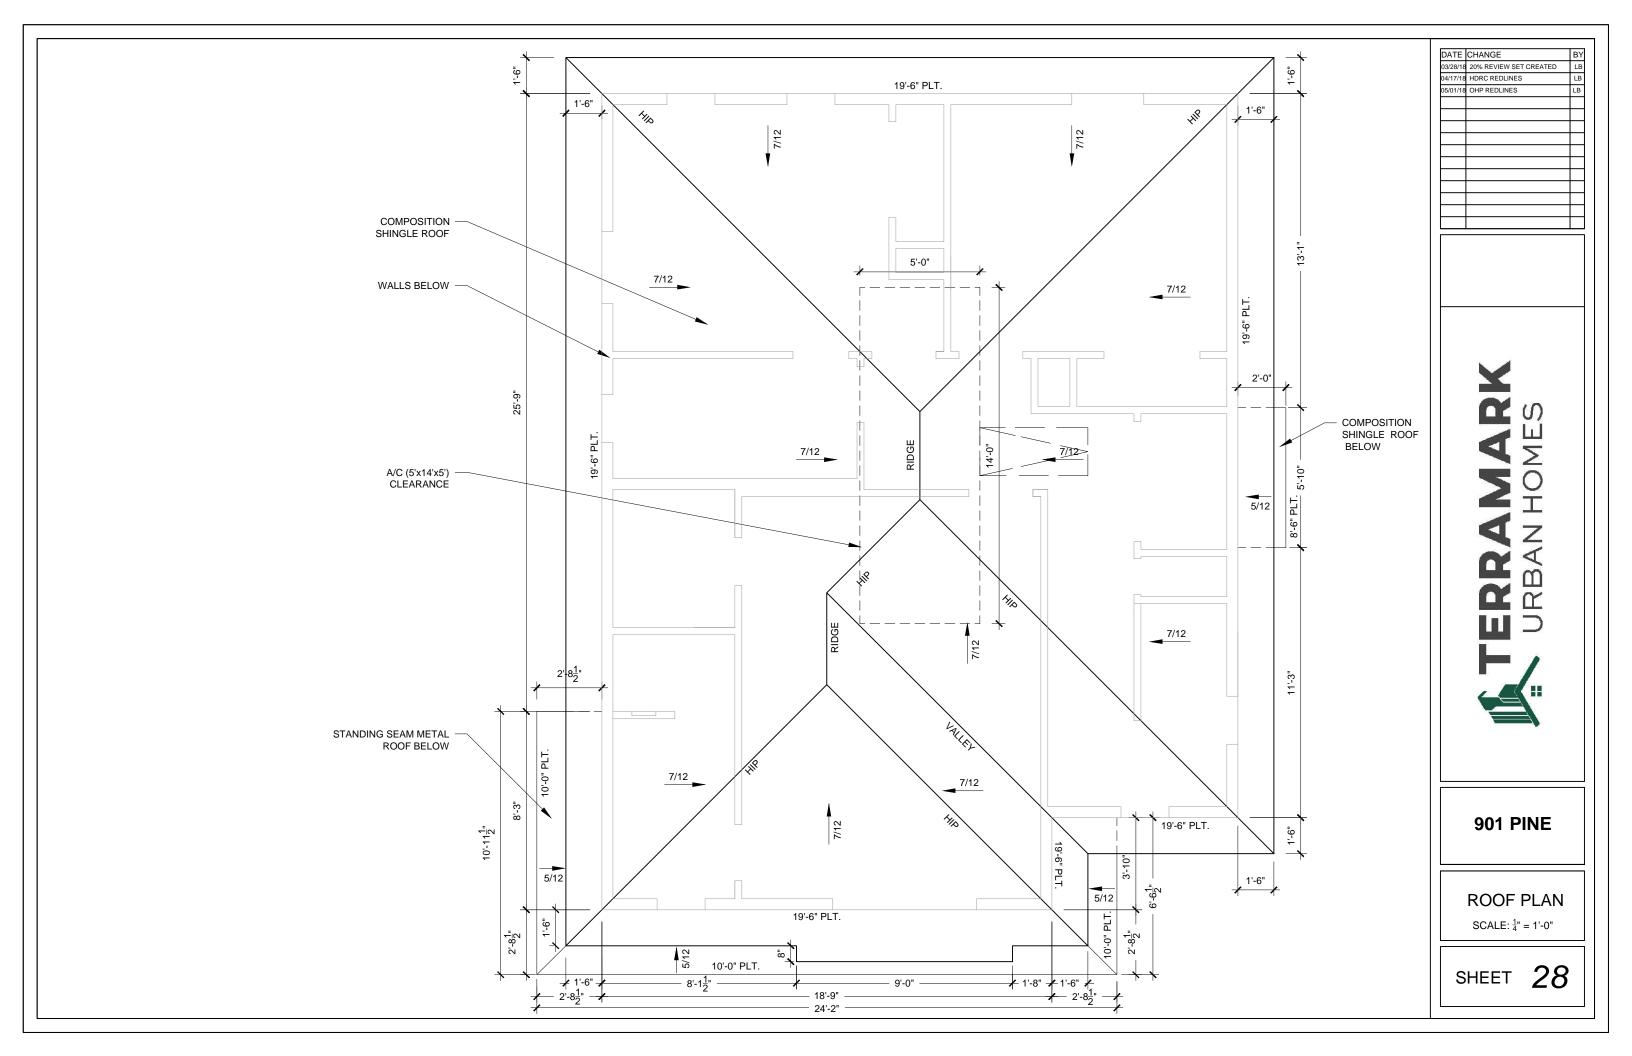

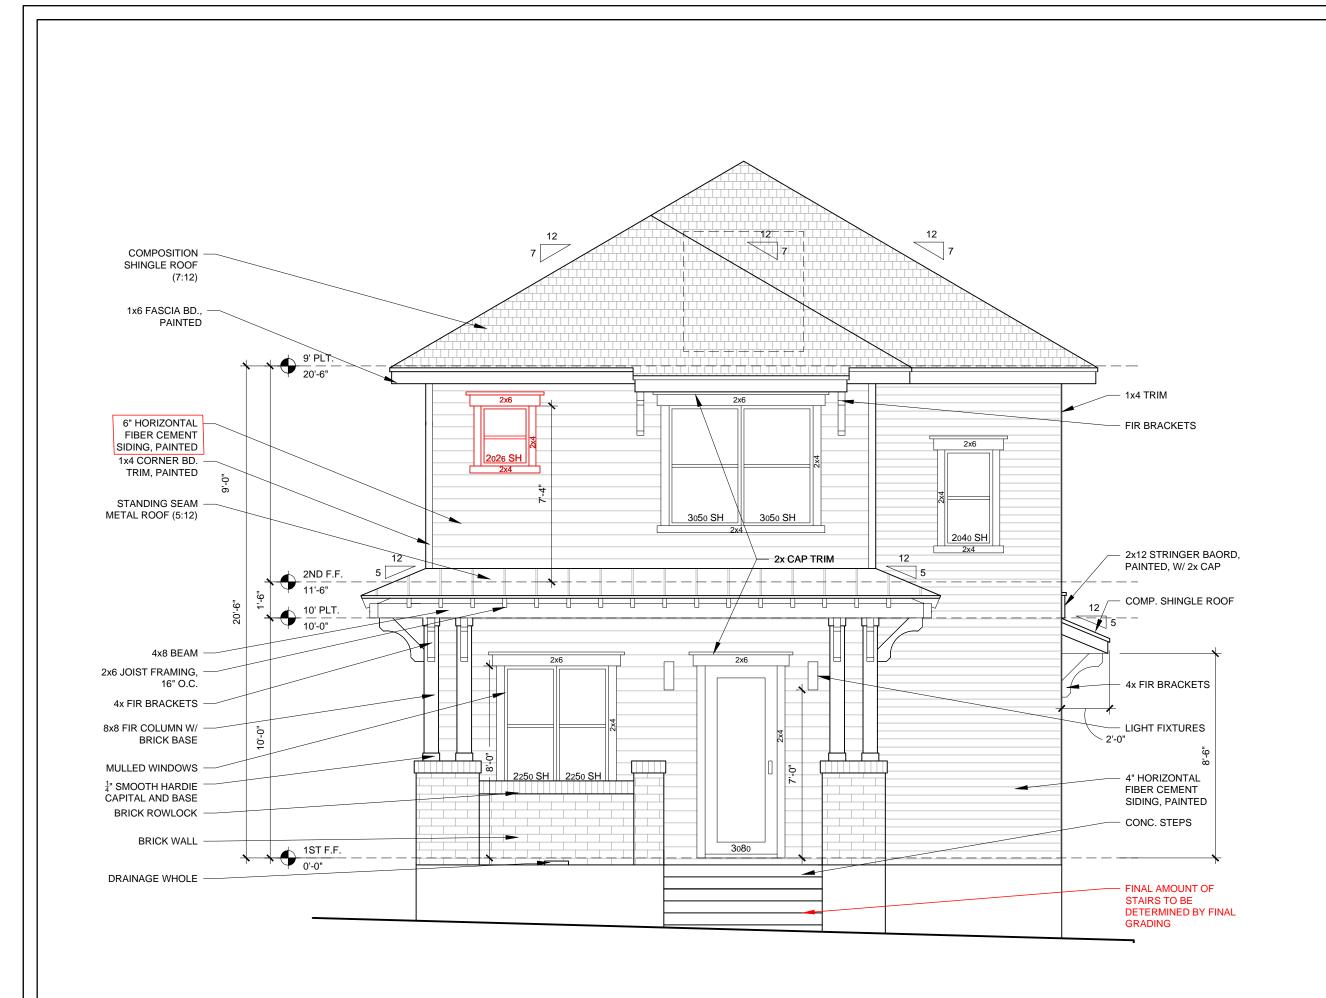


DATE	CHANGE	BY
03/28/18	20% REVIEW SET CREATED	LB
04/17/18	HDRC REDLINES	LB
05/01/18	OHP REDLINES	LB
	·	



**901 PINE** 

FRONT ELEVATION SCALE: <sup>1</sup>/<sub>4</sub>" = 1'-0"

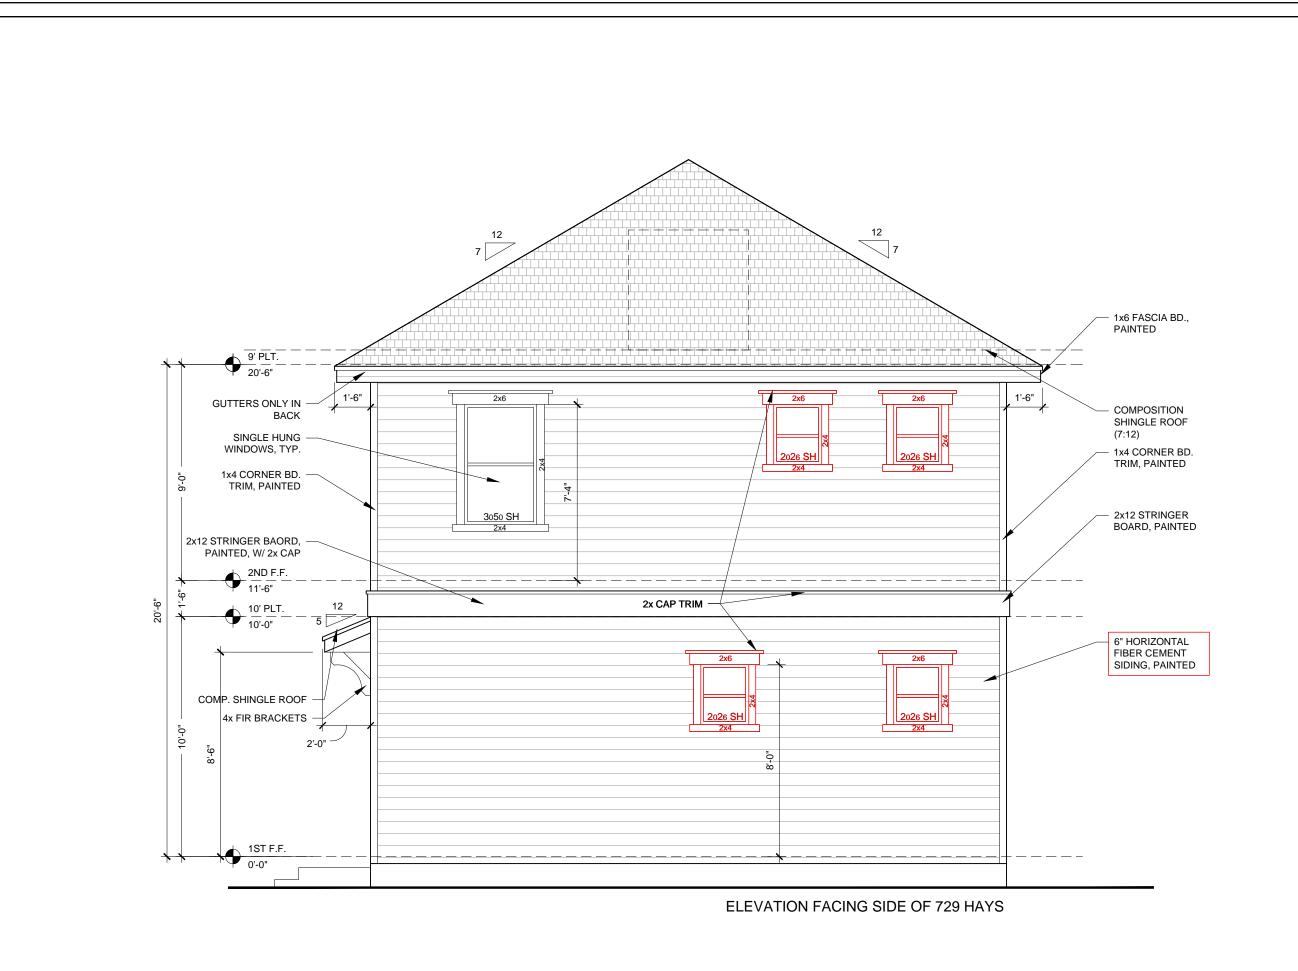

DATE CHANGE

03/28/18 20% REVIEW SET CREATED LB


04/17/18 HDRC REDLINES LB


05/01/18 OHP REDLINES LB



**901 PINE** 

REAR ELEVATION SCALE: \( \frac{1}{4} \)" = 1'-0"

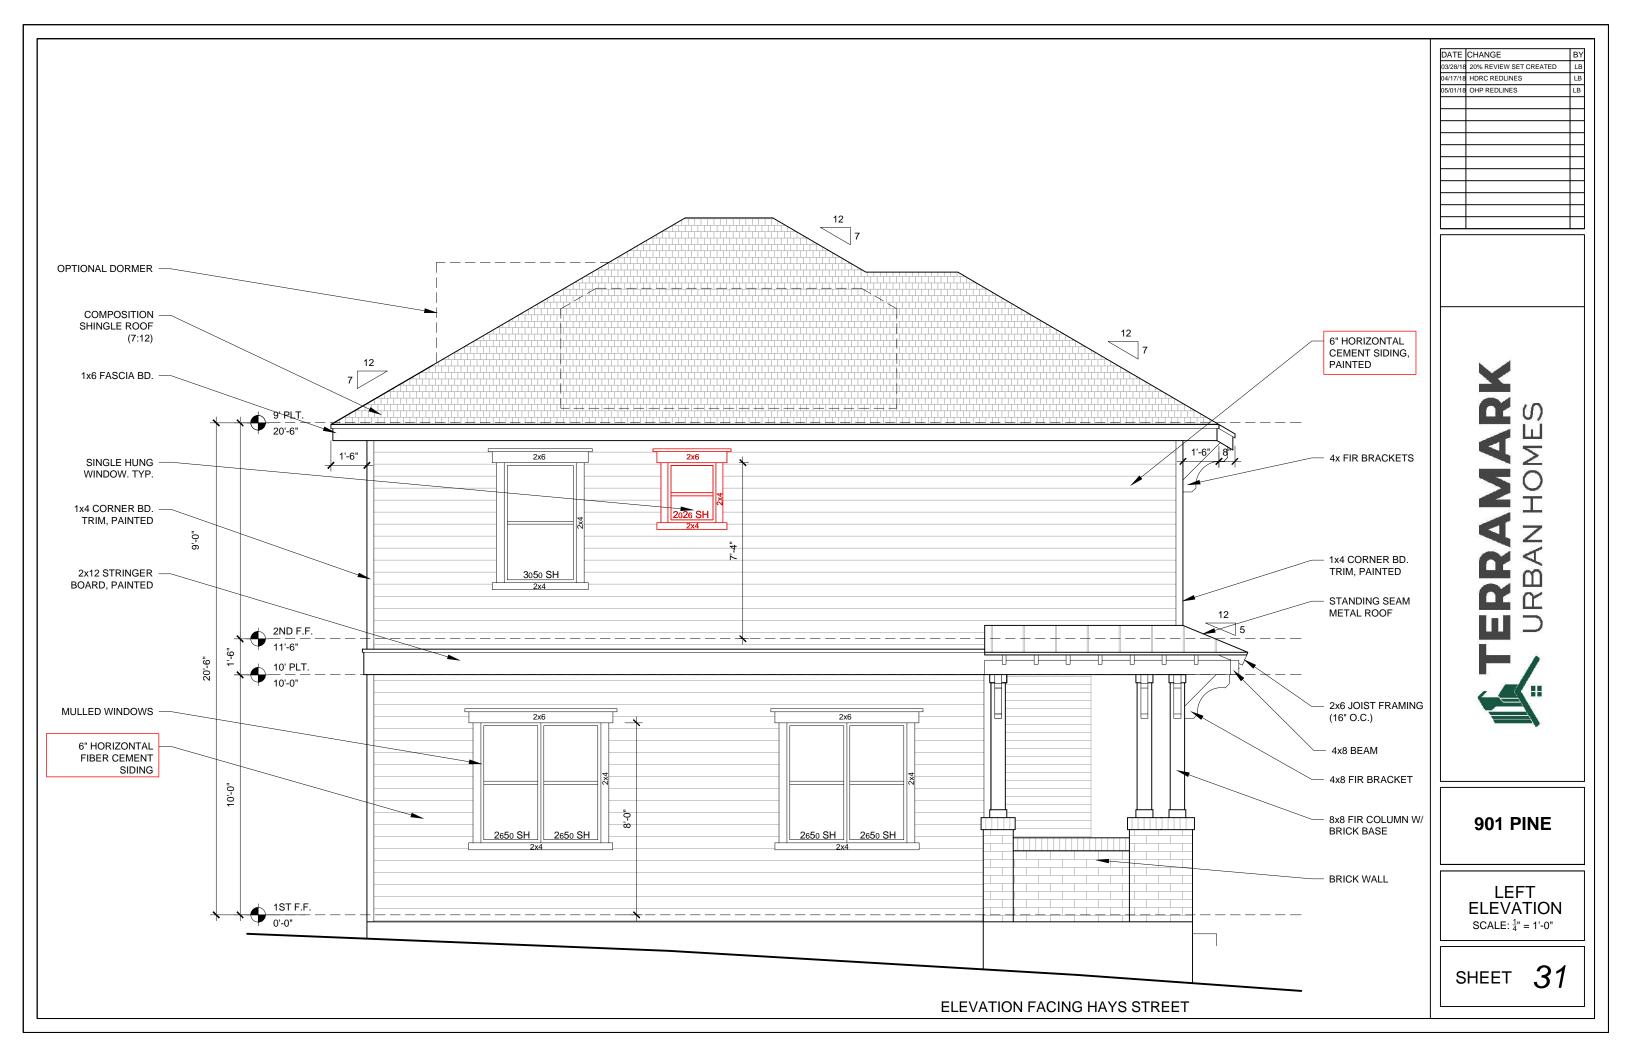

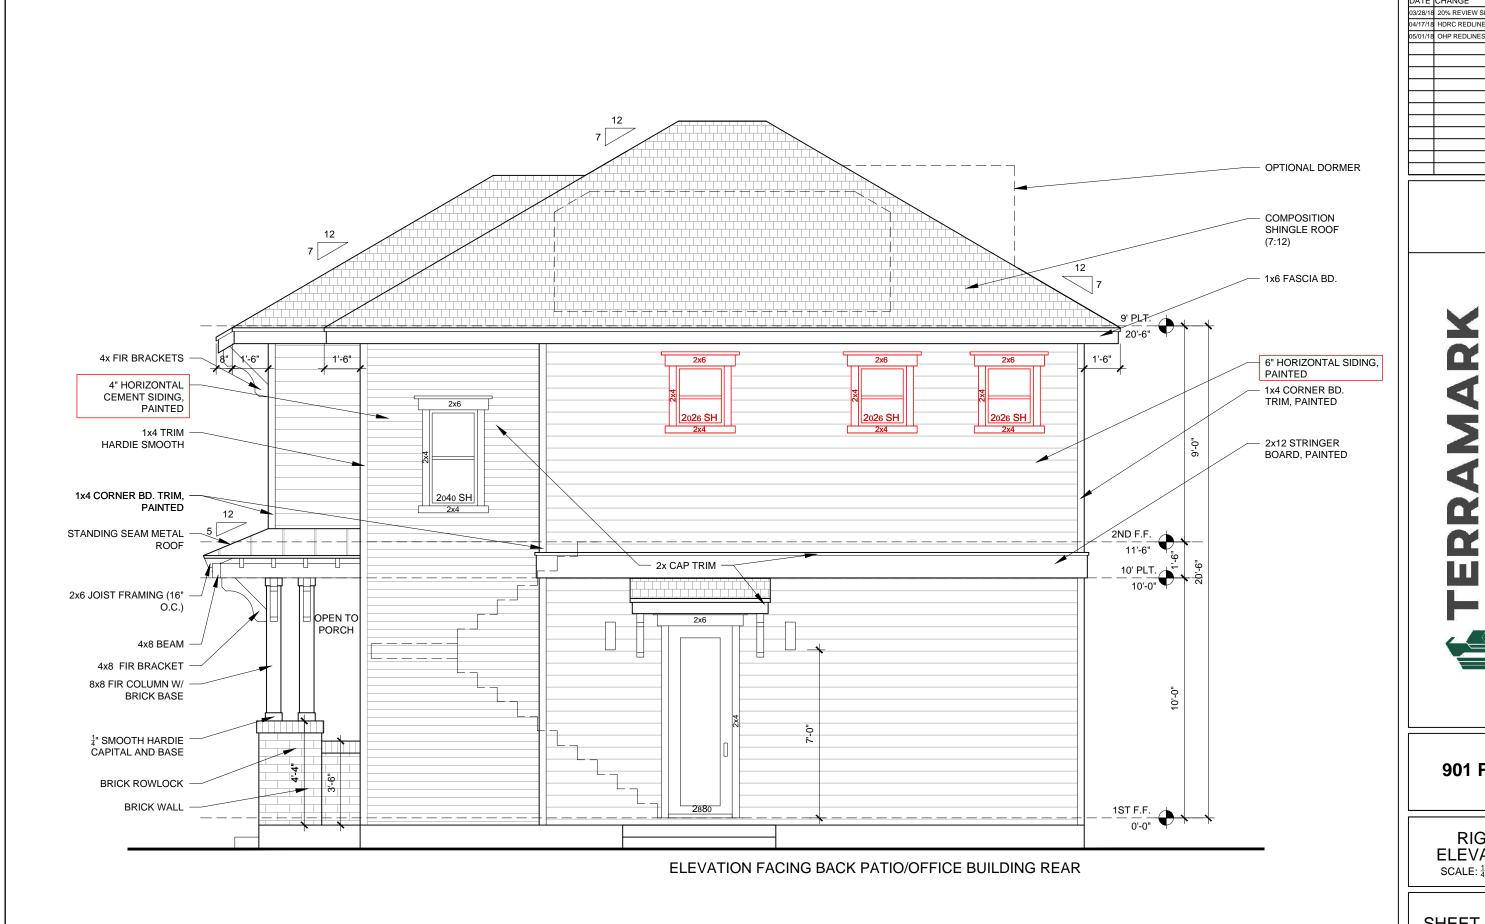


DATE	CHANGE	BY
03/28/18	20% REVIEW SET CREATED	LB
04/17/18	HDRC REDLINES	LB
05/01/18	OHP REDLINES	LB
		1




**901 PINE** 

RIGHT ELEVATION SCALE: <sup>1</sup>/<sub>4</sub>" = 1'-0"

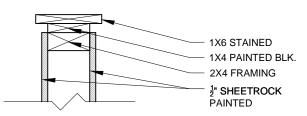


## D.1 CAP WALL DETAIL

SCALE:  $1-\frac{1}{2}$ " = 1'-0"

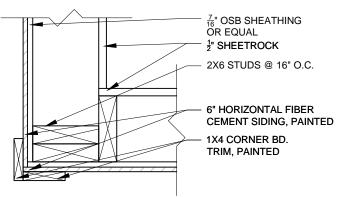


D.2 CORNER BD. TRIM

SCALE:  $1-\frac{1}{2}$ " = 1'-0"

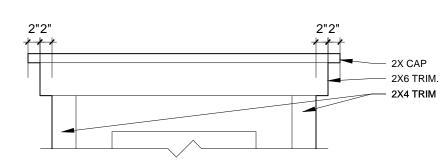


## **D.3 DOOR TRIM DETAIL**


SCALE:  $\frac{3}{4}$ " = 1'-0"

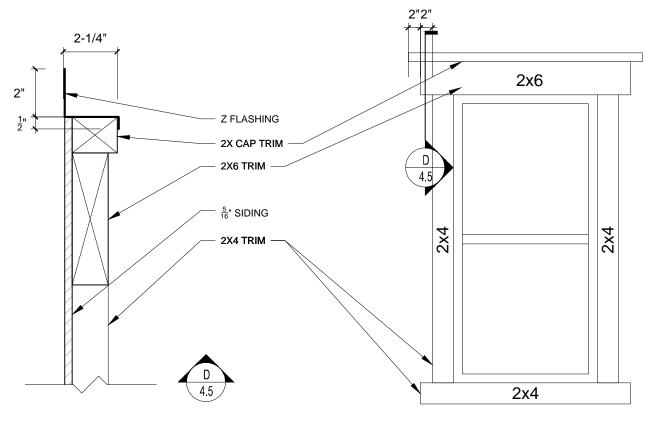

D.4.5 WINDOW TRIM DETAIL

SCALE: 3" = 1'-0"

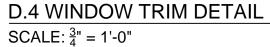

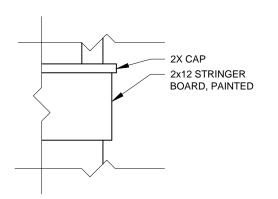

D.5 STRINGER BRD.

SCALE:  $\frac{3}{4}$ " = 1'-0"

20% REVIEW SET CREATED	LE
20% REVIEW SET PRINTED	LB
HDRC REDLINES	LB
20% REVIEW SET	LB
OHP REDLINES	LB
	_
	20% REVIEW SET PRINTED HDRC REDLINES 20% REVIEW SET

ALUMINUM WINDOW WITH MINIMUM OF

TWO INCHES IN DEPTH BETWEEN THE

FRONT FACE OF THE WINDOW TRIM

AND THE FRONT FACE OF THE TOP

**WINDOW SASH** 

DATE CHANGE



725 HAYS 729 HAYS 901 PINE

**DETAILS** 



## Historic and Design Review Commission Design Review Committee Report & Recommendation

DATE: MAY 8, 2018 HDRC Case#
ADDRESS: 735/729 NAYS, 901 NAINEMeeting Location: 1901 S ALAMO
APPLICANT: EKARAO TURRUBIATES/TERRAMARK
DRC Members present: MICHAEL GUARINO, JOHN LAFFOON, CURTIS FISH
Staff present: ENWARD HALL
Others present: ARMS HOLLAND (DHNA ARC)
REQUEST: CONSTRUCTION OF THREE, TWO STORY BESIDENTIAL
STEUCTORES
COMMENTS/CONCERNS: PT: UPLATE ON PROJECT ADJUSTMENTS.
MG! CHAR WOOR WINDOWS ARE MOST APPROPRIATE FOR NEW CONSTRUCTION.
CF: NON-WOOL OF ALUMINUM CLAD WINDOWS DON'T PROVIDE THE
PROFILE THAT IS APPROPRIATE, MG: SUBSTANTIAL CHANGE IN PLANE
ON 901 N PINE MAKES IT OVAY NOT TO INCLUDE A FULL WINTH
PORCH. MG: SHALLOW SLAE SETBACK IS APPROPRIATE FER EXISTING
CONTEXT. CF. SETBACUS OLAY, CF! 6+4 INCH EXPOSURE OVAY,
COMMITTEE RECOMMENDATION: APPROVE [ ] DISAPPROVE [ ] APPROVE WITH COMMENTS/STIPULATIONS:
March
Committee Chair Signature (or representative)  9/8/8  Date